#21921

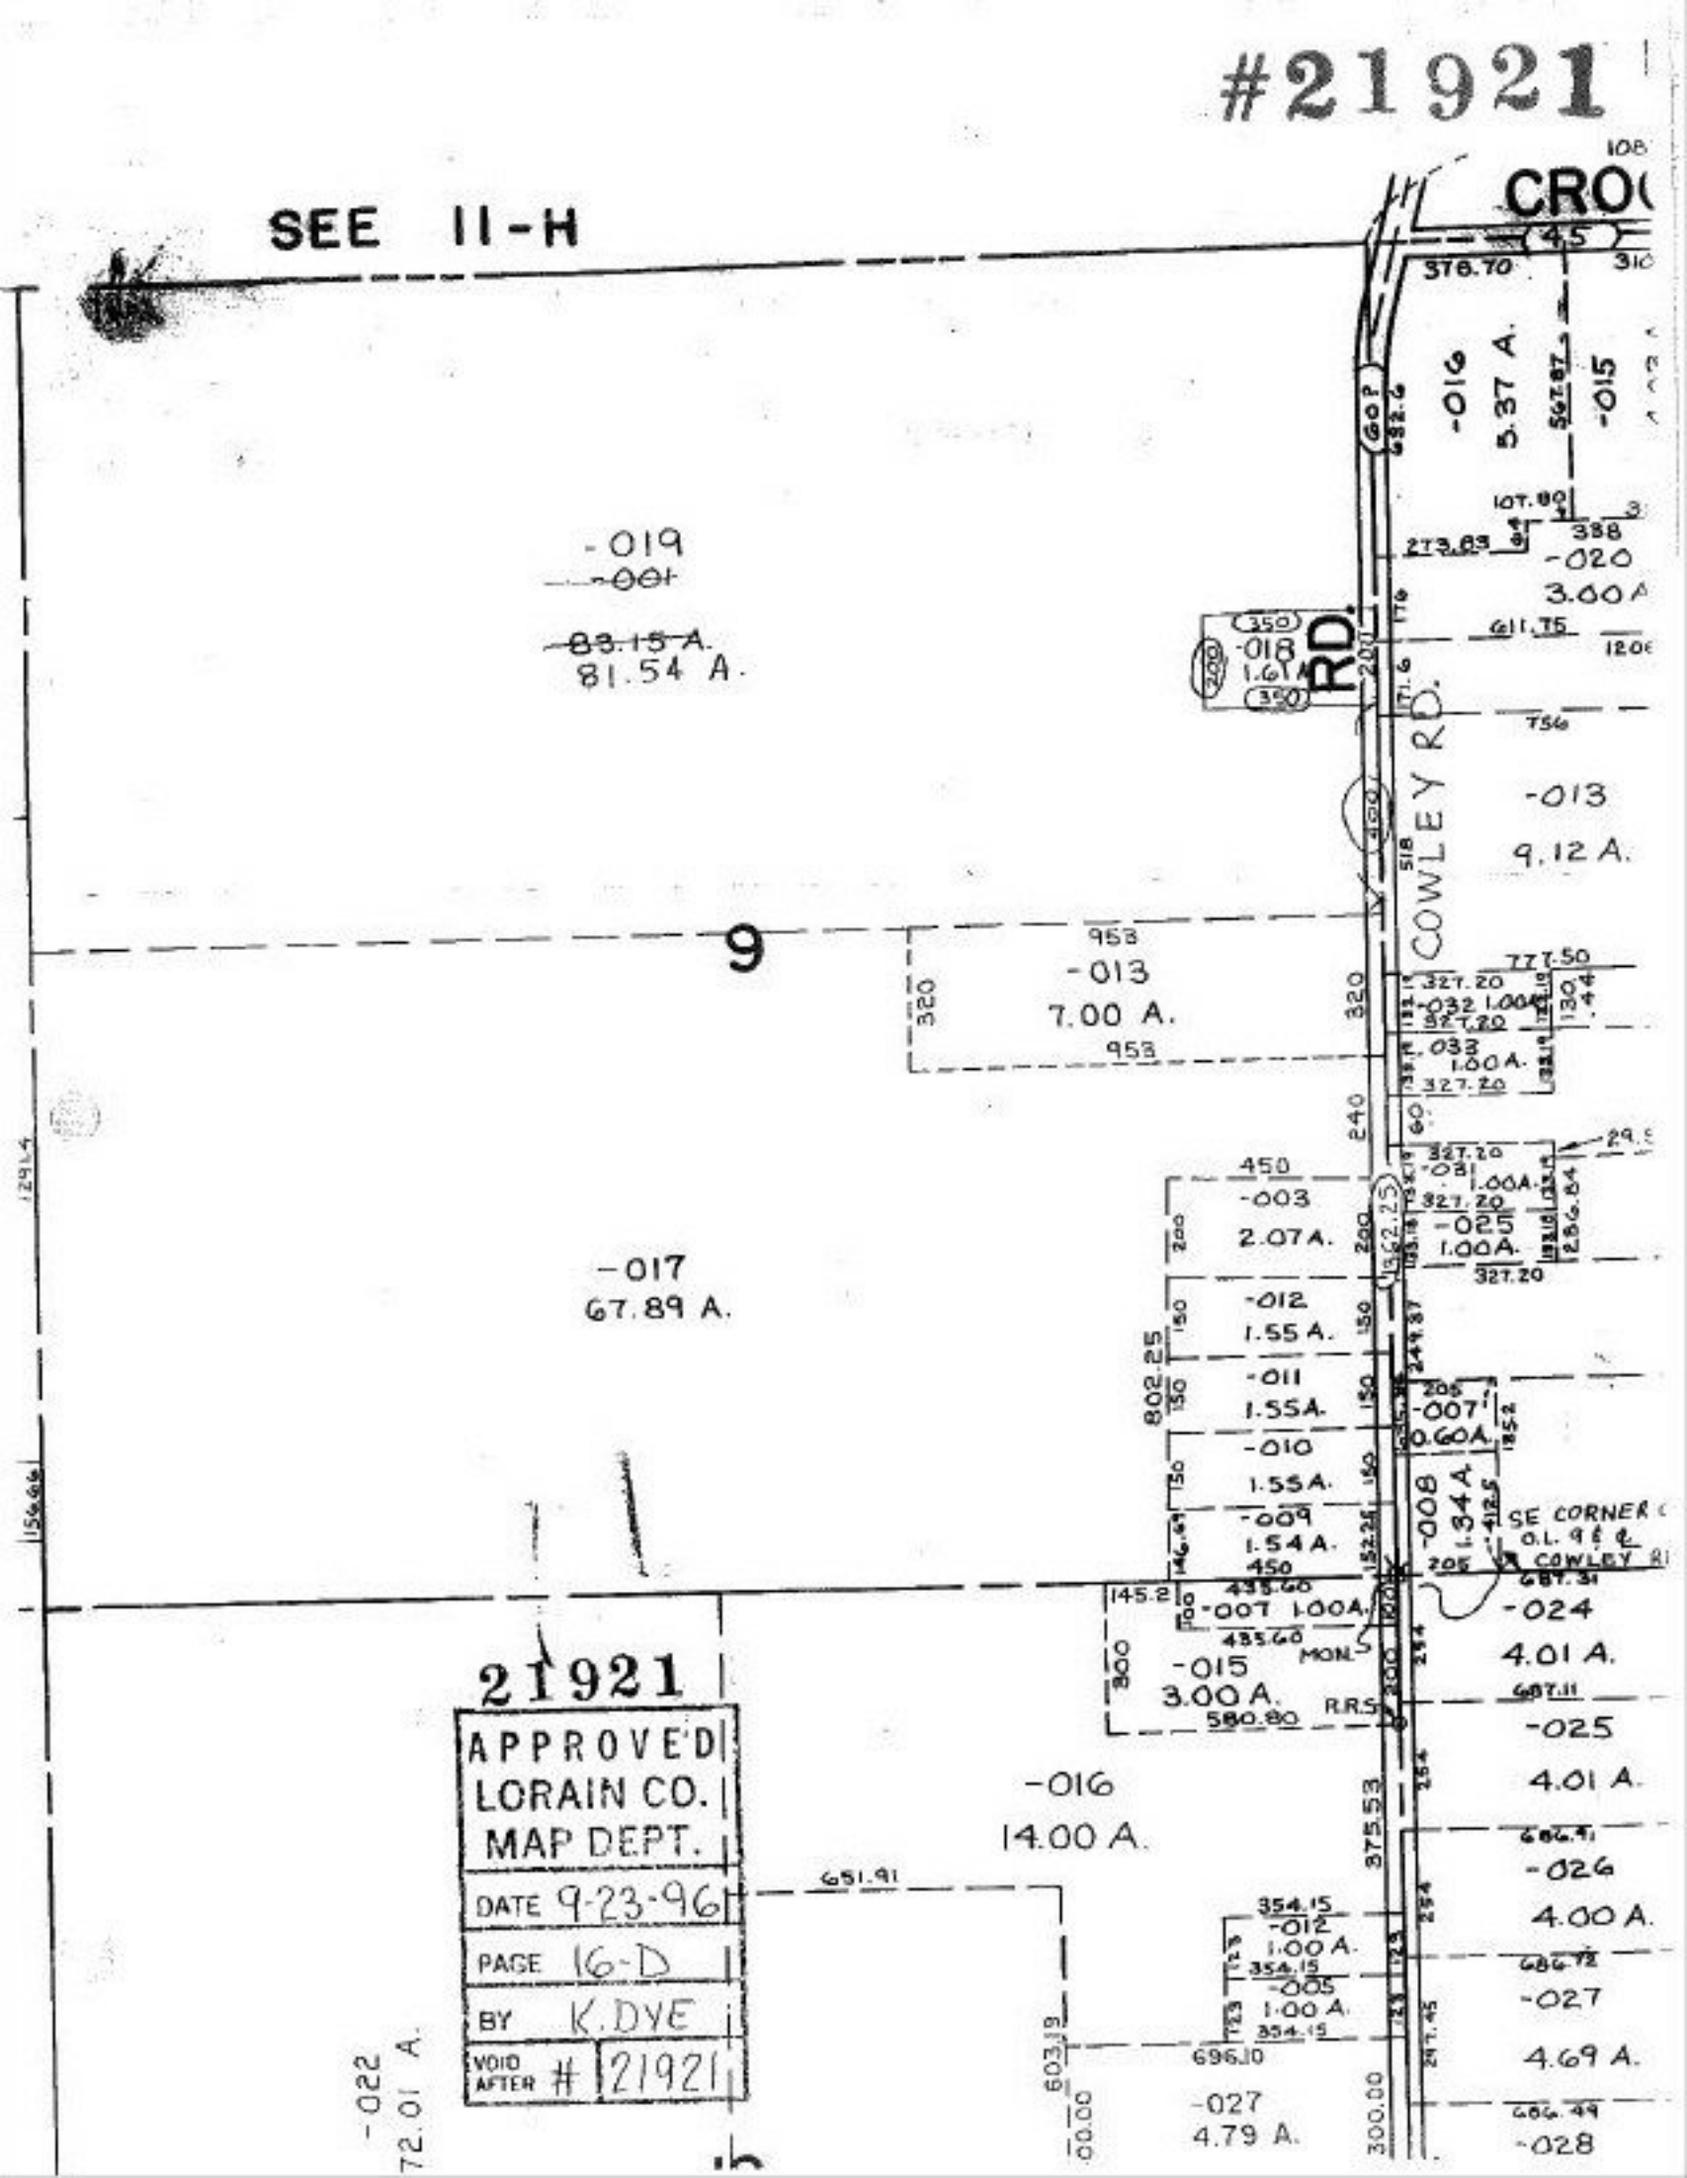

21921

APPROVED
LORAIN CO.
MAP DEPT.

DATE 9-23-96

PAGE 16-D

BY K.DYE

VOID AFTER # 21921