Pg. 3-00-035

# #21923
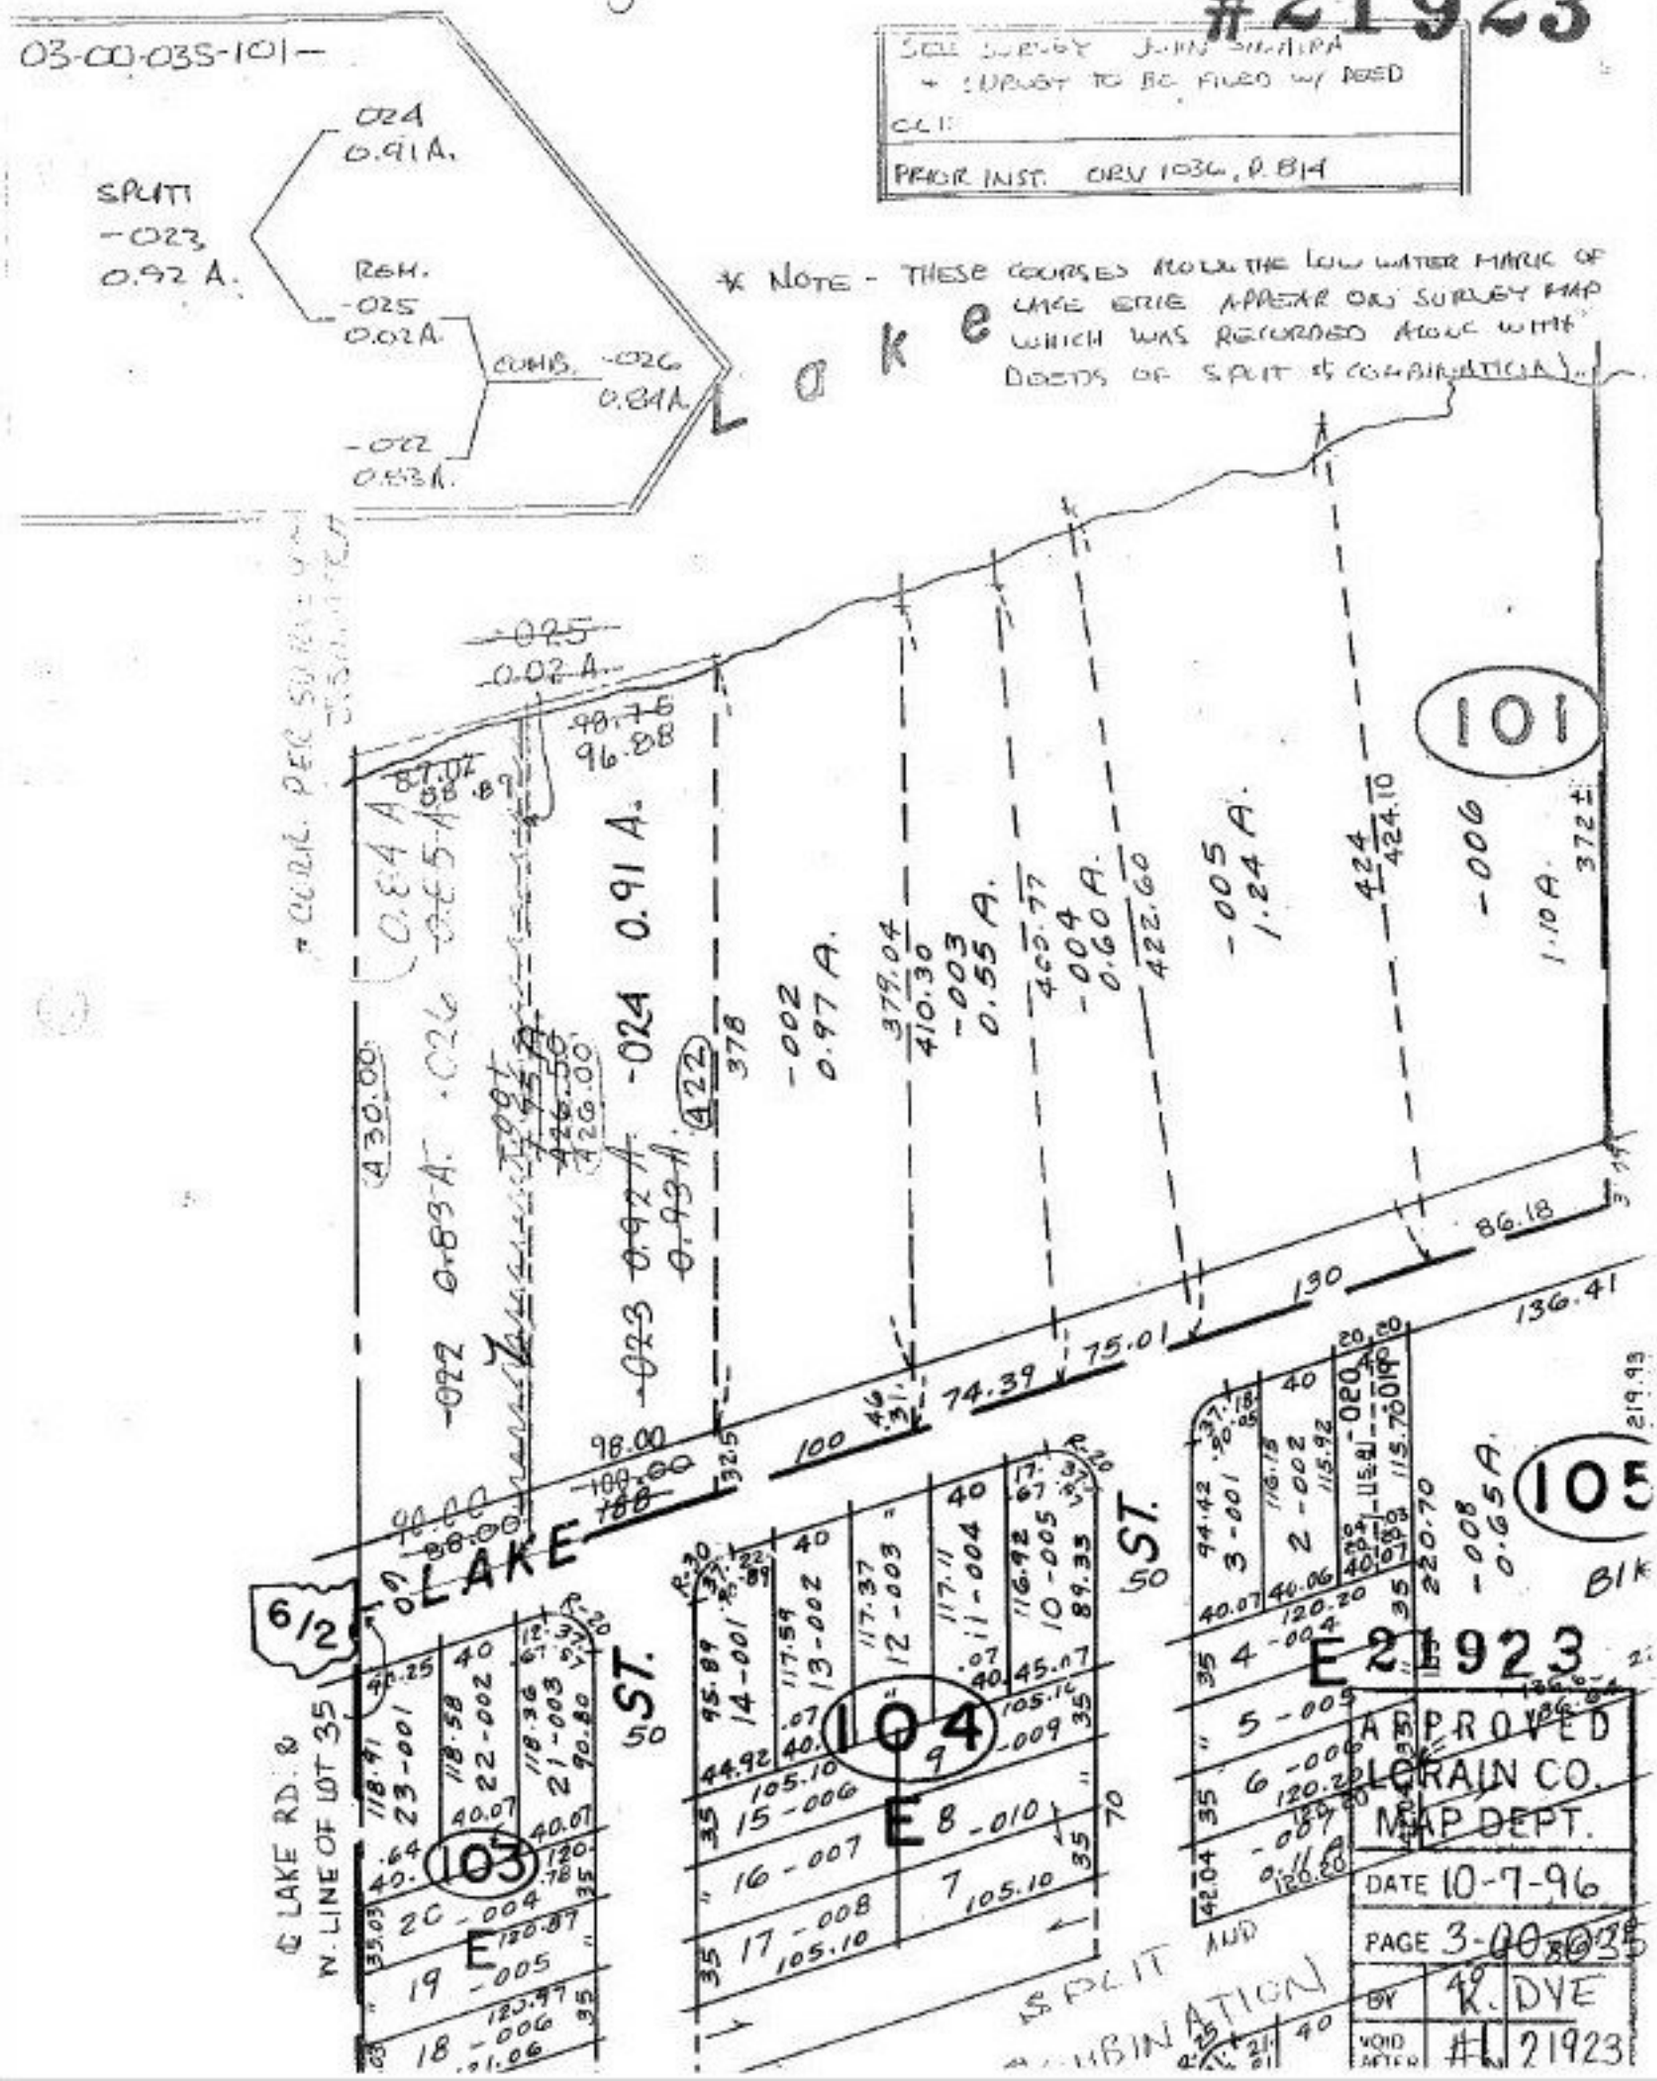
SEE SURVEY JOHN SIGAIRA
+ SURVEY TO BE FILED W/ DEED
CLI:
PRIOR INST. ORV 1036, P. 814