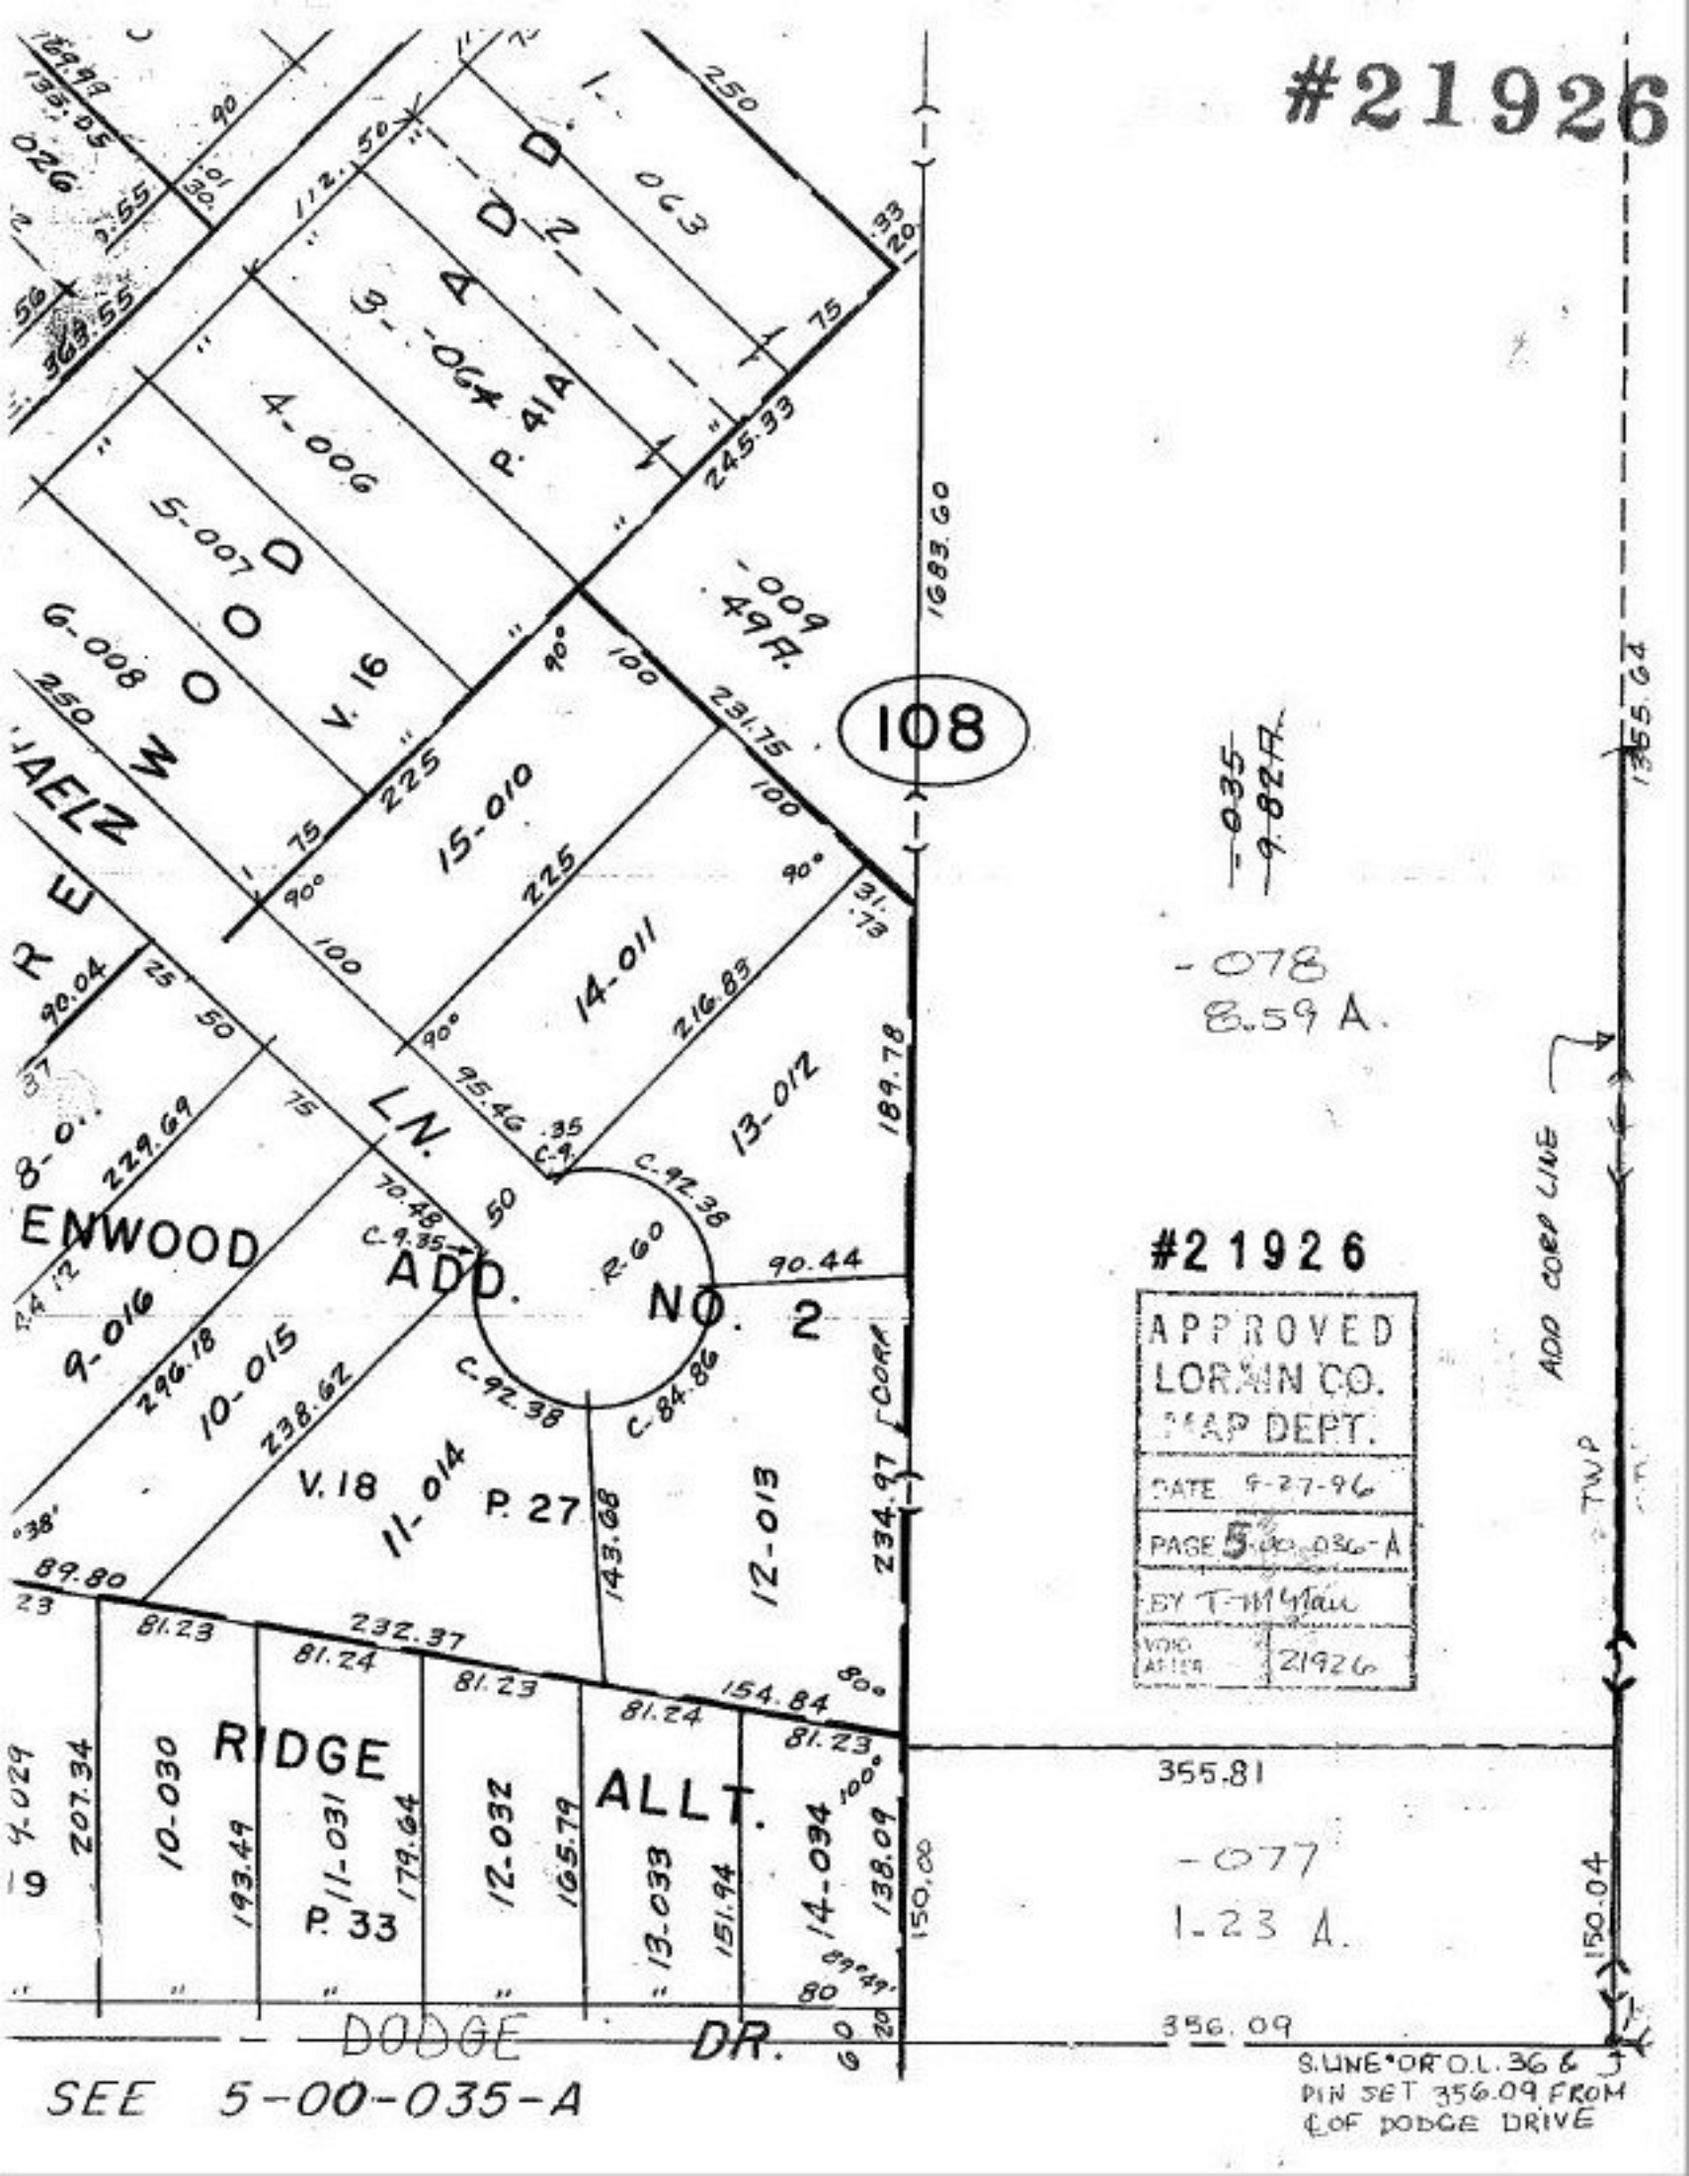
#21926
108
ADD. 2
3-064
P. 41A
4-006
5-007
6-008
V. 16
WOOD
-009
49A.
15-010
14-011
13-012
LN.
ENWOOD
ADD. NO. 2
9-016
10-015
11-014
V. 18
P. 27
12-013
R-60
C-92.38
C-84.86
C-9.35
-035
9.82A.
-078
8.59 A.
#21926
APPROVED
LORAIN CO.
MAP DEPT.
DATE 9-27-96
PAGE 5-00-036-A
BY T-M Yau
VOID AFTER 21926
ADD CORP LINE
TWP
RIDGE
ALLT.
10-030
11-031
P. 33
12-032
13-033
14-034
355.81
-077
1.23 A.
356.09
DODGE
DR.
SEE 5-00-035-A
S. LINE OF O.L. 36 & PIN SET 356.09 FROM ℄ OF DODGE DRIVE