#21927

PRIOR INSTRUMENT OR 935-27
CLOSURE 0.00 PER 10,000
SURVEYED BY EARL H. HUNTER

~~Pt. 052~~
~~Pt. 31.06 A.~~ Pt. 054 Pt. 30.04 A.

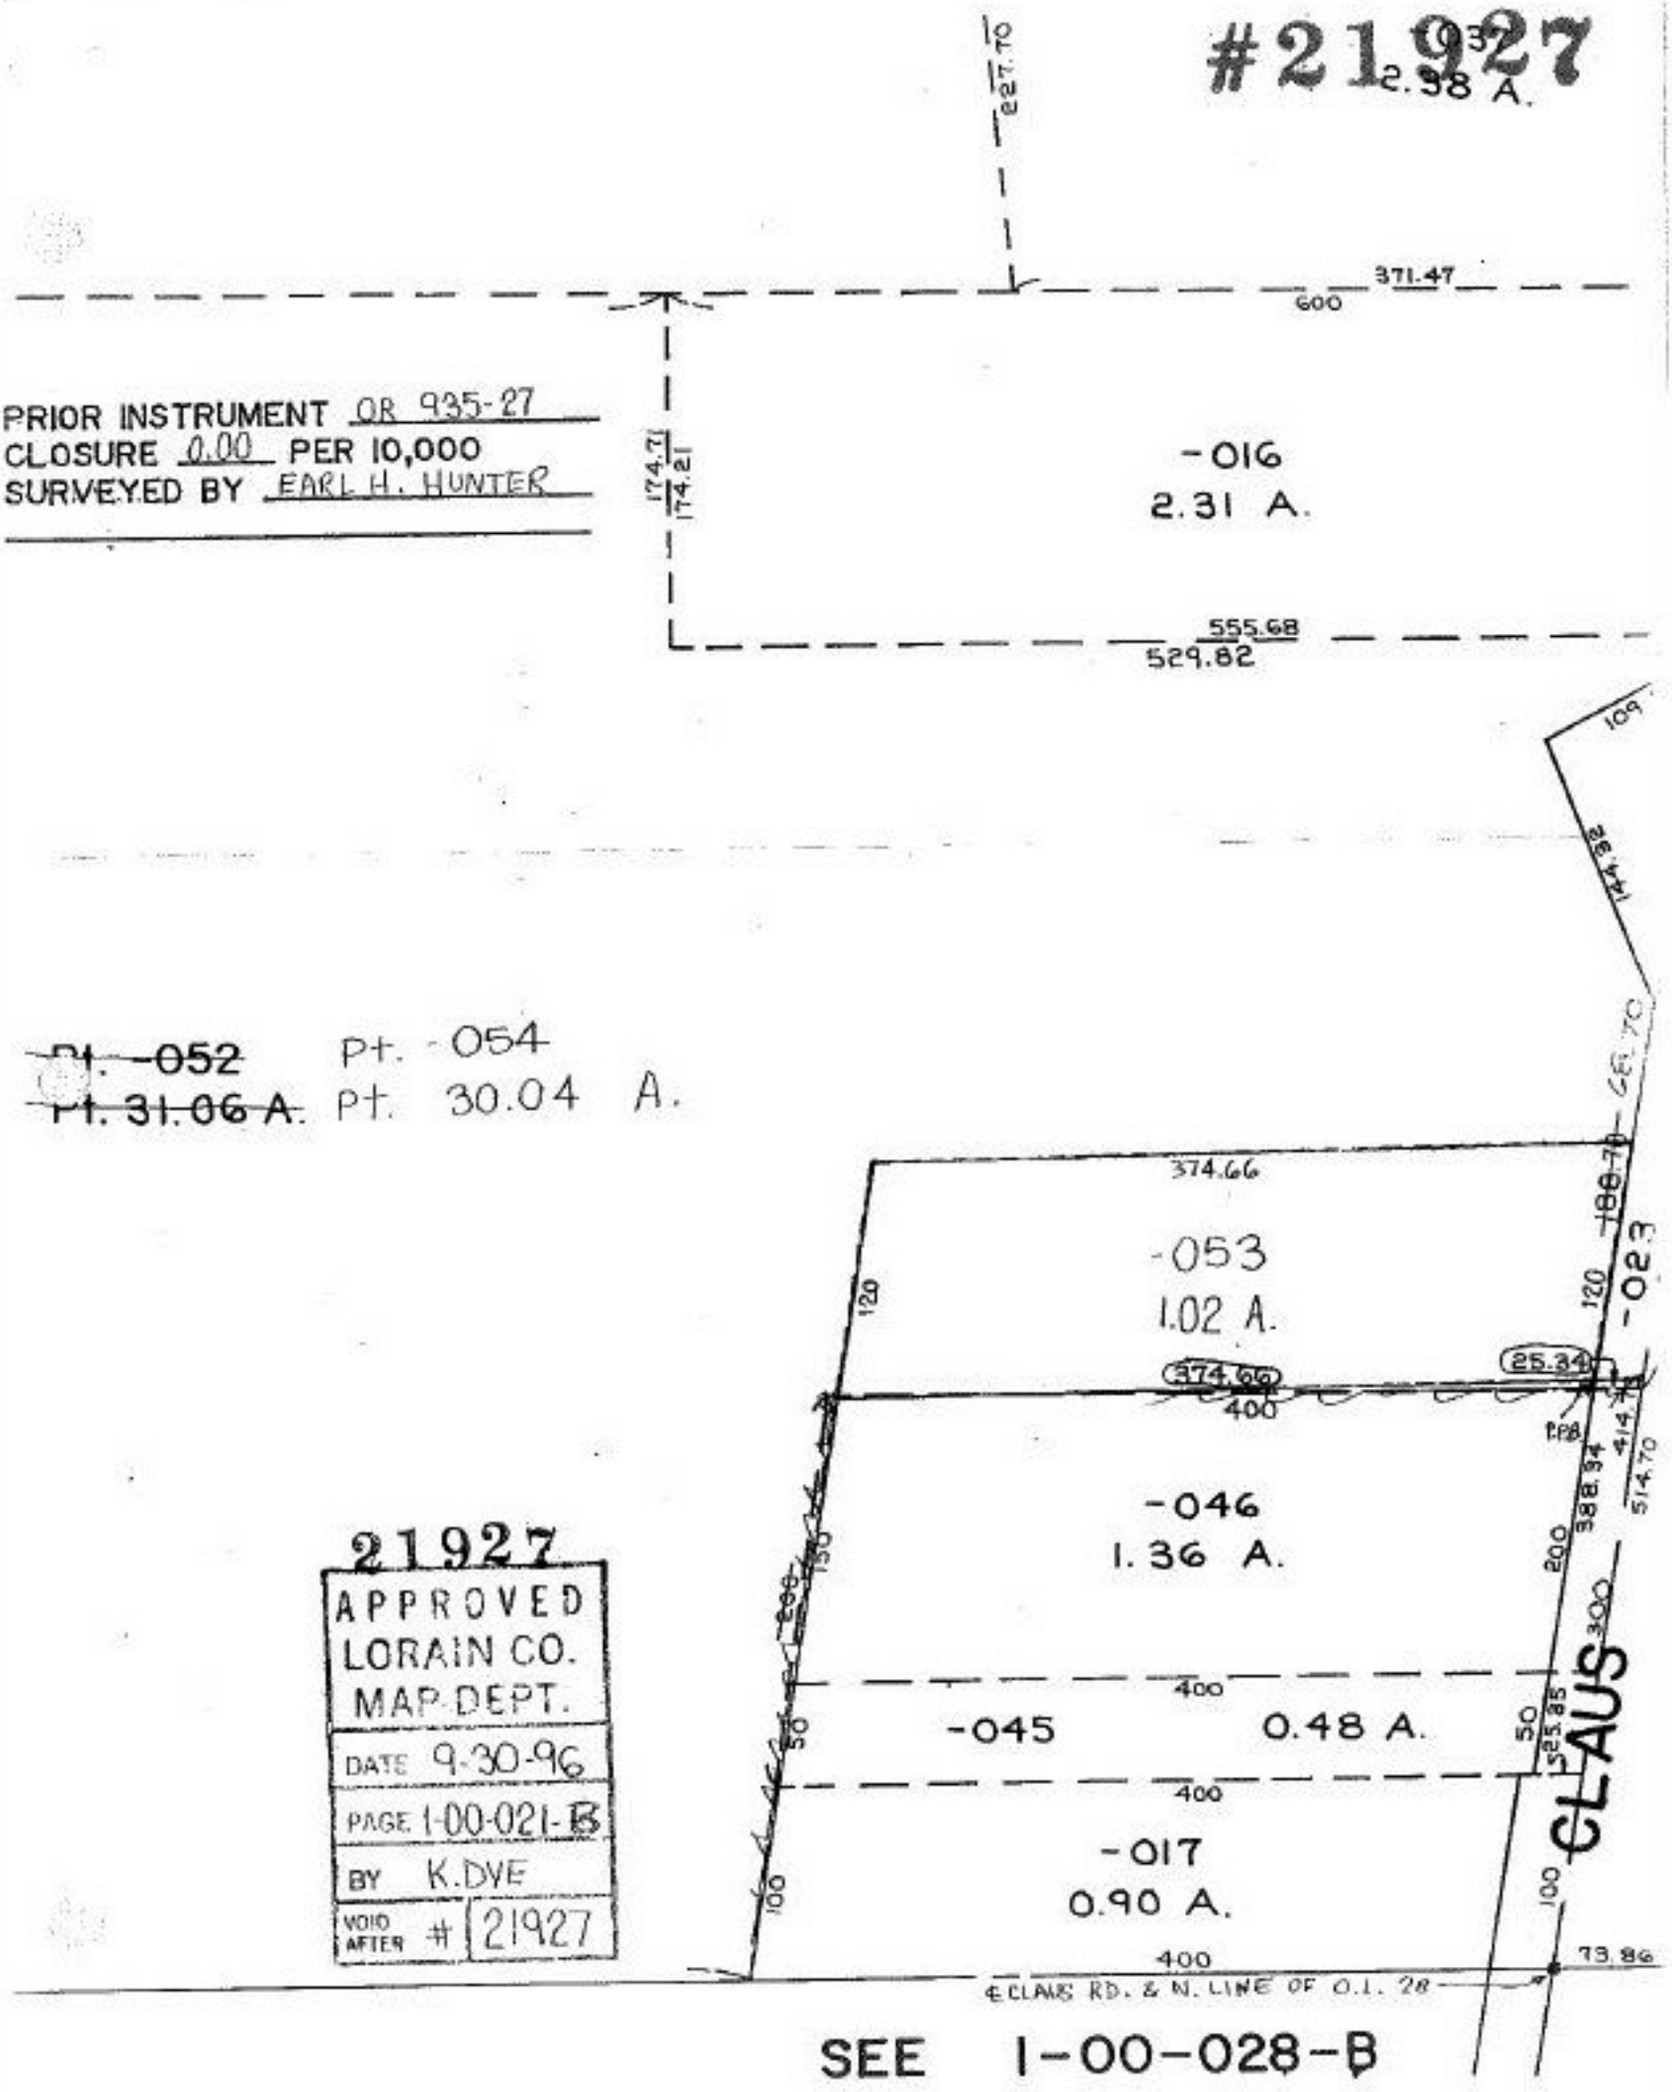

21927
APPROVED
LORAIN CO.
MAP DEPT.
DATE 9-30-96
PAGE 1-00-021-B
BY K.DYE
VOID AFTER # 21927

SEE 1-00-028-B