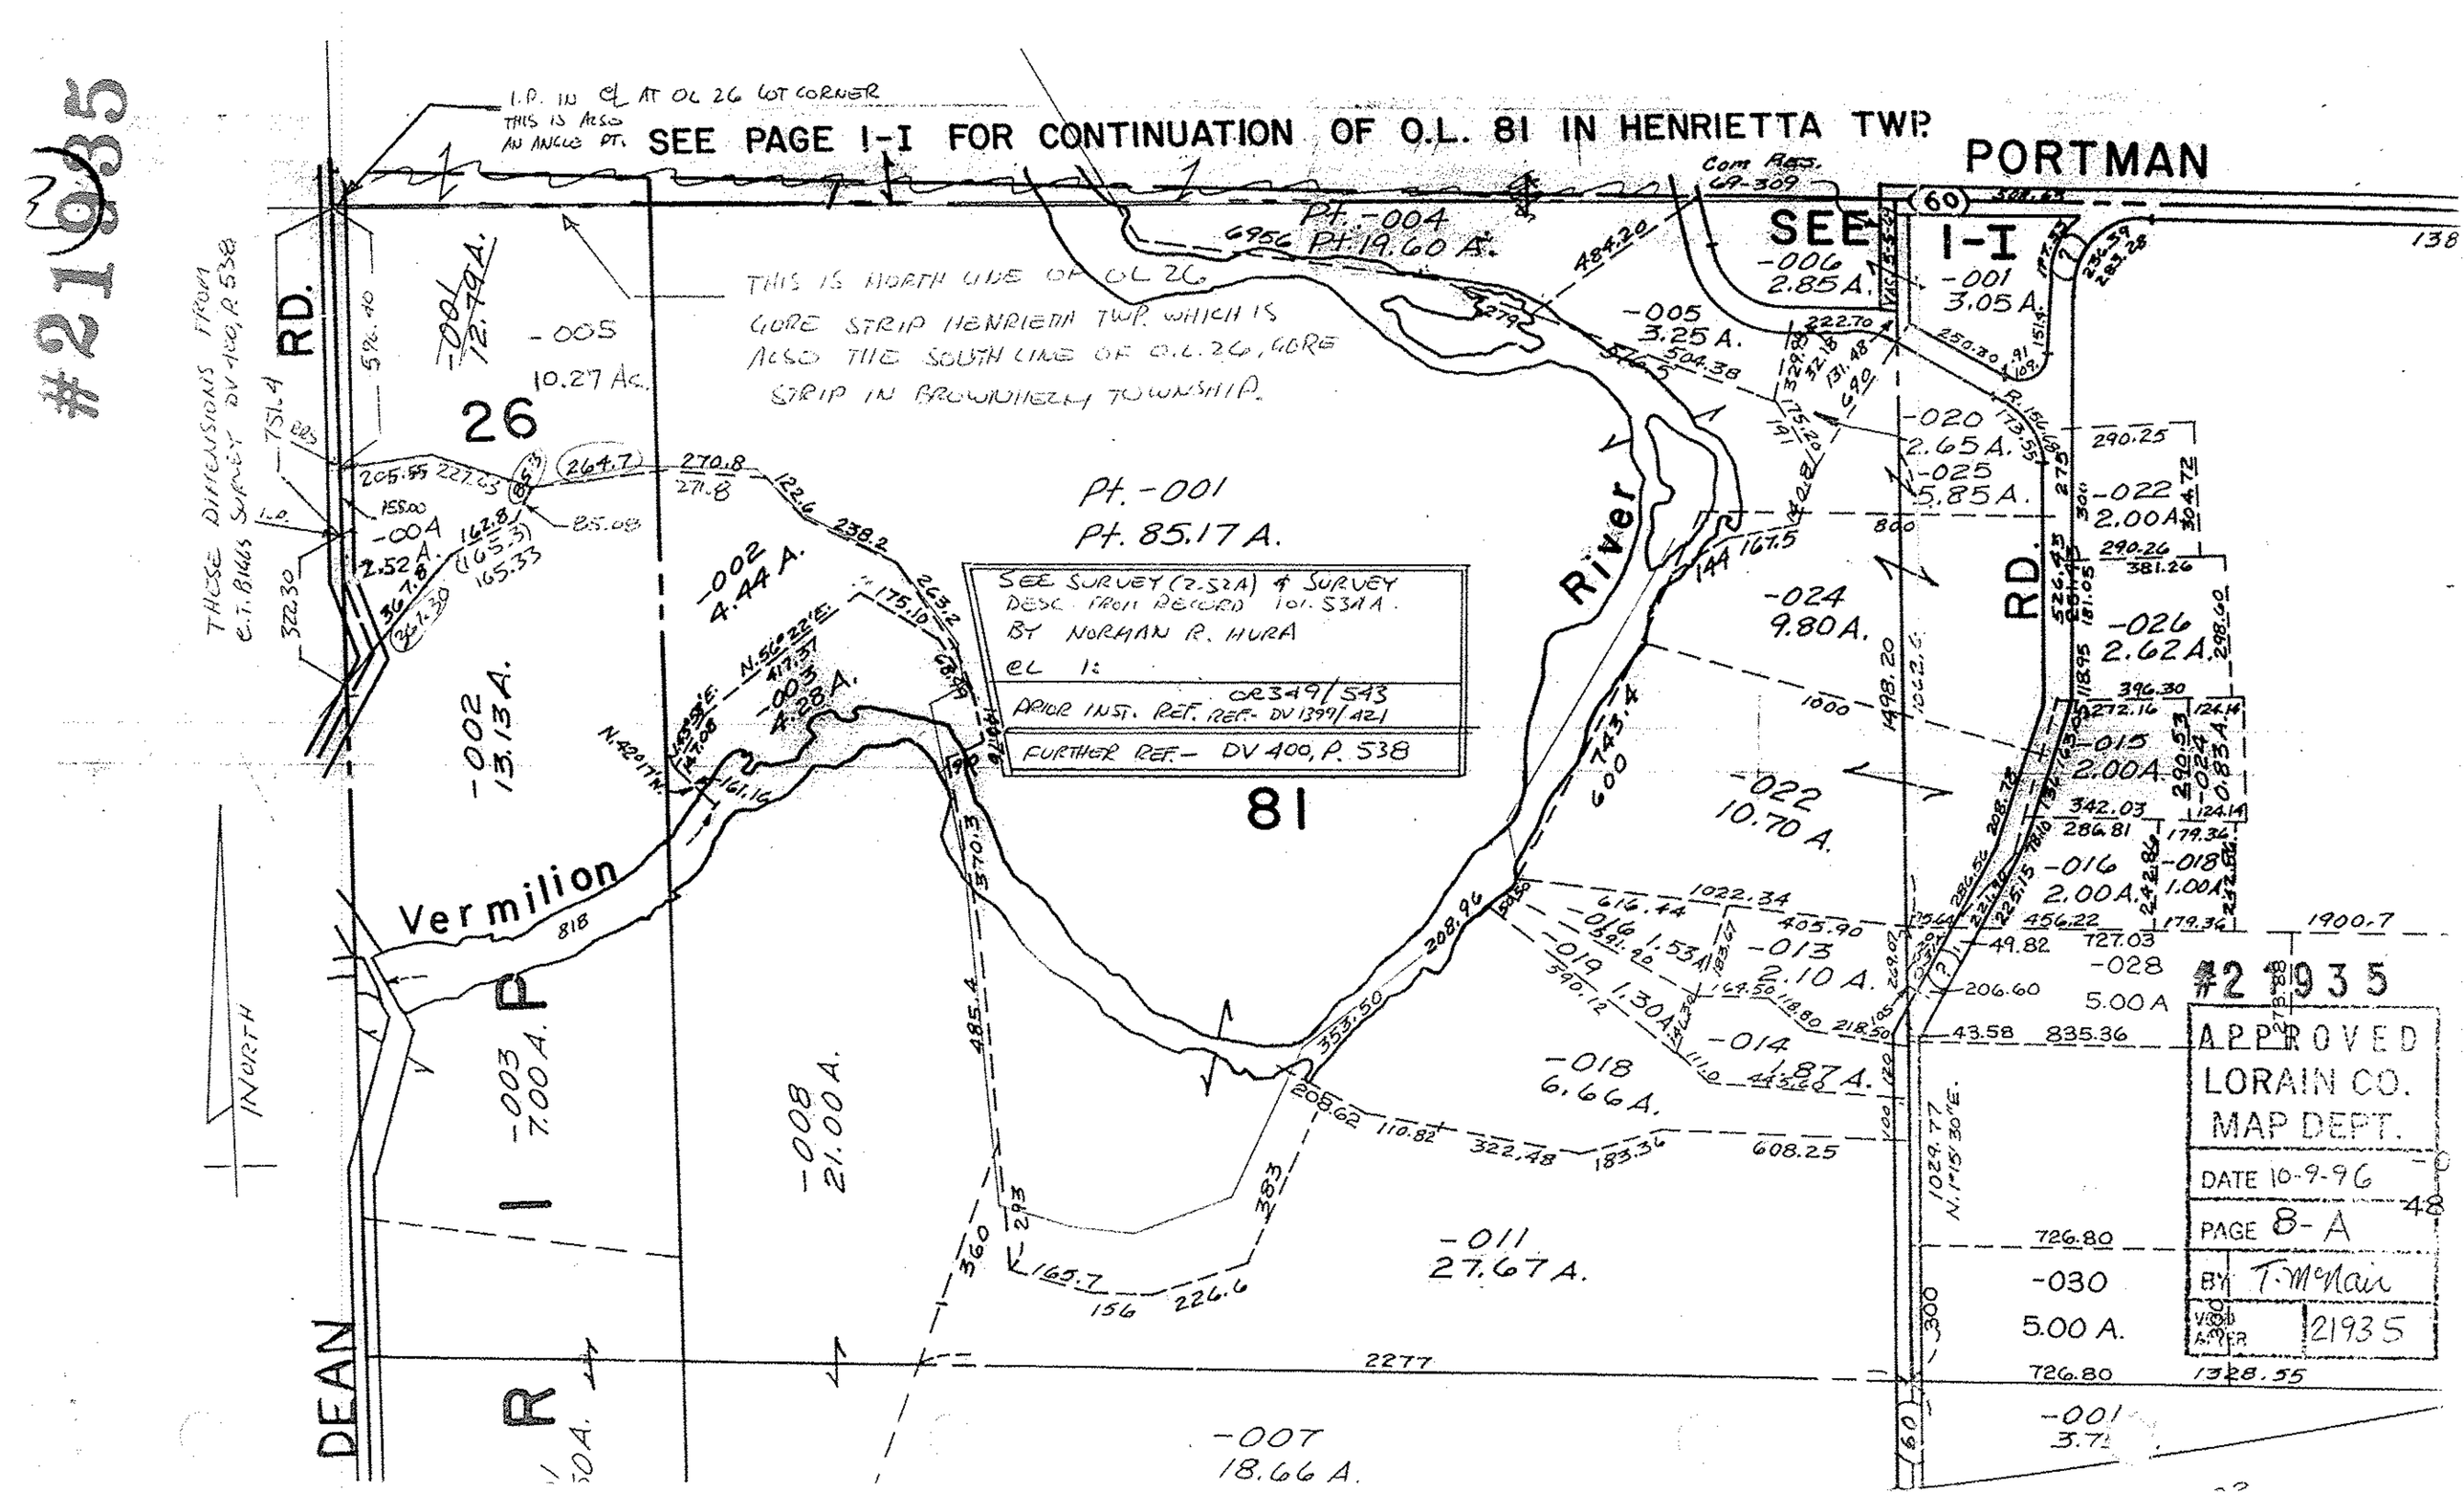

#21935
I.P. IN ℄ AT OL 26 LOT CORNER THIS IS ALSO AN ANGLE PT.
SEE PAGE 1-I FOR CONTINUATION OF O.L. 81 IN HENRIETTA TWP.
PORTMAN
SEE 1-I
THIS IS NORTH LINE OF OL 26 GORE STRIP HENRIETTA TWP. WHICH IS ALSO THE SOUTH LINE OF O.L. 26, GORE STRIP IN BROWNHELM TOWNSHIP.
THESE DIMENSIONS FROM C.T. BIGGS SURVEY DV 400, P. 538
RD.
26
81
Vermilion
River
DEAN
NORTH
Pt. -004 Pt. 19.60 A.
Pt. -001 Pt. 85.17 A.
SEE SURVEY (2.52A) & SURVEY DESC. FROM RECORD 101.534A. BY NORMAN R. HURA
CL 1:
PRIOR INST. REF. REF. DV 1399/421 OR349/543
FURTHER REF. - DV 400, P. 538
-005 10.27 Ac.
-001 12.79 A.
-004 2.52 A.
-002 13.13 A.
-002 4.44 A.
-003 4.28 A.
-003 7.00 A.
-008 21.00 A.
-007 18.66 A.
-011 27.67 A.
-018 6.66 A.
-014 1.87 A.
-019 1.30 A.
-016 1.53 A.
-013 2.10 A.
-022 10.70 A.
-024 9.80 A.
-005 3.25 A.
-006 2.85 A.
-001 3.05 A.
-020 2.65 A.
-025 5.85 A.
-022 2.00 A.
-026 2.62 A.
-015 2.00 A.
-024 0.83 A.
-016 2.00 A.
-018 1.00 A.
-028 5.00 A.
-030 5.00 A.
-001 3.7
#21935
APPROVED LORAIN CO. MAP DEPT.
DATE 10-9-96
PAGE 8-A
BY T. McNair
VOID AFTER 21935