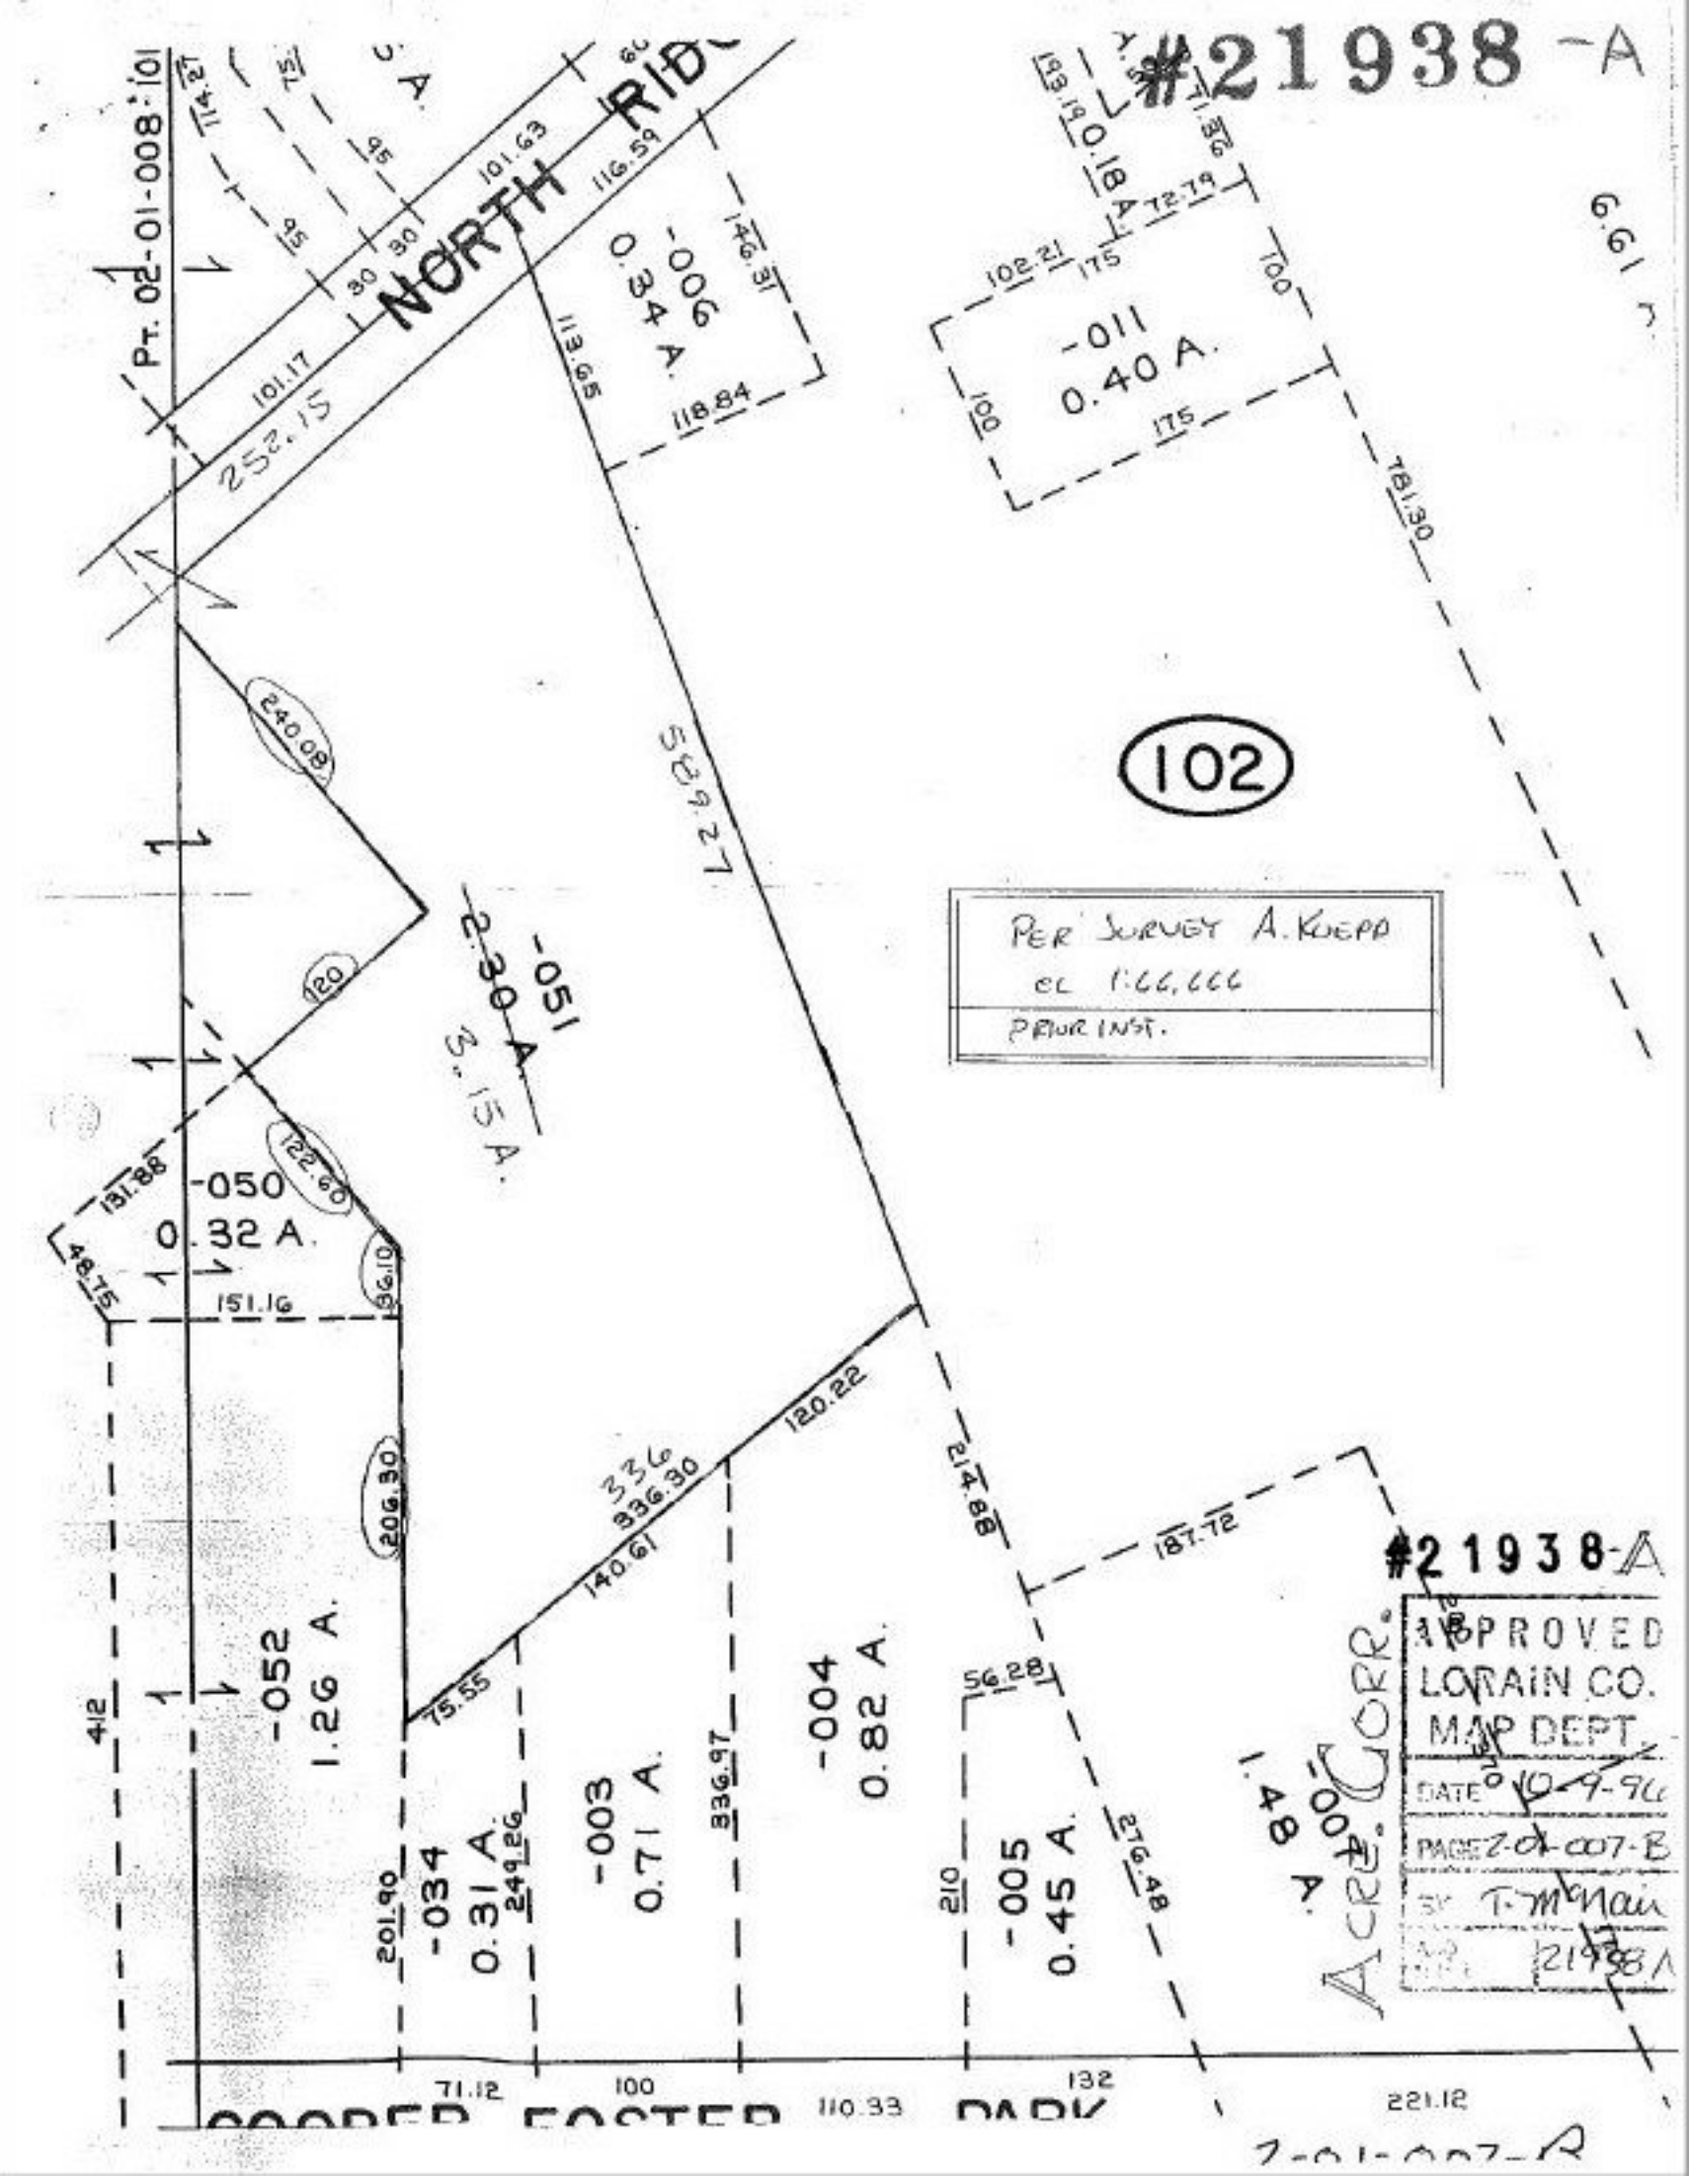
#21938-A
NORTH RID
Pt. 02-01-008:101
-006
0.34 A.
-011
0.40 A.
102
PER SURVEY A. KOEPP
@ 1:66,666
PRIOR INST.
-050
0.32 A.
-051
2.30 A.
-052
1.26 A.
-034
0.31 A.
-003
0.71 A.
-004
0.82 A.
-005
0.45 A.
-004
1.48 A.
ACCUCORP.
#21938-A
APPROVED
LORAIN CO.
MAP DEPT.
DATE 10-9-96
PAGE 7-01-007-B
BY T. McNair
NO. 21938A
7-01-007-B