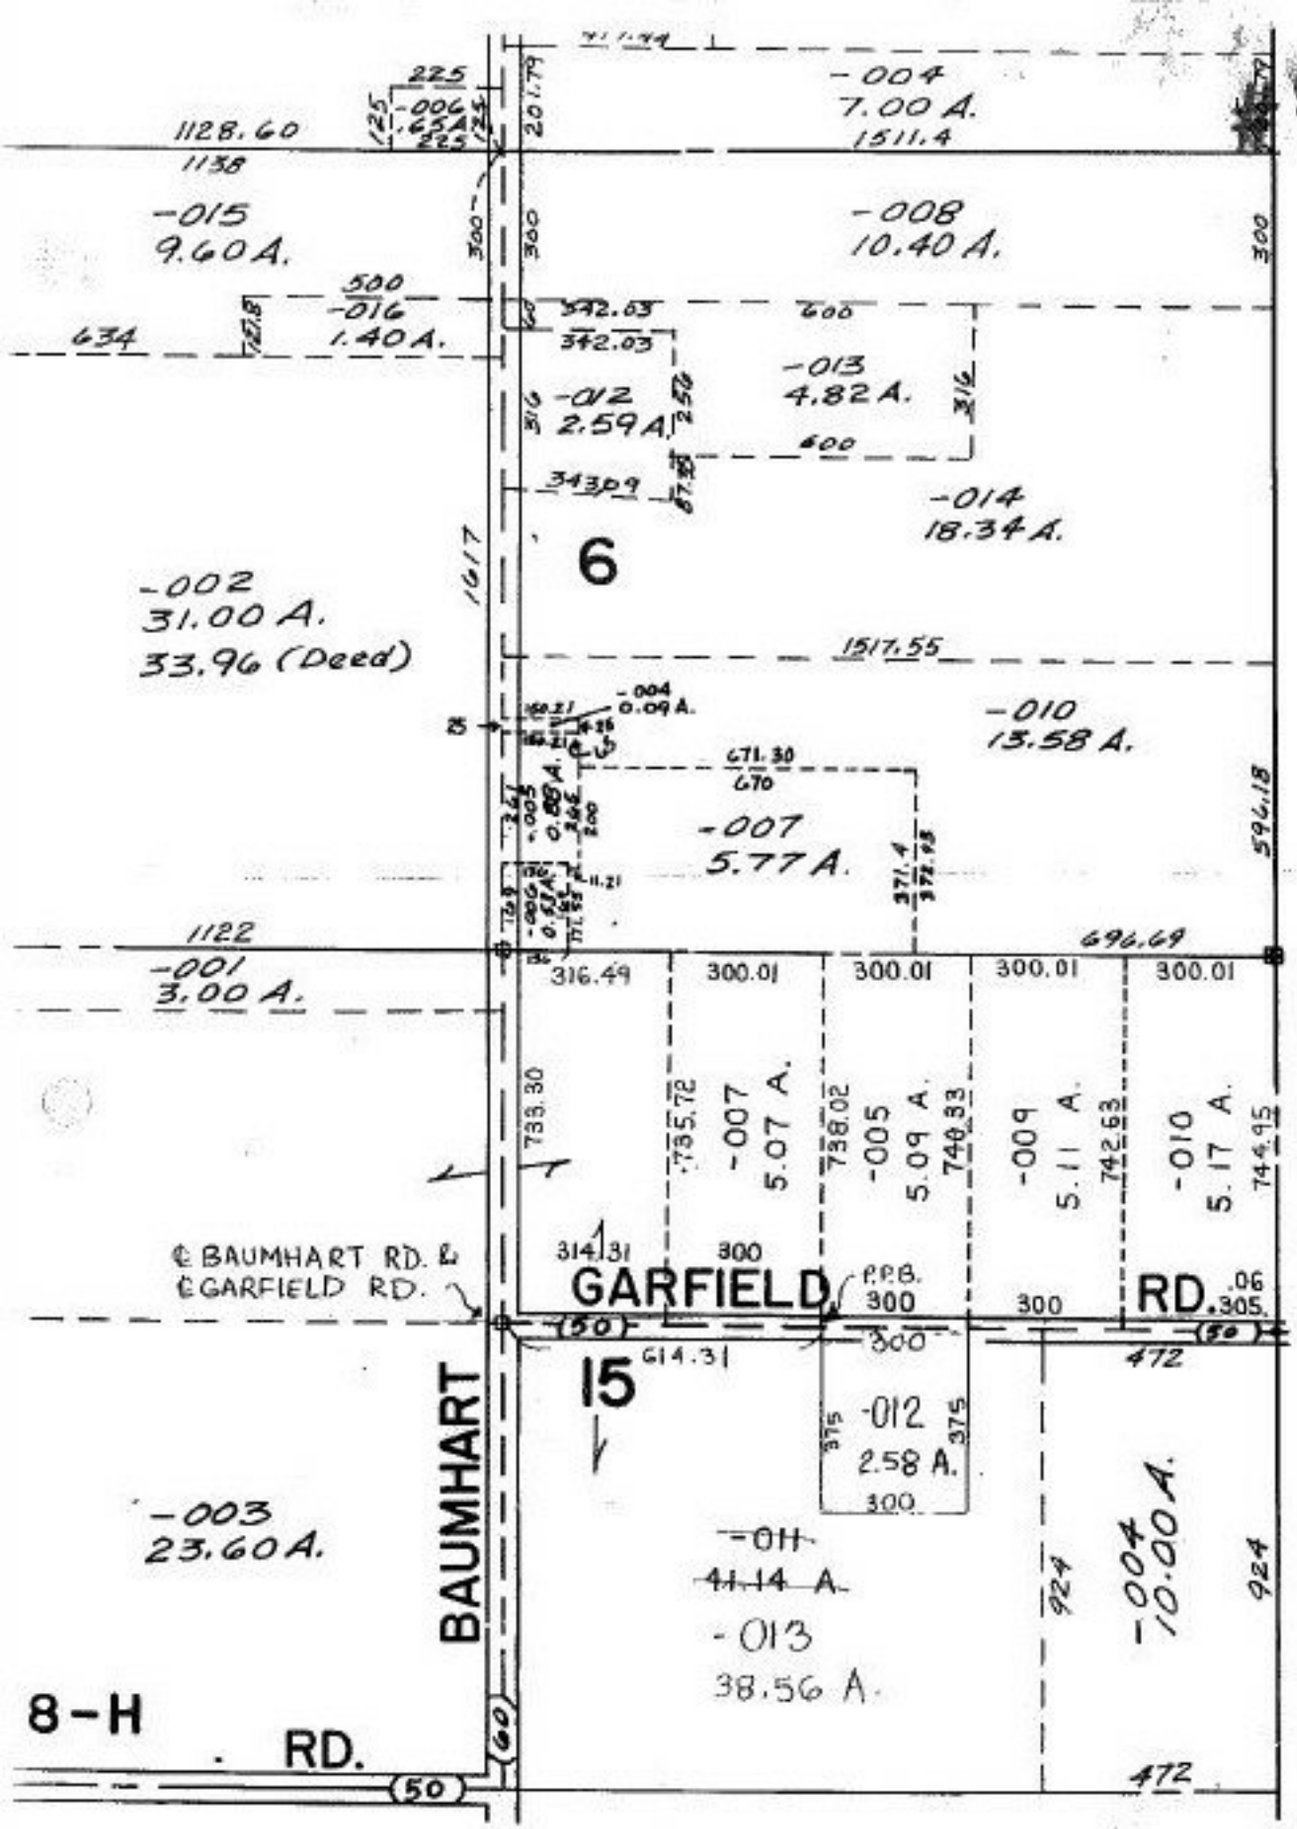

21938

APPROVED
LORAIN CO.
MAP DEPT.

DATE 10-7-96

PAGE 8-D

BY K. DYE

VOID AFTER # 21938