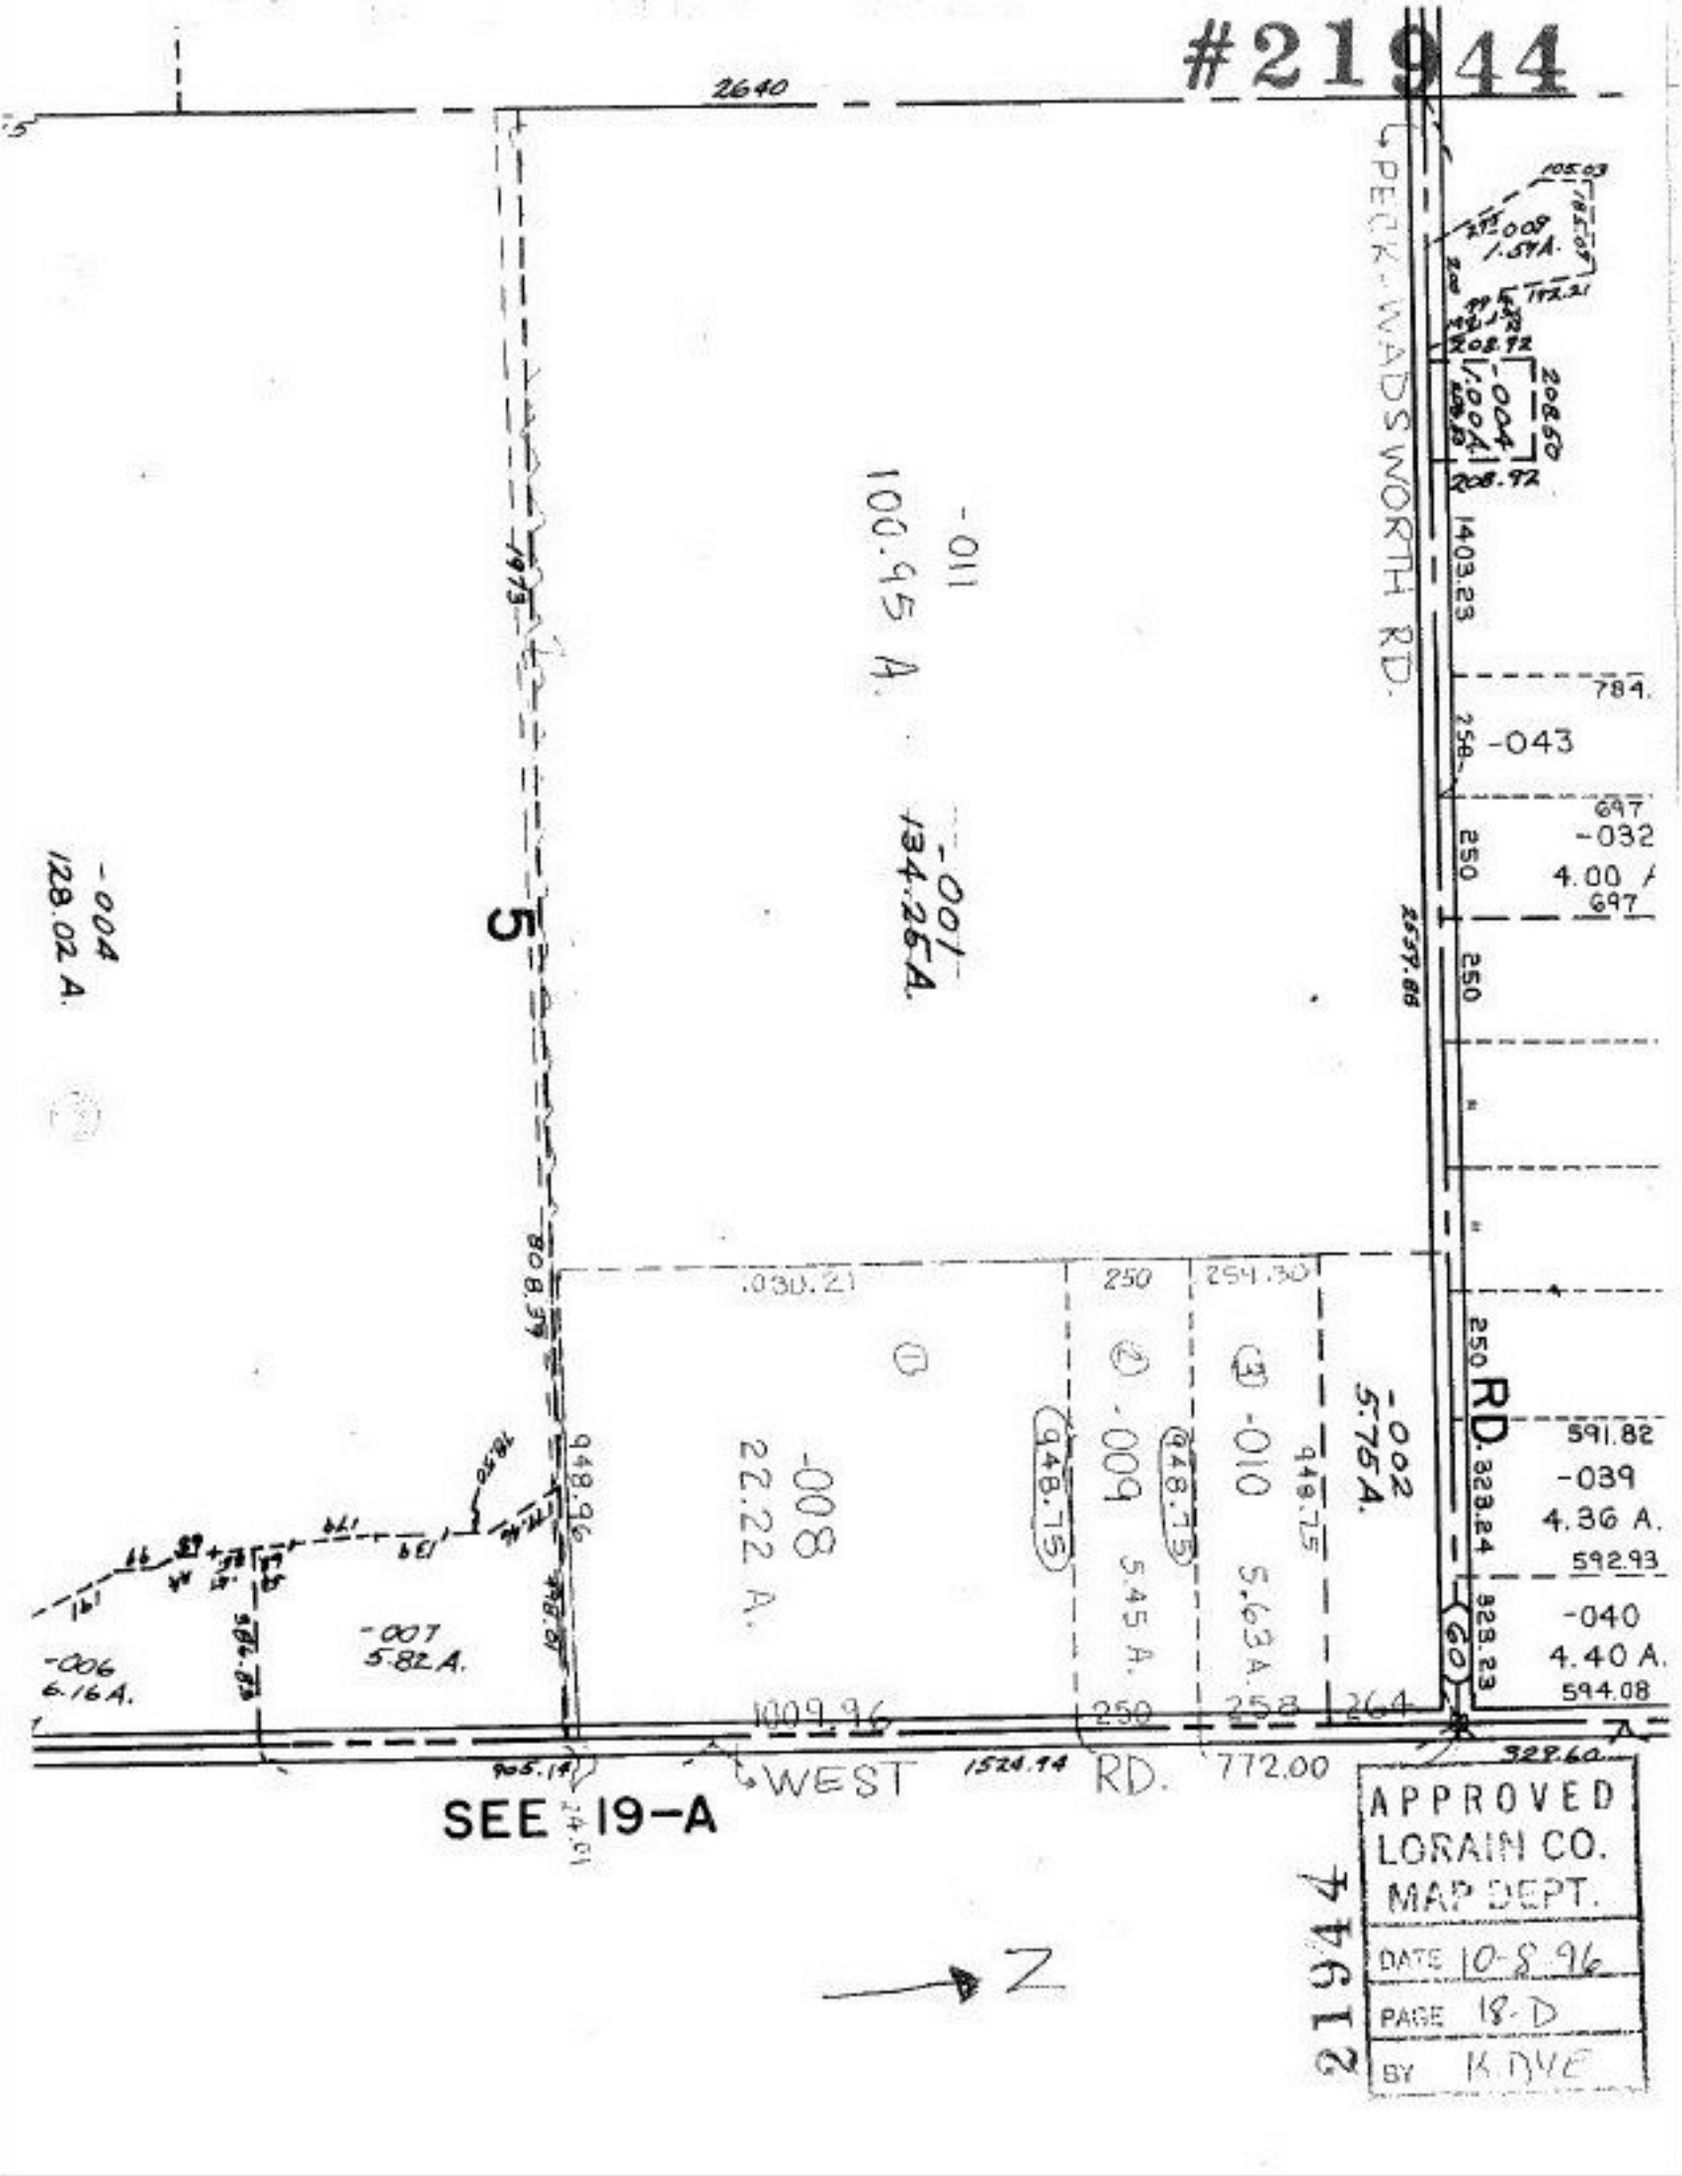
#21944
2640
PECK-WADSWORTH RD.
-011
100.95 A.
-001
134.25 A.
-004
128.02 A.
5
-043
-032
4.00 A.
-039
4.36 A.
-040
4.40 A.
-002
5.75 A.
-010
5.63 A.
-009
5.45 A.
-008
22.22 A.
-007
5.82 A.
-006
6.16 A.
RD.
WEST
RD.
772.00
SEE 19-A
N
APPROVED
LORAIN CO.
MAP DEPT.
DATE 10-8-96
PAGE 18-D
BY K DYE
21944