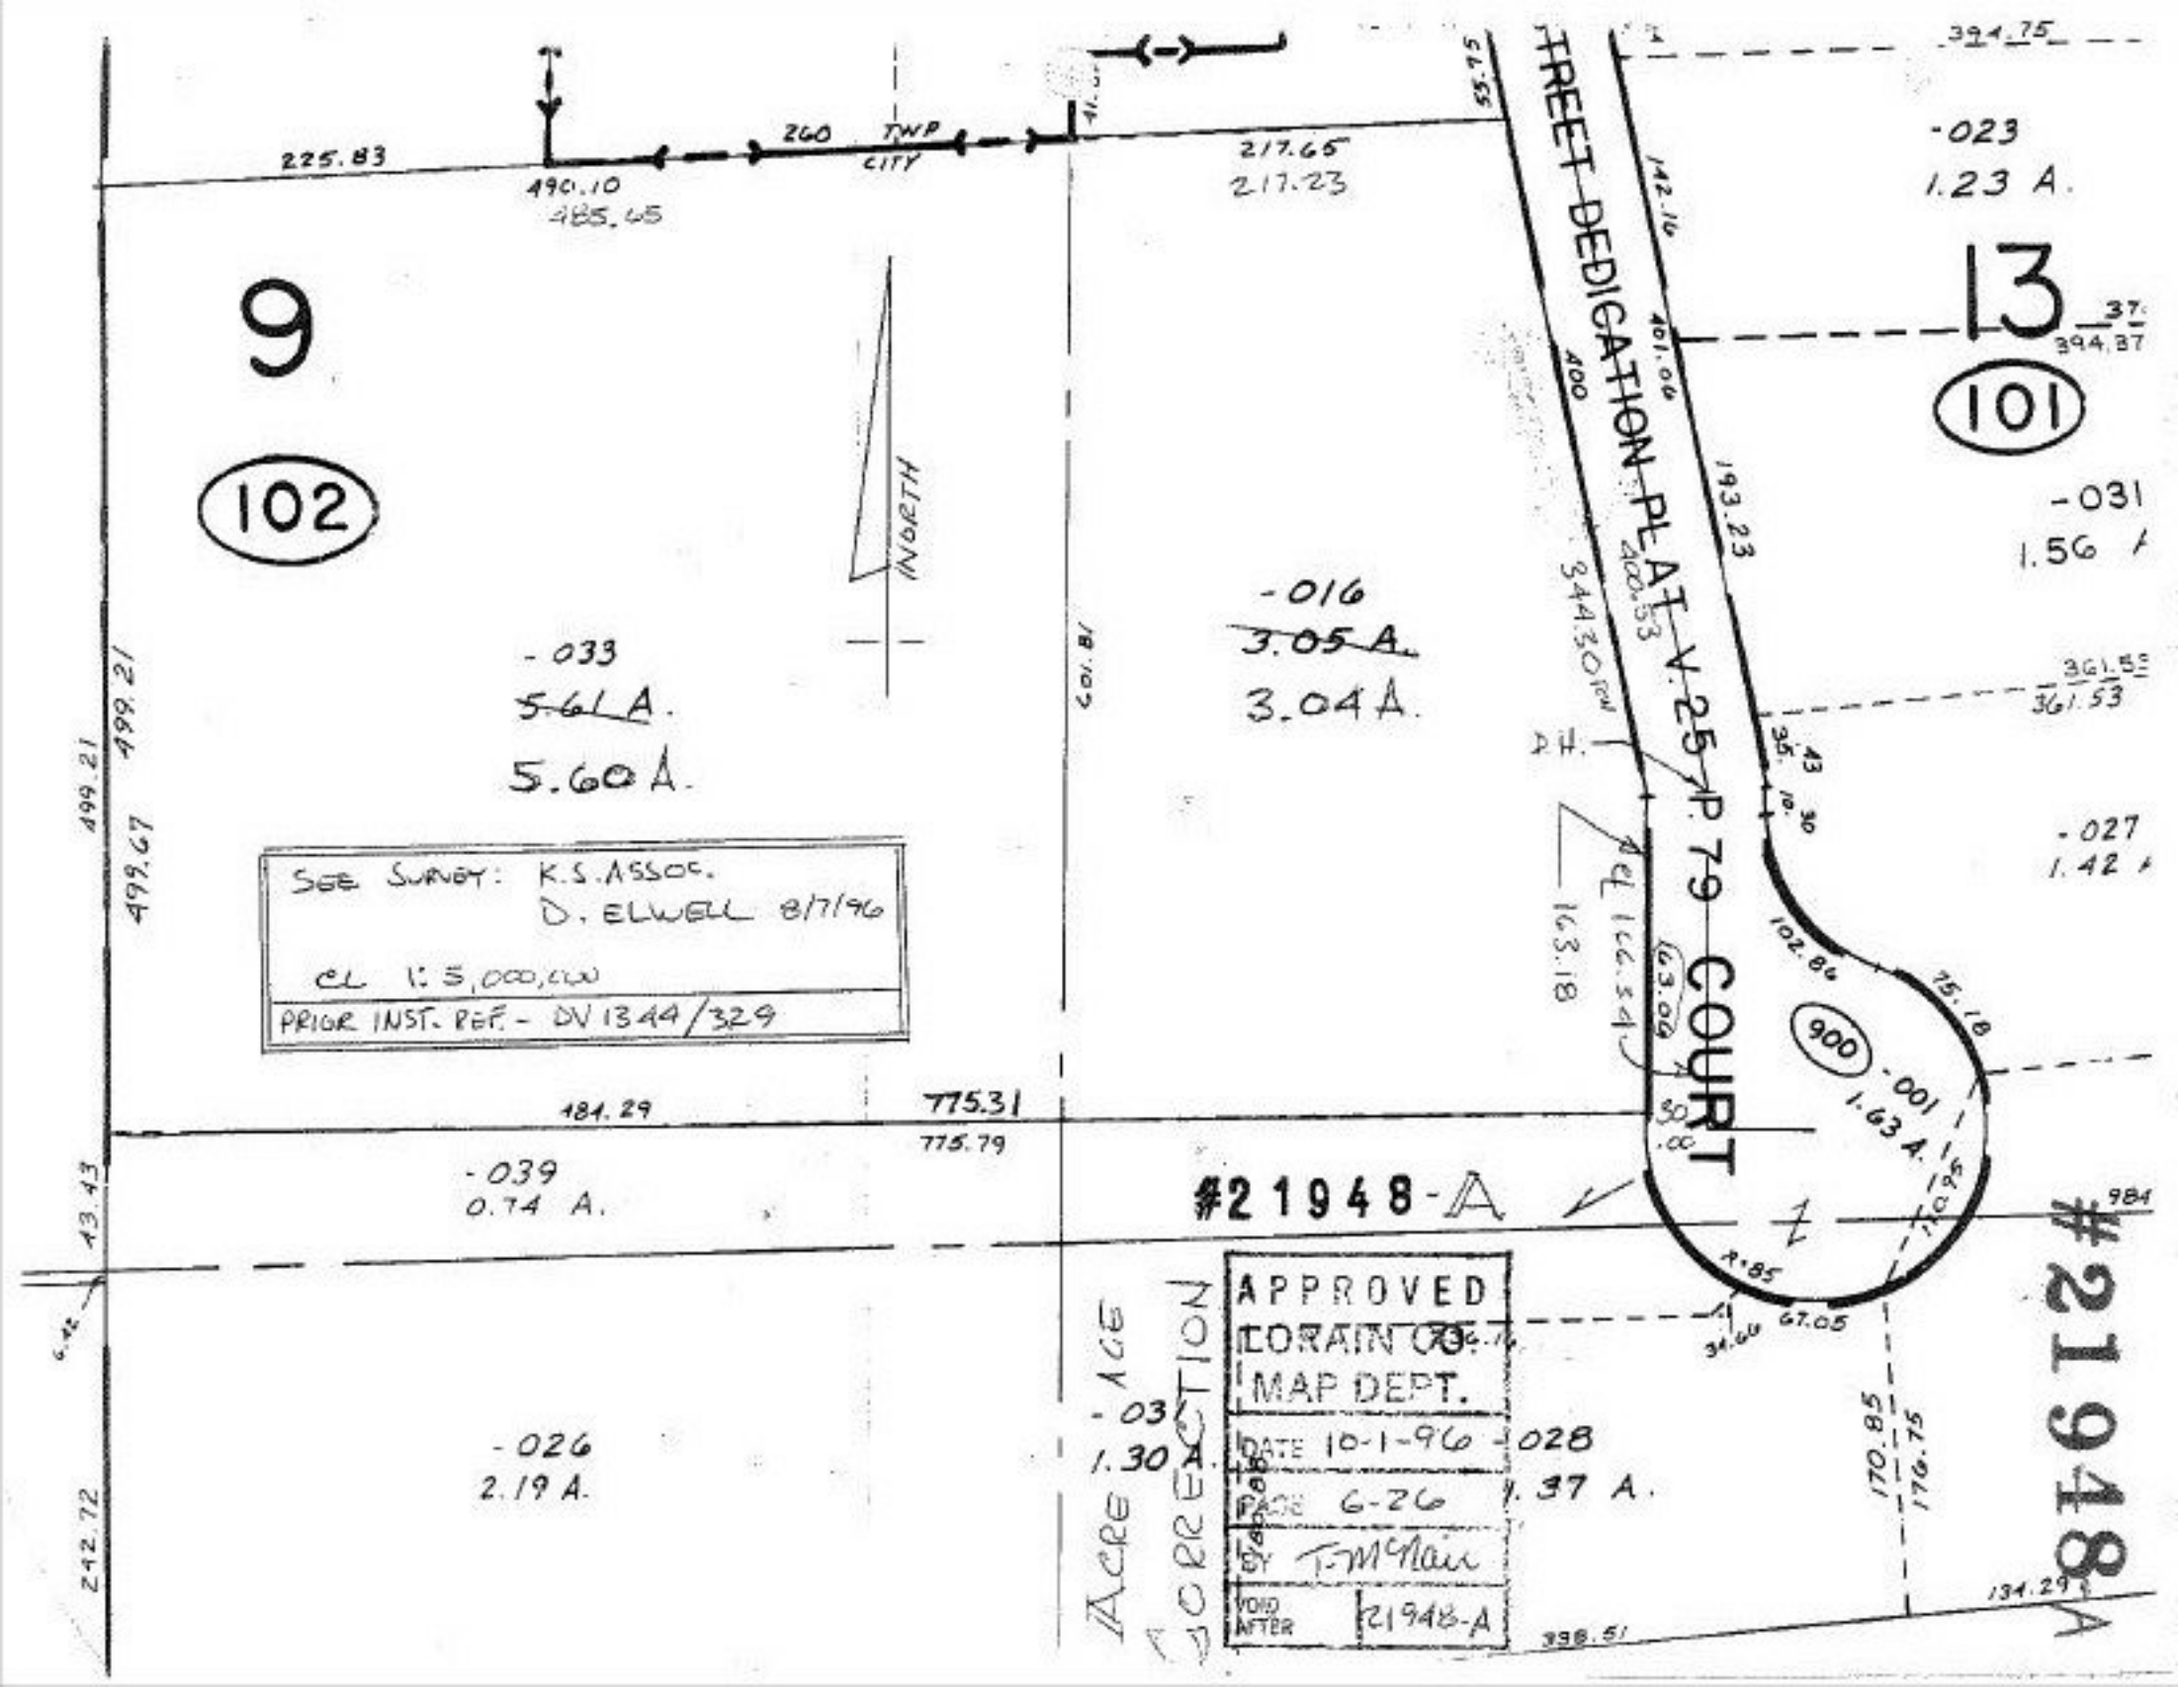
9
102
225.83
490.10
485.65
260 TWP
CITY
217.65
217.23
55.75
394.75
-023
1.23 A.
13
394.87
101
-031
1.56 A
-016
3.05 A.
3.04 A.
-033
5.6 LA.
5.60 A.
NORTH
601.81
499.21
499.67
499.21
SEE SURVEY: K.S. ASSOC.
D. ELWELL 8/7/96
CL 1: 5,000,000
PRIOR INST. REF. - DV 1344/329
181.29
775.31
775.79
-039
0.74 A.
13.43
#21948-A
-026
2.19 A.
242.72
ACRE-AGE CORRECTION
-03
1.30 A.
-028
1.37 A.
APPROVED
LORAIN CO.
MAP DEPT.
DATE 10-1-96
PAGE 6-26
BY T. McNair
VOID AFTER 21948-A
STREET DEDICATION PLAT V. 25 P. 79 COURT
142.16
401.00
400
193.23
400.53
344.30 TCM
A.H.
AL 166.34
163.18
163.00
102.84
900
.001
1.63 A.
15.18
30.00
R.85
67.05
170.85
170.75
134.29
398.51
361.53
361.53
35.43
10.30
#21948-A