#21949-A

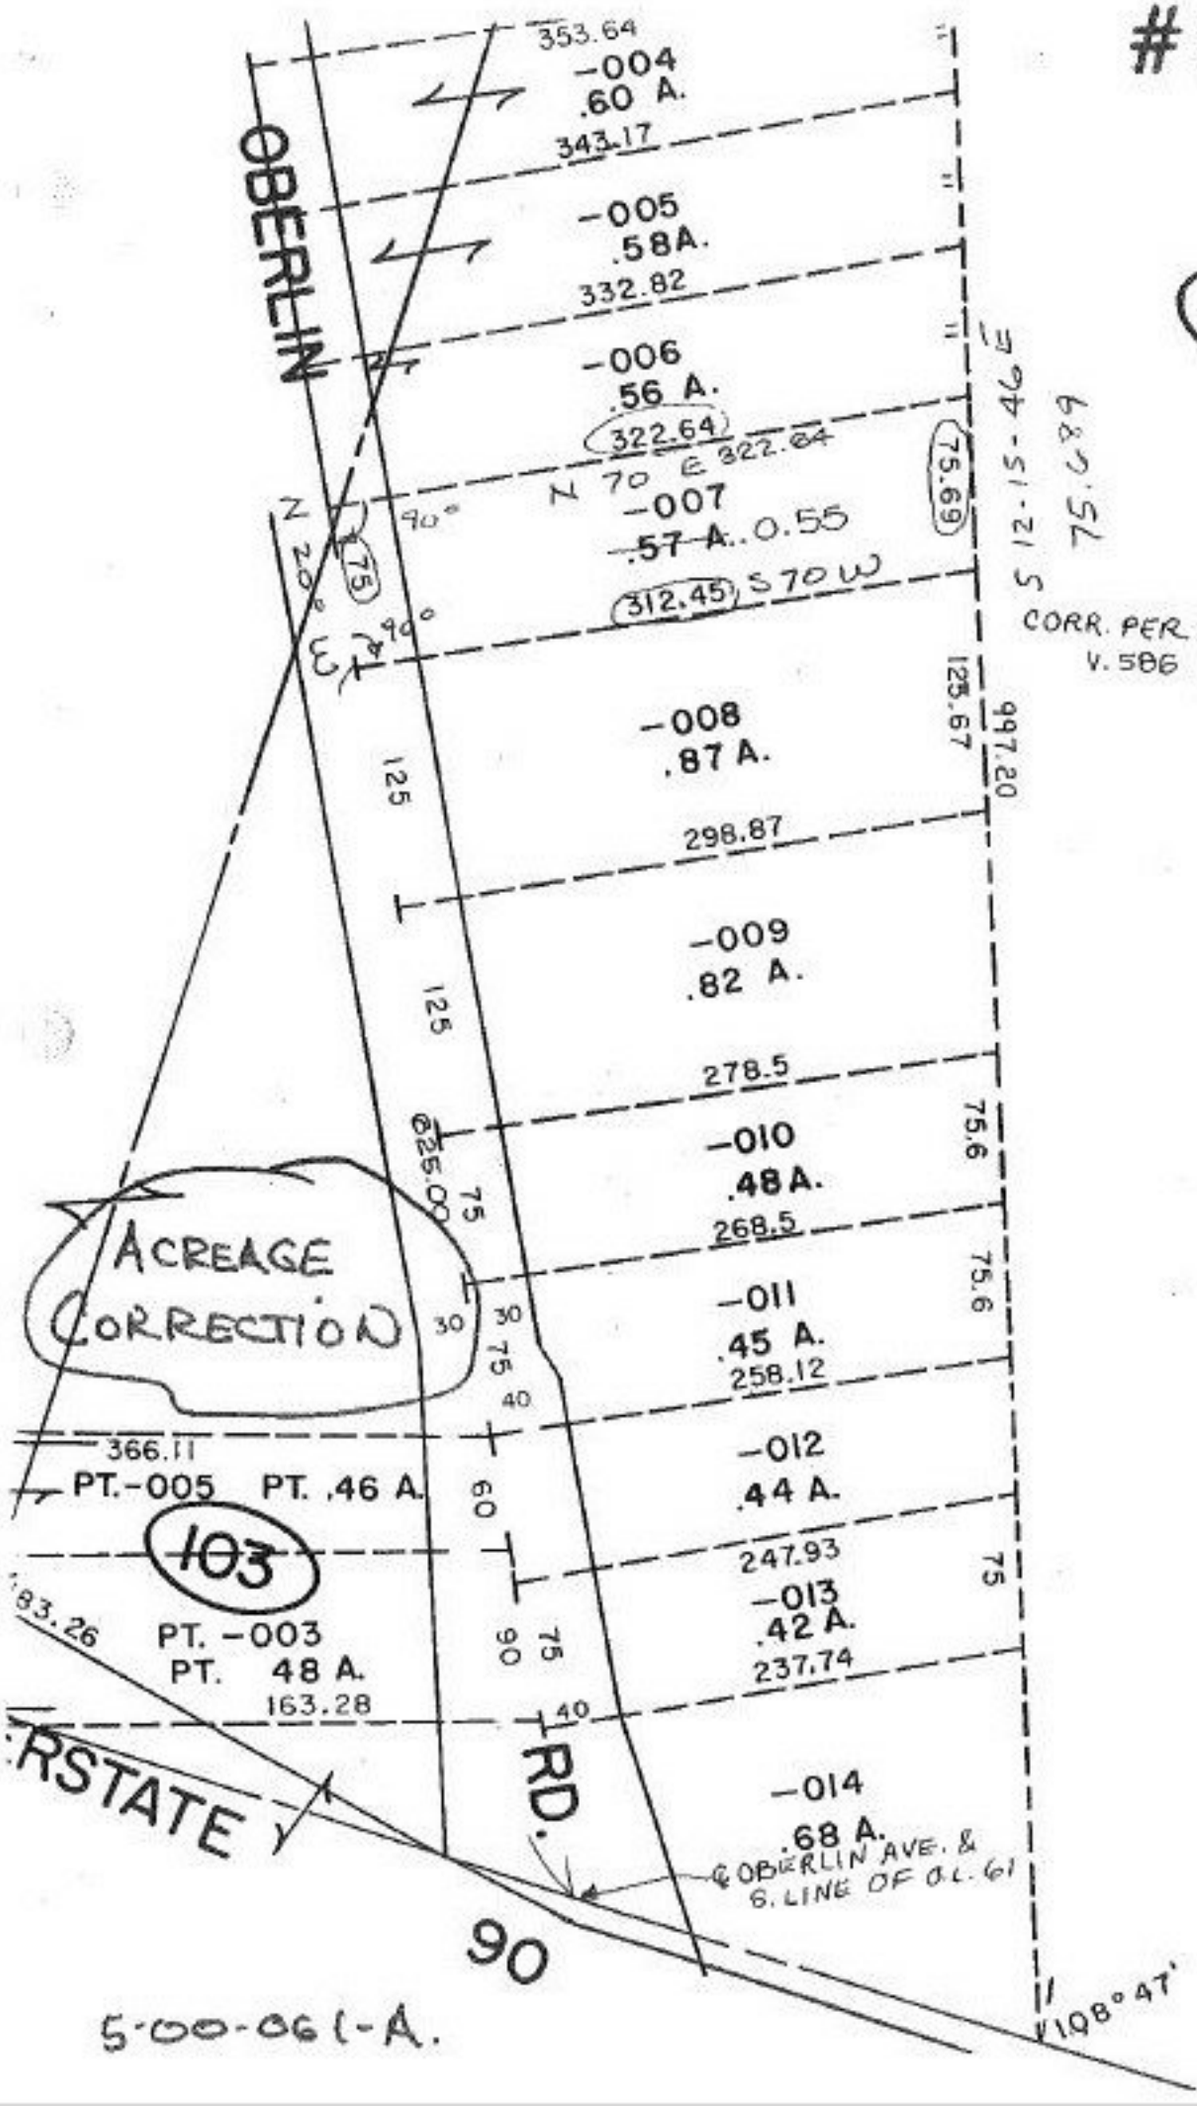

104

24

21949-A

APPROVED
LORAIN CO.
MAP DEPT.
DATE 11-15-96
PAGE 5-00-061-A
BY K. DYE
VOID AFTER # 21949-A