


SEE 5-00-040-B

58

1207.16

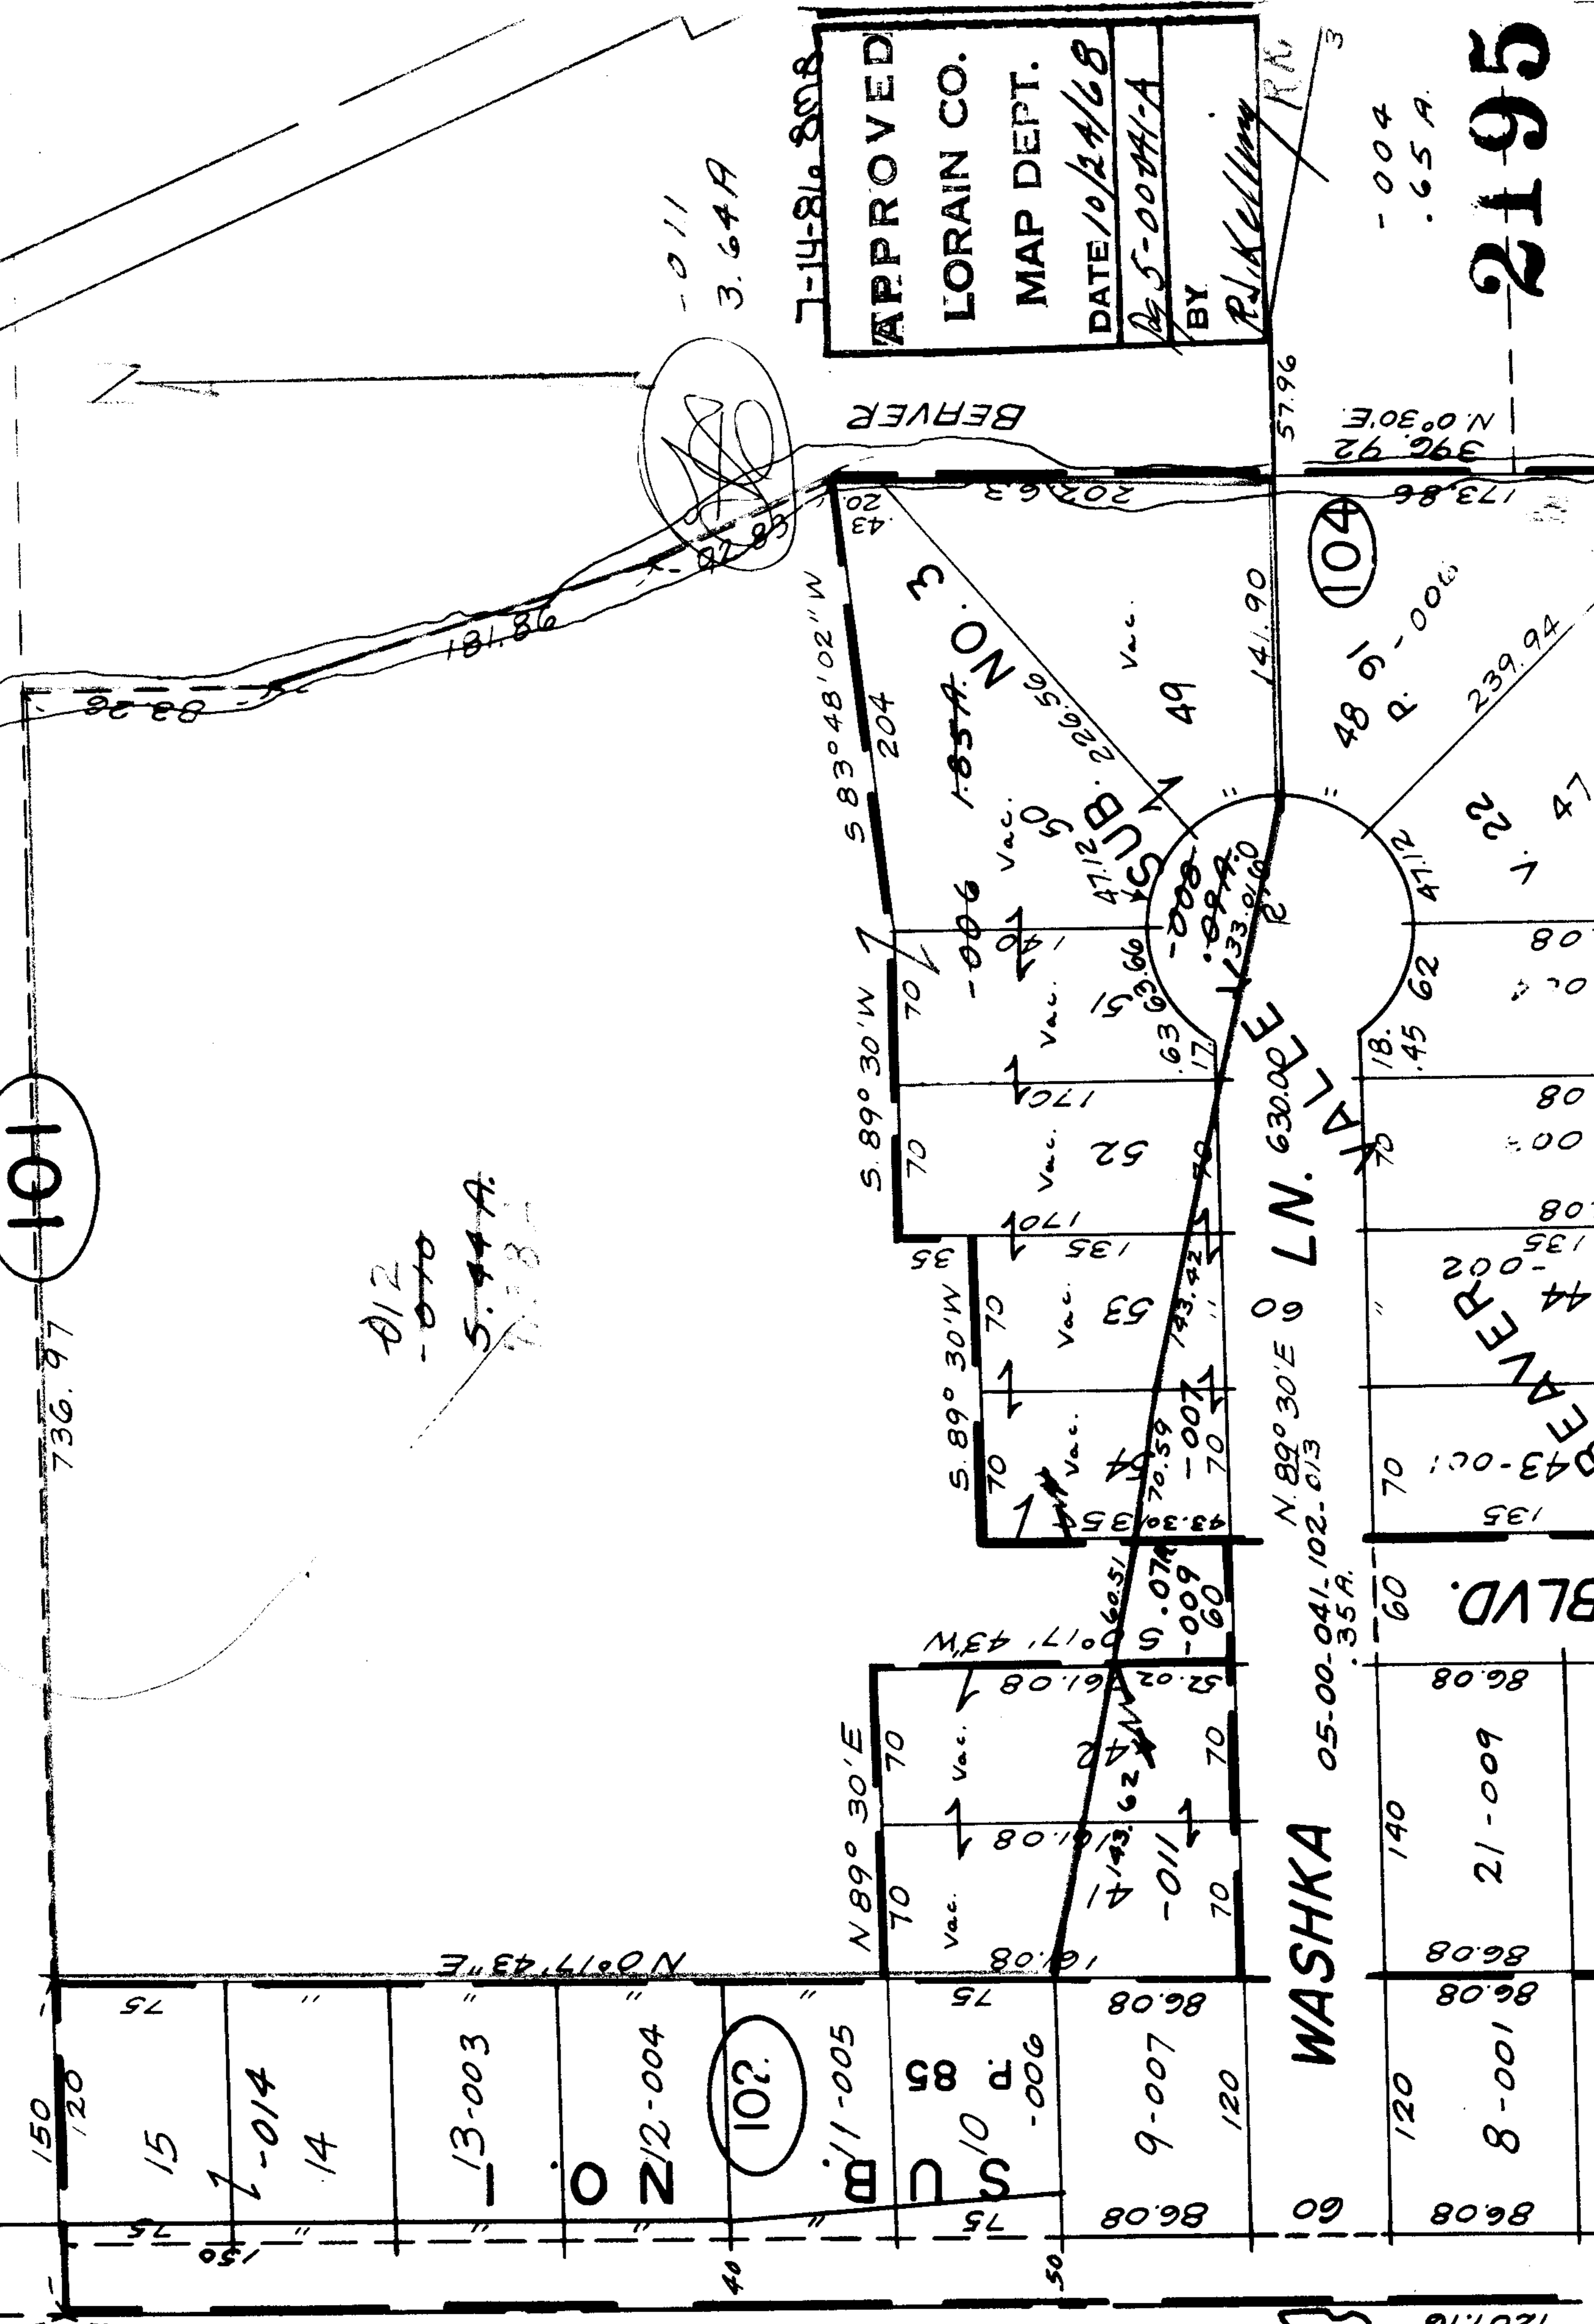

101

102

104

2195

2195

7-14-81 8MB

APPROVED  
LORAIN CO.  
MAP DEPT.  
DATE 10/24/68  
BY S-00741-A  
R. Kelly

012  
-070  
5-44A  
7-28

-011  
3.64A

WASHKA 05-00-041.102.013  
35A

-004  
.65A

BEVER

BLVD.

BEAVER

BEAVER




736.97

150

15

1-014

14

13-003

12-004

11-005

10-006

9-007

120

60

86.08

8-001

21-009

20-010

736.97

101

83.26

181.86

202.63

396.92

173.86

57.96

141.90

48.91

239.94

47.00

181.08

46.00

211.08

45.00

211.08

135

44.00

135

70

70

