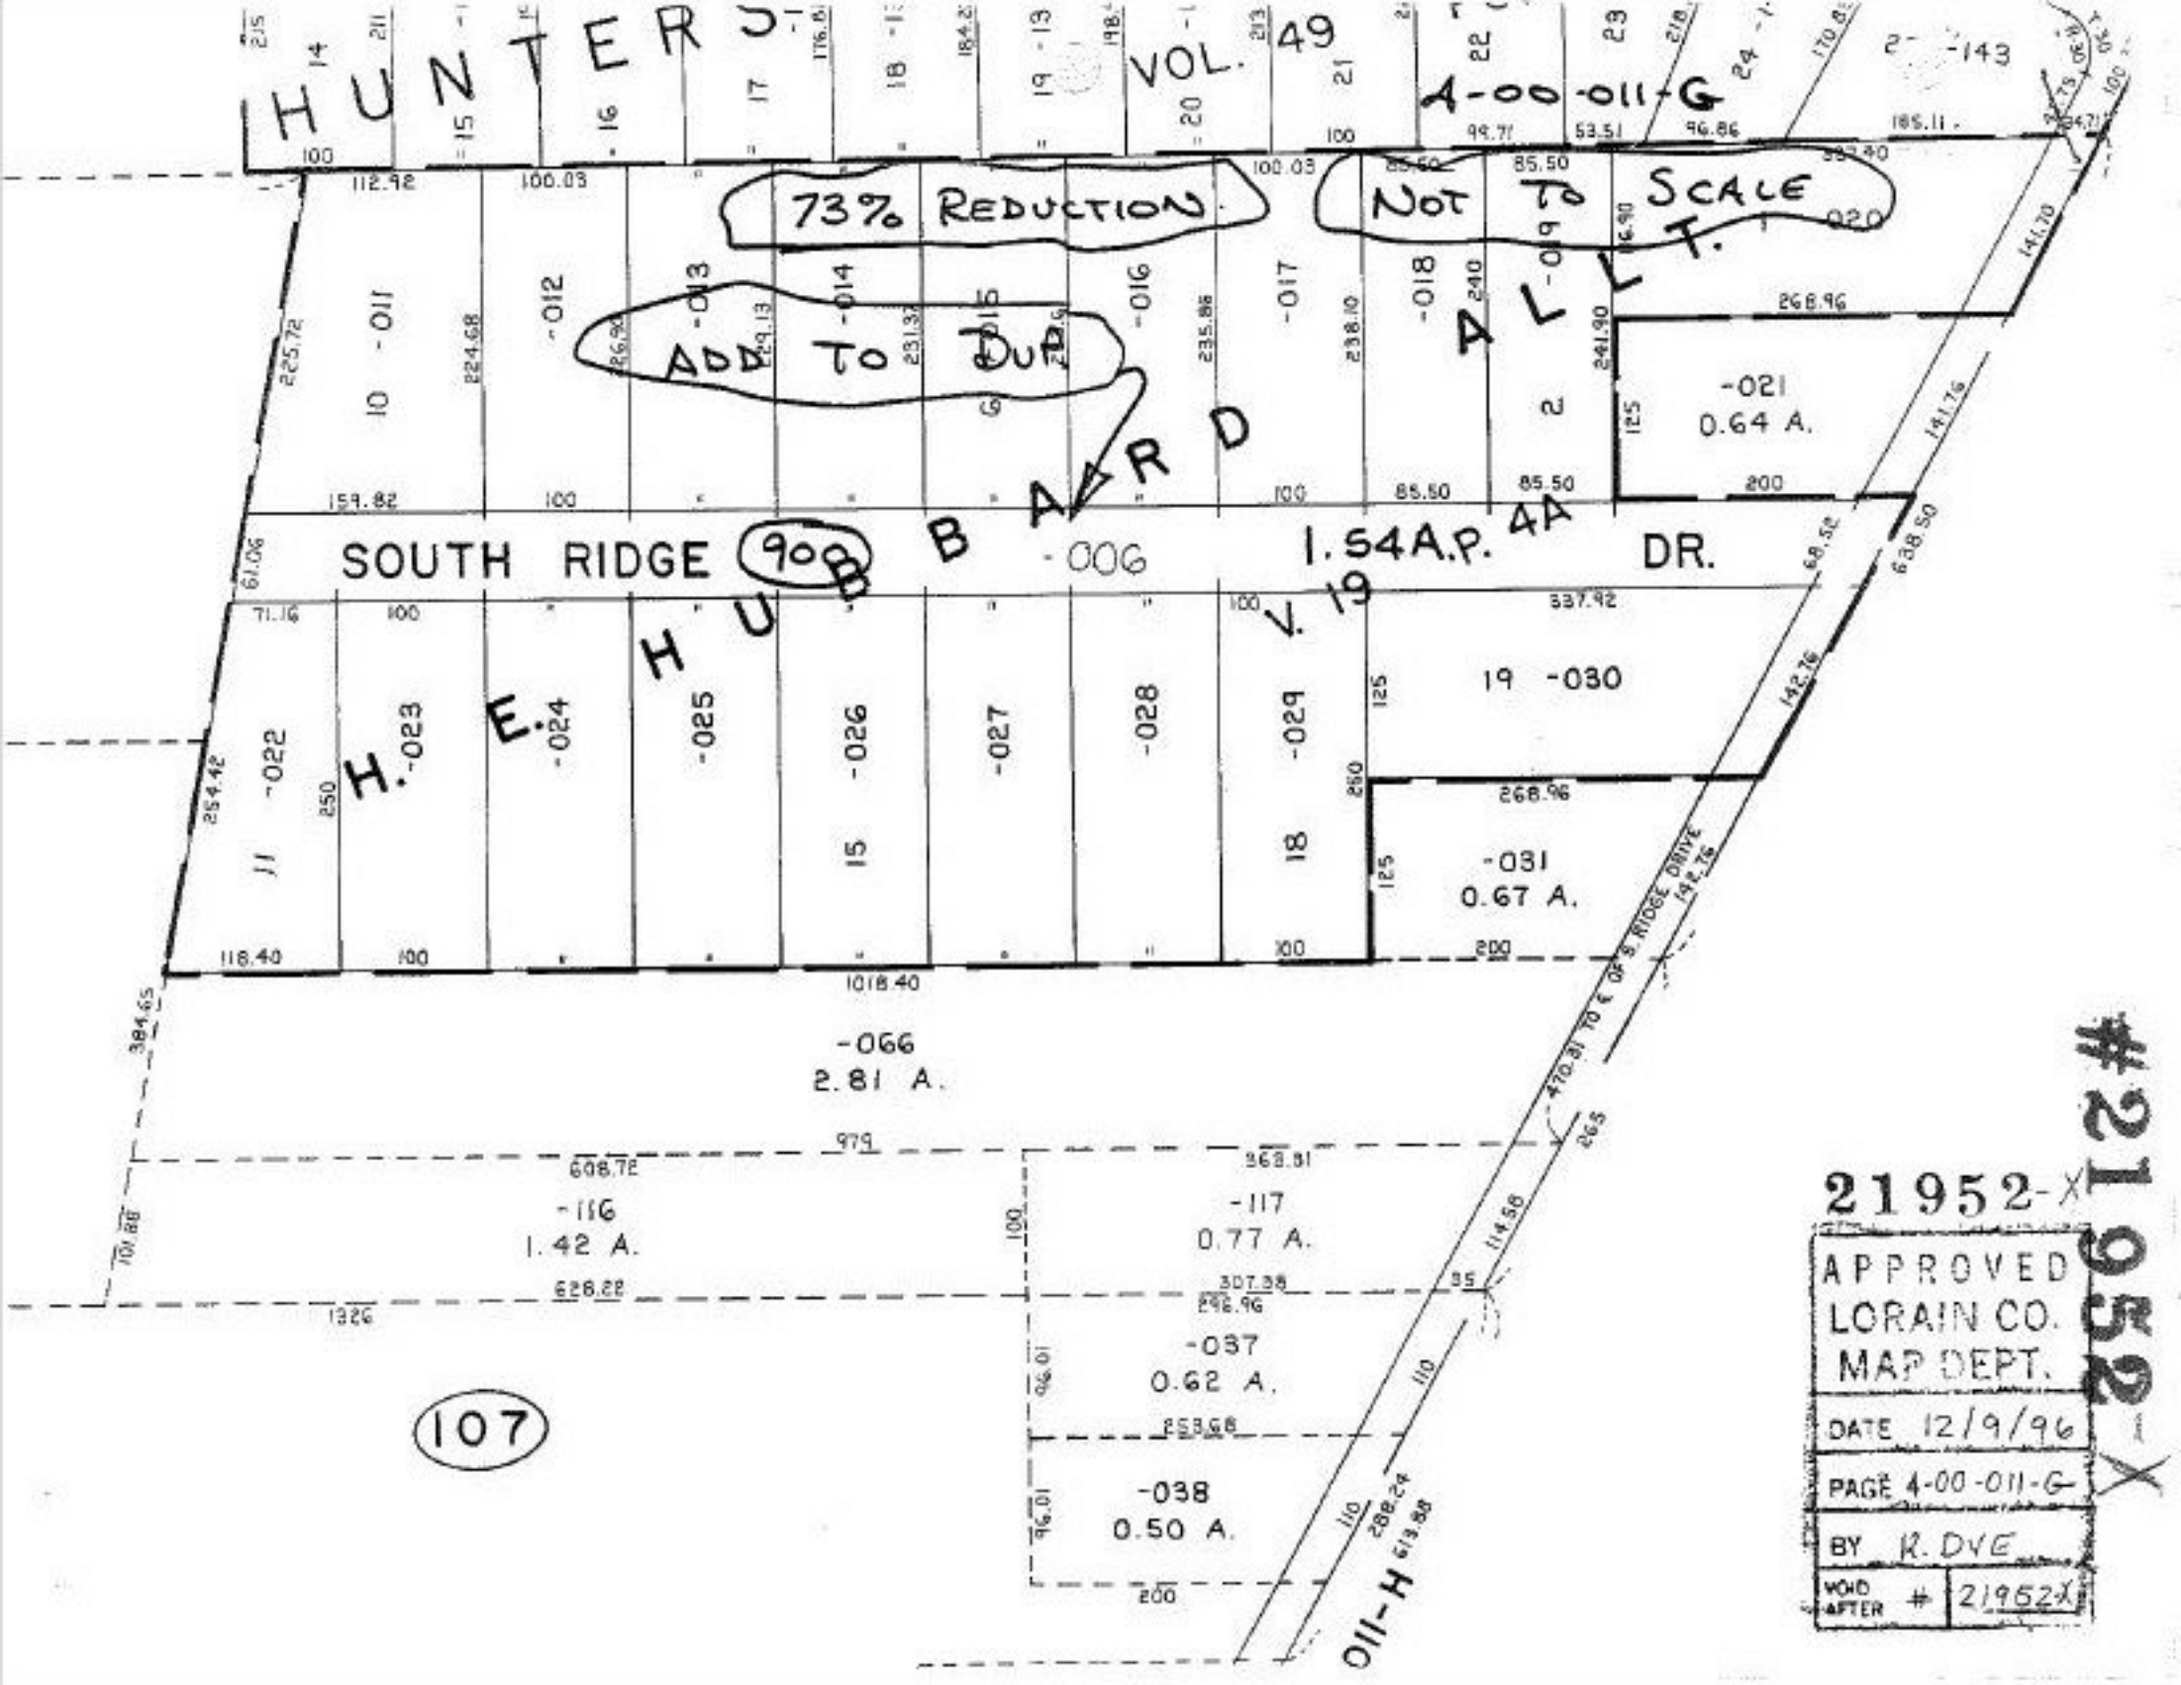
HUNTER
VOL. 49
4-00-011-G
73% REDUCTION
NOT TO SCALE
ADD TO SUB
ALLT.
SOUTH RIDGE
900
HUBBARD
1.54A.P.
DR.
-021
0.64 A.
19 -030
-031
0.67 A.
-066
2.81 A.
-116
1.42 A.
-117
0.77 A.
-037
0.62 A.
-038
0.50 A.
107
011-H
21952-X
APPROVED
LORAIN CO.
MAP DEPT.
DATE 12/9/96
PAGE 4-00-011-G
BY R. DYE
VOID AFTER # 21952X
