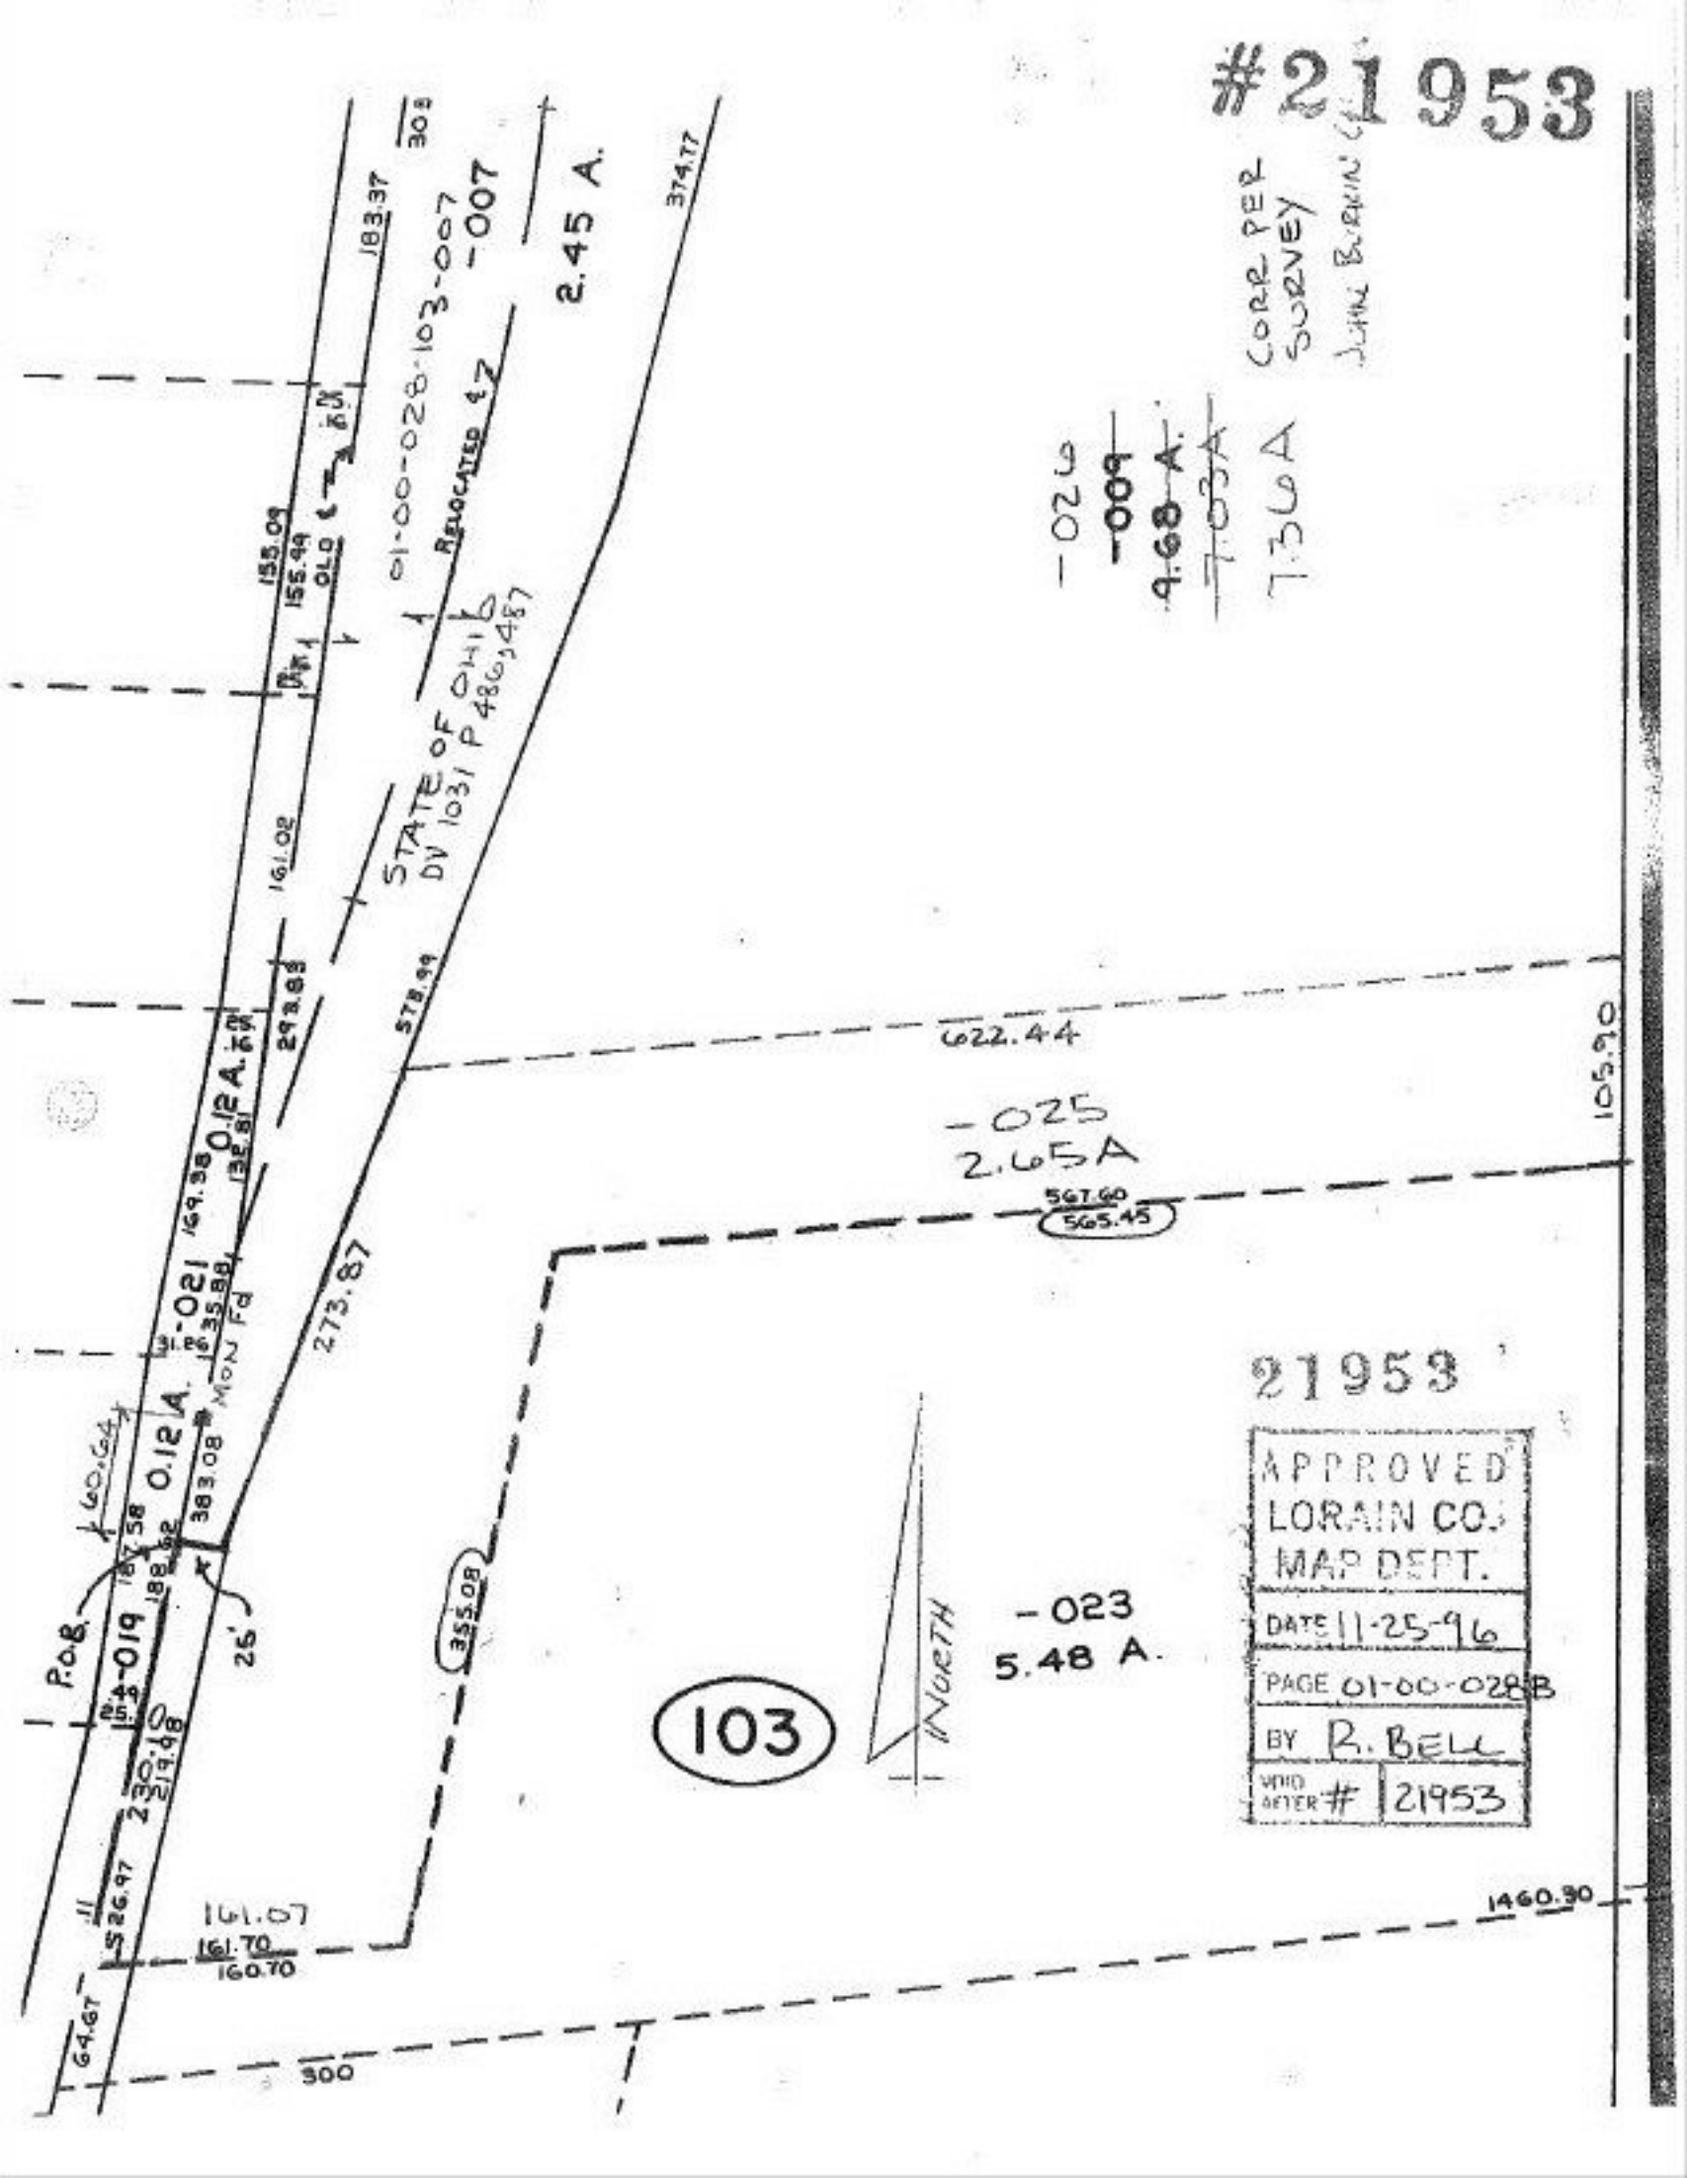
#21953
CORR PER SURVEY JOHN BURNS
-026
-009
9.68 A.
7.03A
7.36A
01-00-028-103-007
-007
RELOCATED 42
2.45 A.
STATE OF OHIO
DV 1031 P 480, 487
-021
0.12 A.±
-019
0.12 A.±
-025
2.65A
-023
5.48 A.
103
NORTH
MON Rd
P.O.B.
183.37
155.09
155.49
OLD
161.02
292.88
132.81
169.98
35.88
383.08
60.64
187.58
188.62
25'
230.48
219.48
526.97
161.07
161.70
160.70
64.67
300
273.87
578.99
374.77
622.44
567.60
565.45
355.08
105.90
1460.90
21953
APPROVED
LORAIN CO.
MAP DEPT.
DATE 11-25-96
PAGE 01-00-028B
BY R. BELL
VOID AFTER # 21953