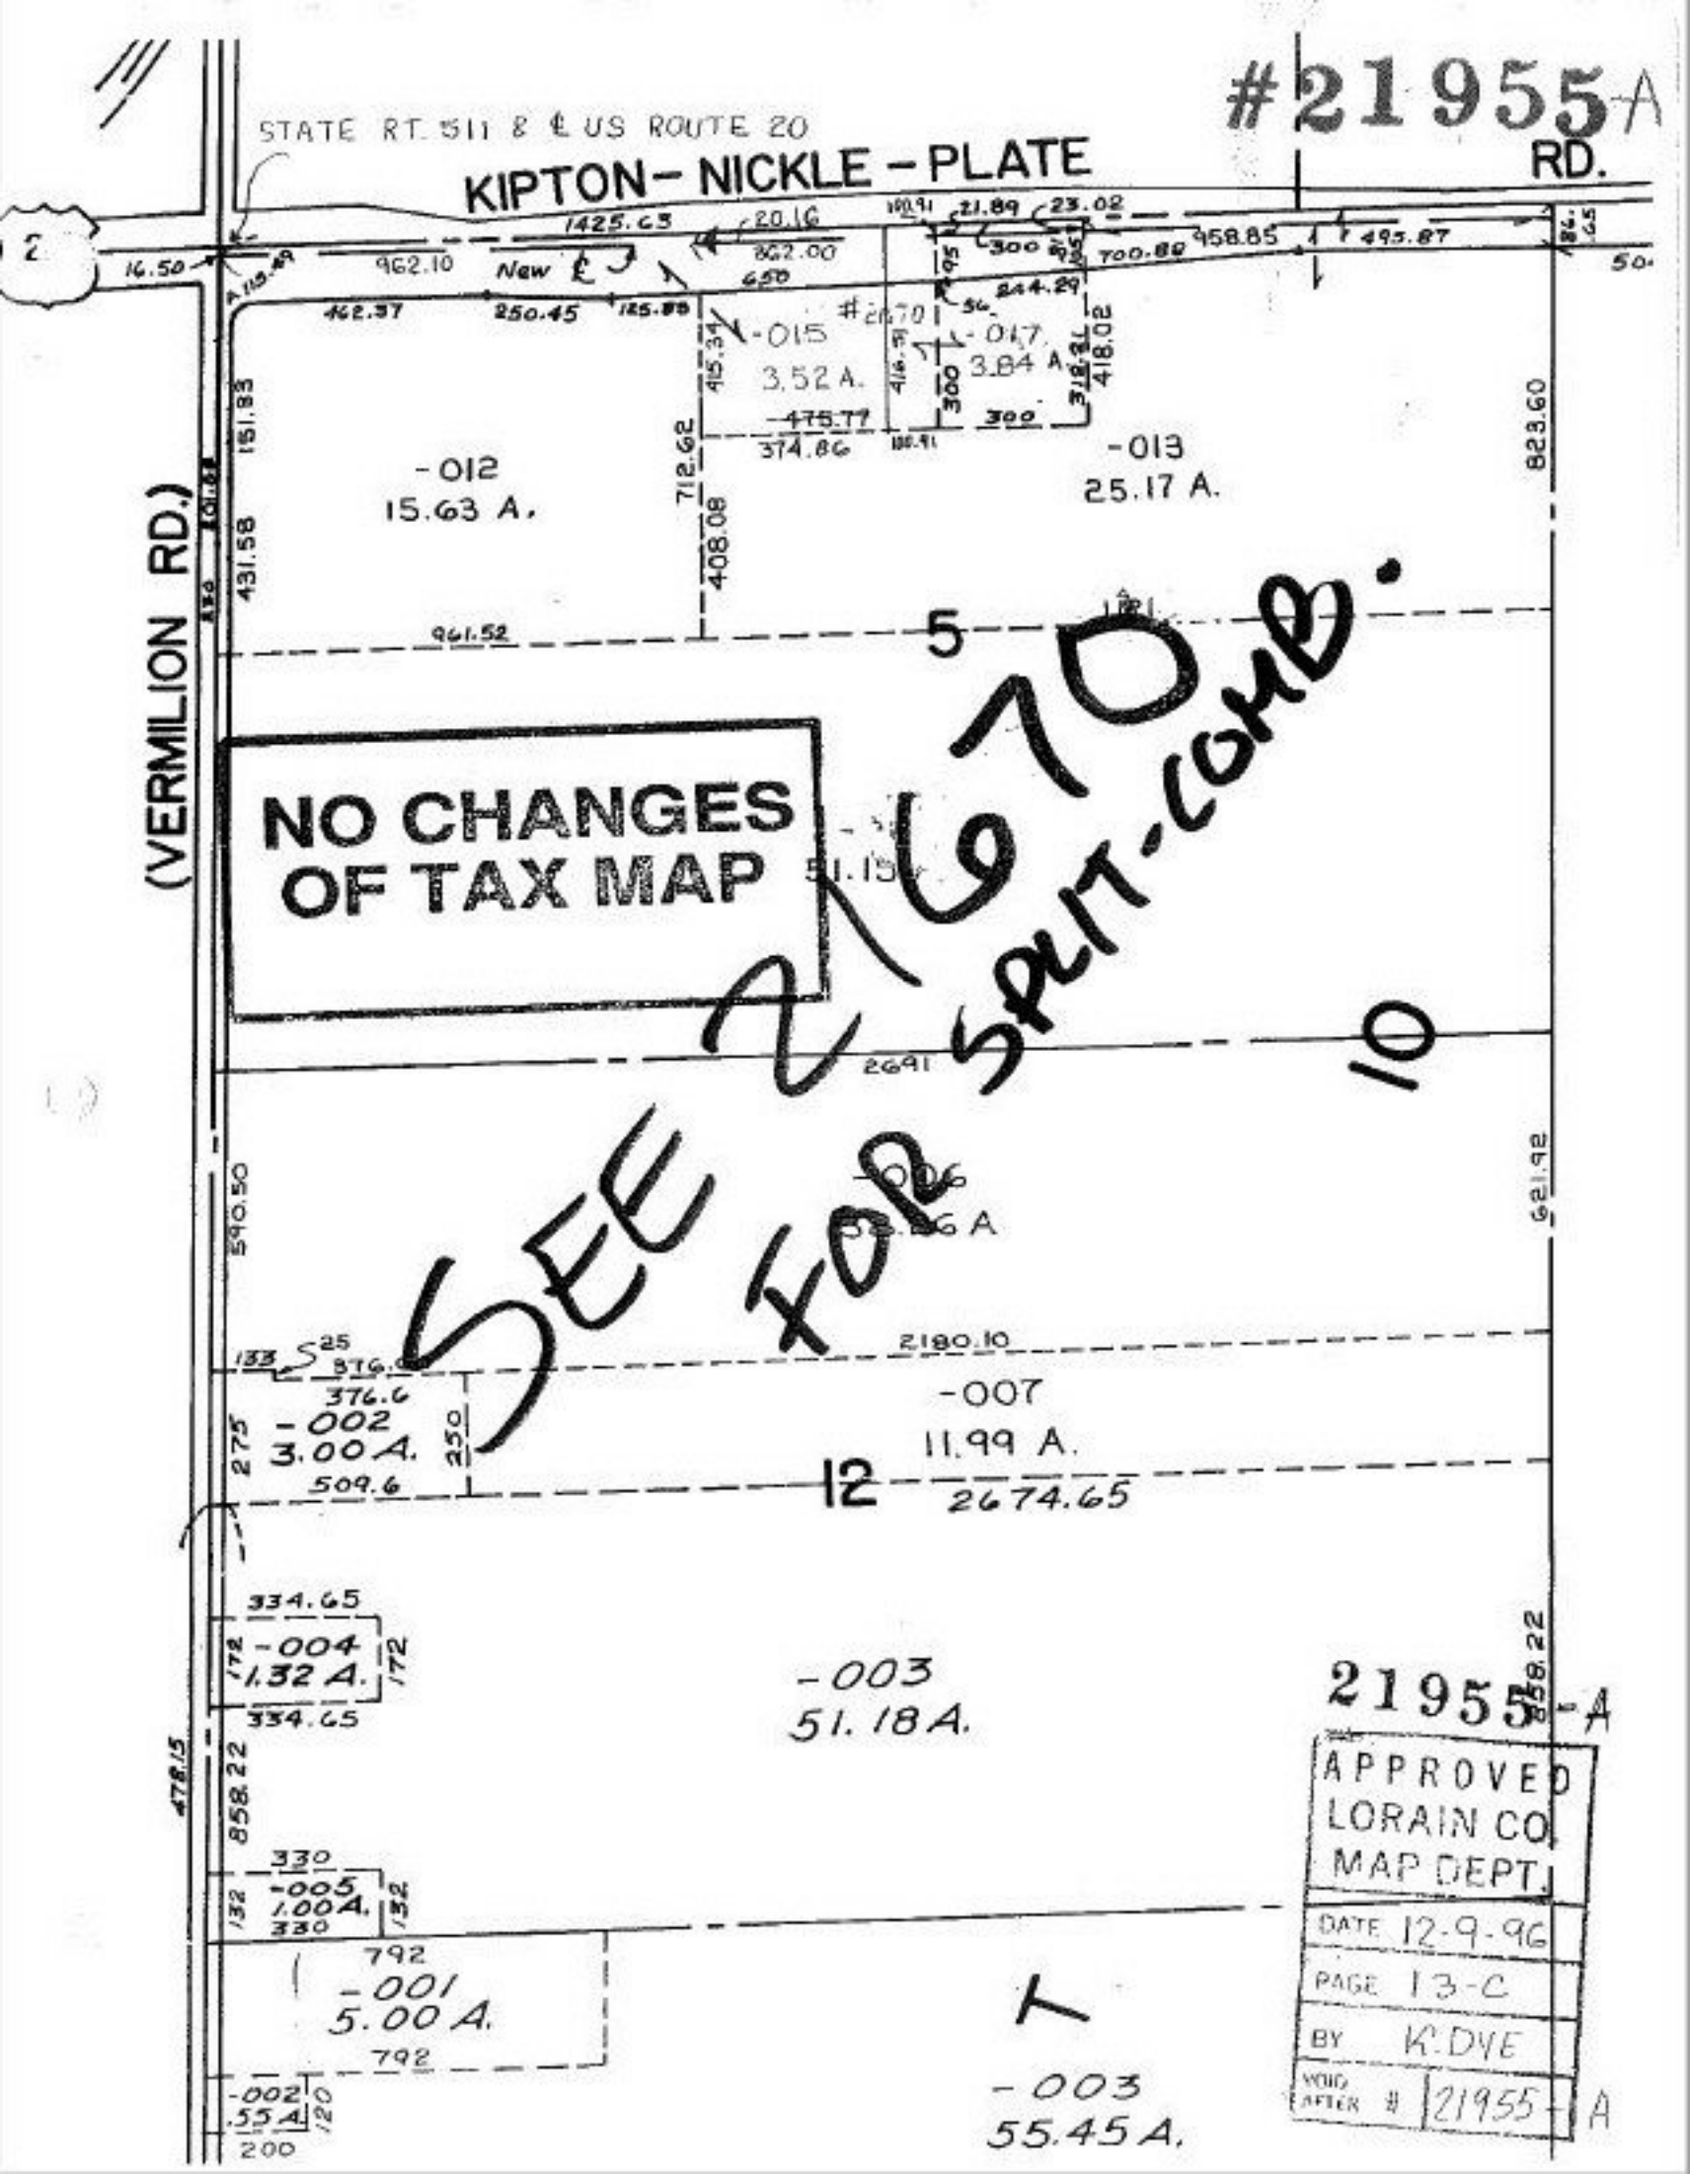
#21955-A
STATE RT. 511 & & US ROUTE 20
KIPTON-NICKLE-PLATE RD.
(VERMILION RD.)
NO CHANGES OF TAX MAP
SEE 21670 FOR SPLIT-COMB.
-012
15.63 A.
-013
25.17 A.
-015
3.52 A.
-017
3.84 A.
-007
11.99 A.
-002
3.00 A.
-004
1.32 A.
-005
1.00 A.
-001
5.00 A.
-003
51.18 A.
-003
55.45 A.
APPROVED
LORAIN CO
MAP DEPT.
DATE 12-9-96
PAGE 13-C
BY K. DYE
VOID AFTER # 21955-A