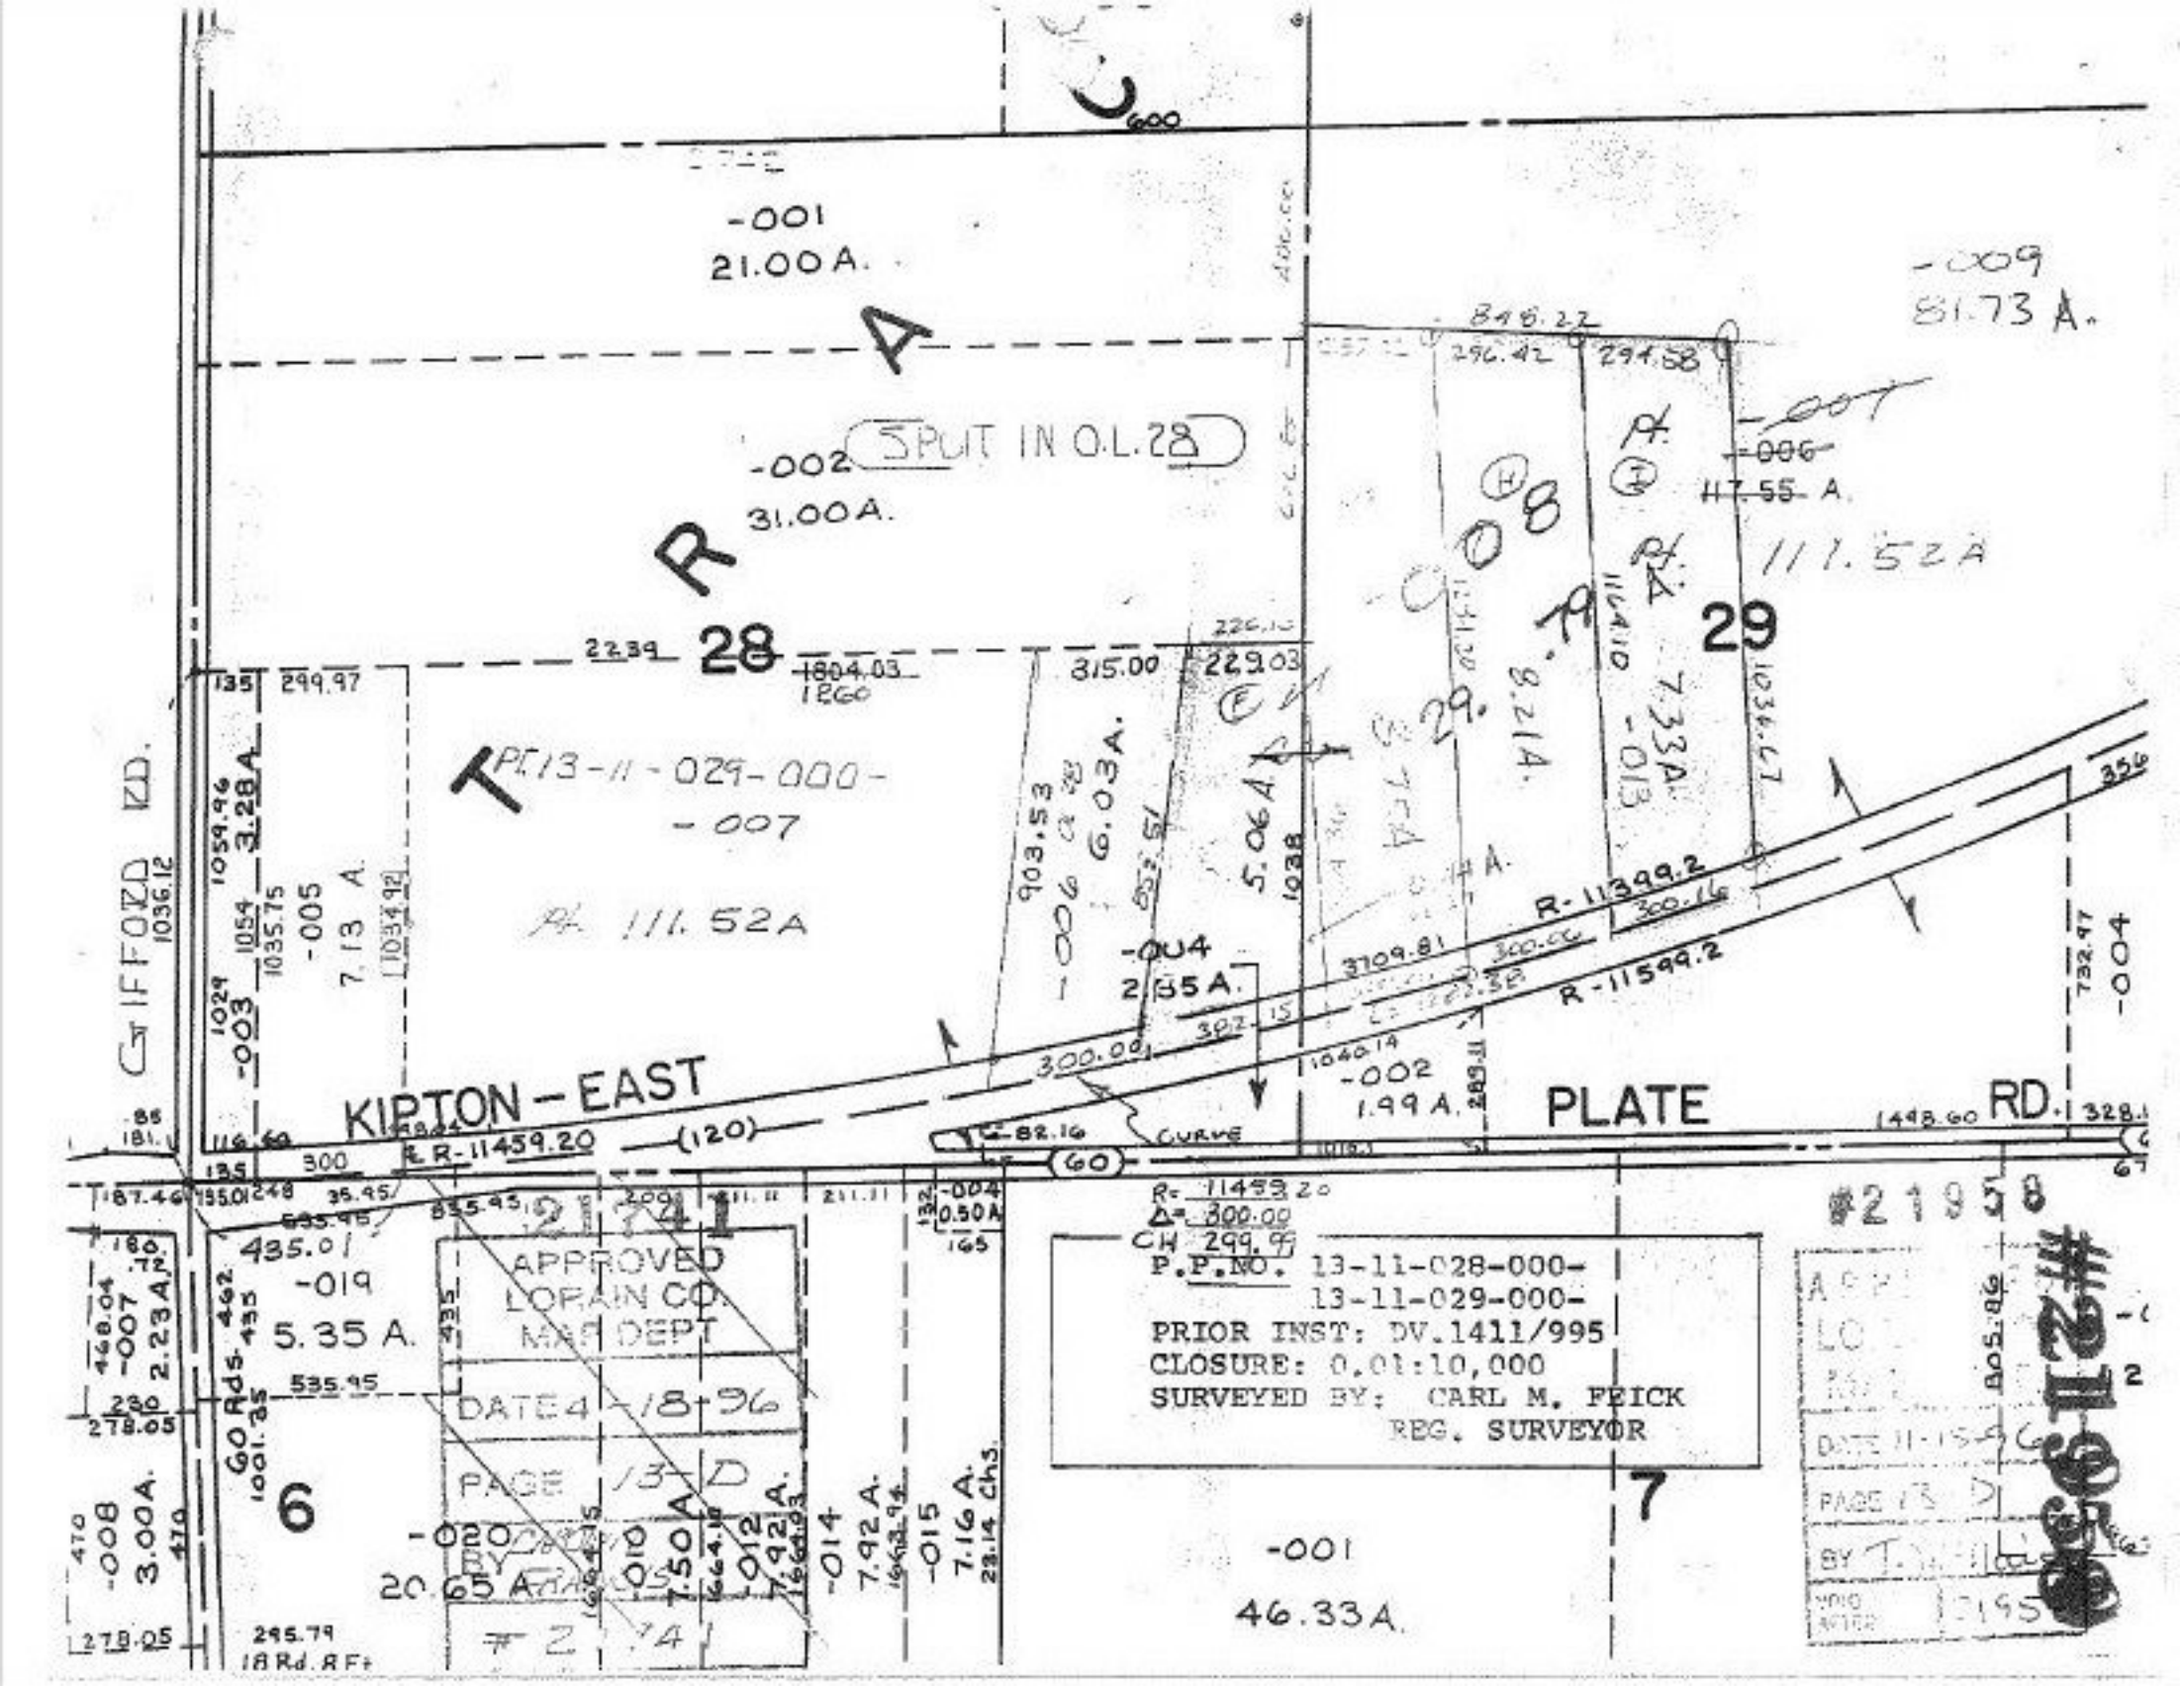
-001
21.00 A.
-002
31.00 A.
SPLIT IN O.L. 28
-009
81.73 A.
-007
-006
117.55 A.
111.52 A
28
29
R
A
T
PT 13-11-029-000-007
PT 111.52 A
-005
7.13 A.
-003
3.28 A.
-004
2.85 A.
-002
1.99 A.
-013
7.33 A.
-014
7.92 A.
-015
7.16 A.
-012
7.92 A.
-010
7.50 A.
-020
-008
3.00 A.
-007
2.23 A.
-019
5.35 A.
-001
46.33 A.
GRIFFORD RD.
KIPTON - EAST
PLATE
RD.
(120)
60
R=11459.20
Δ=300.00
CH 299.99
P.P.NO. 13-11-028-000-
13-11-029-000-
PRIOR INST: DV.1411/995
CLOSURE: 0.01:10,000
SURVEYED BY: CARL M. FEICK
REG. SURVEYOR
APPROVED
LORAIN CO.
MAP DEPT.
DATE 4-18-96
PAGE 13-D
BY
6
7
R-11399.2
R-11599.2