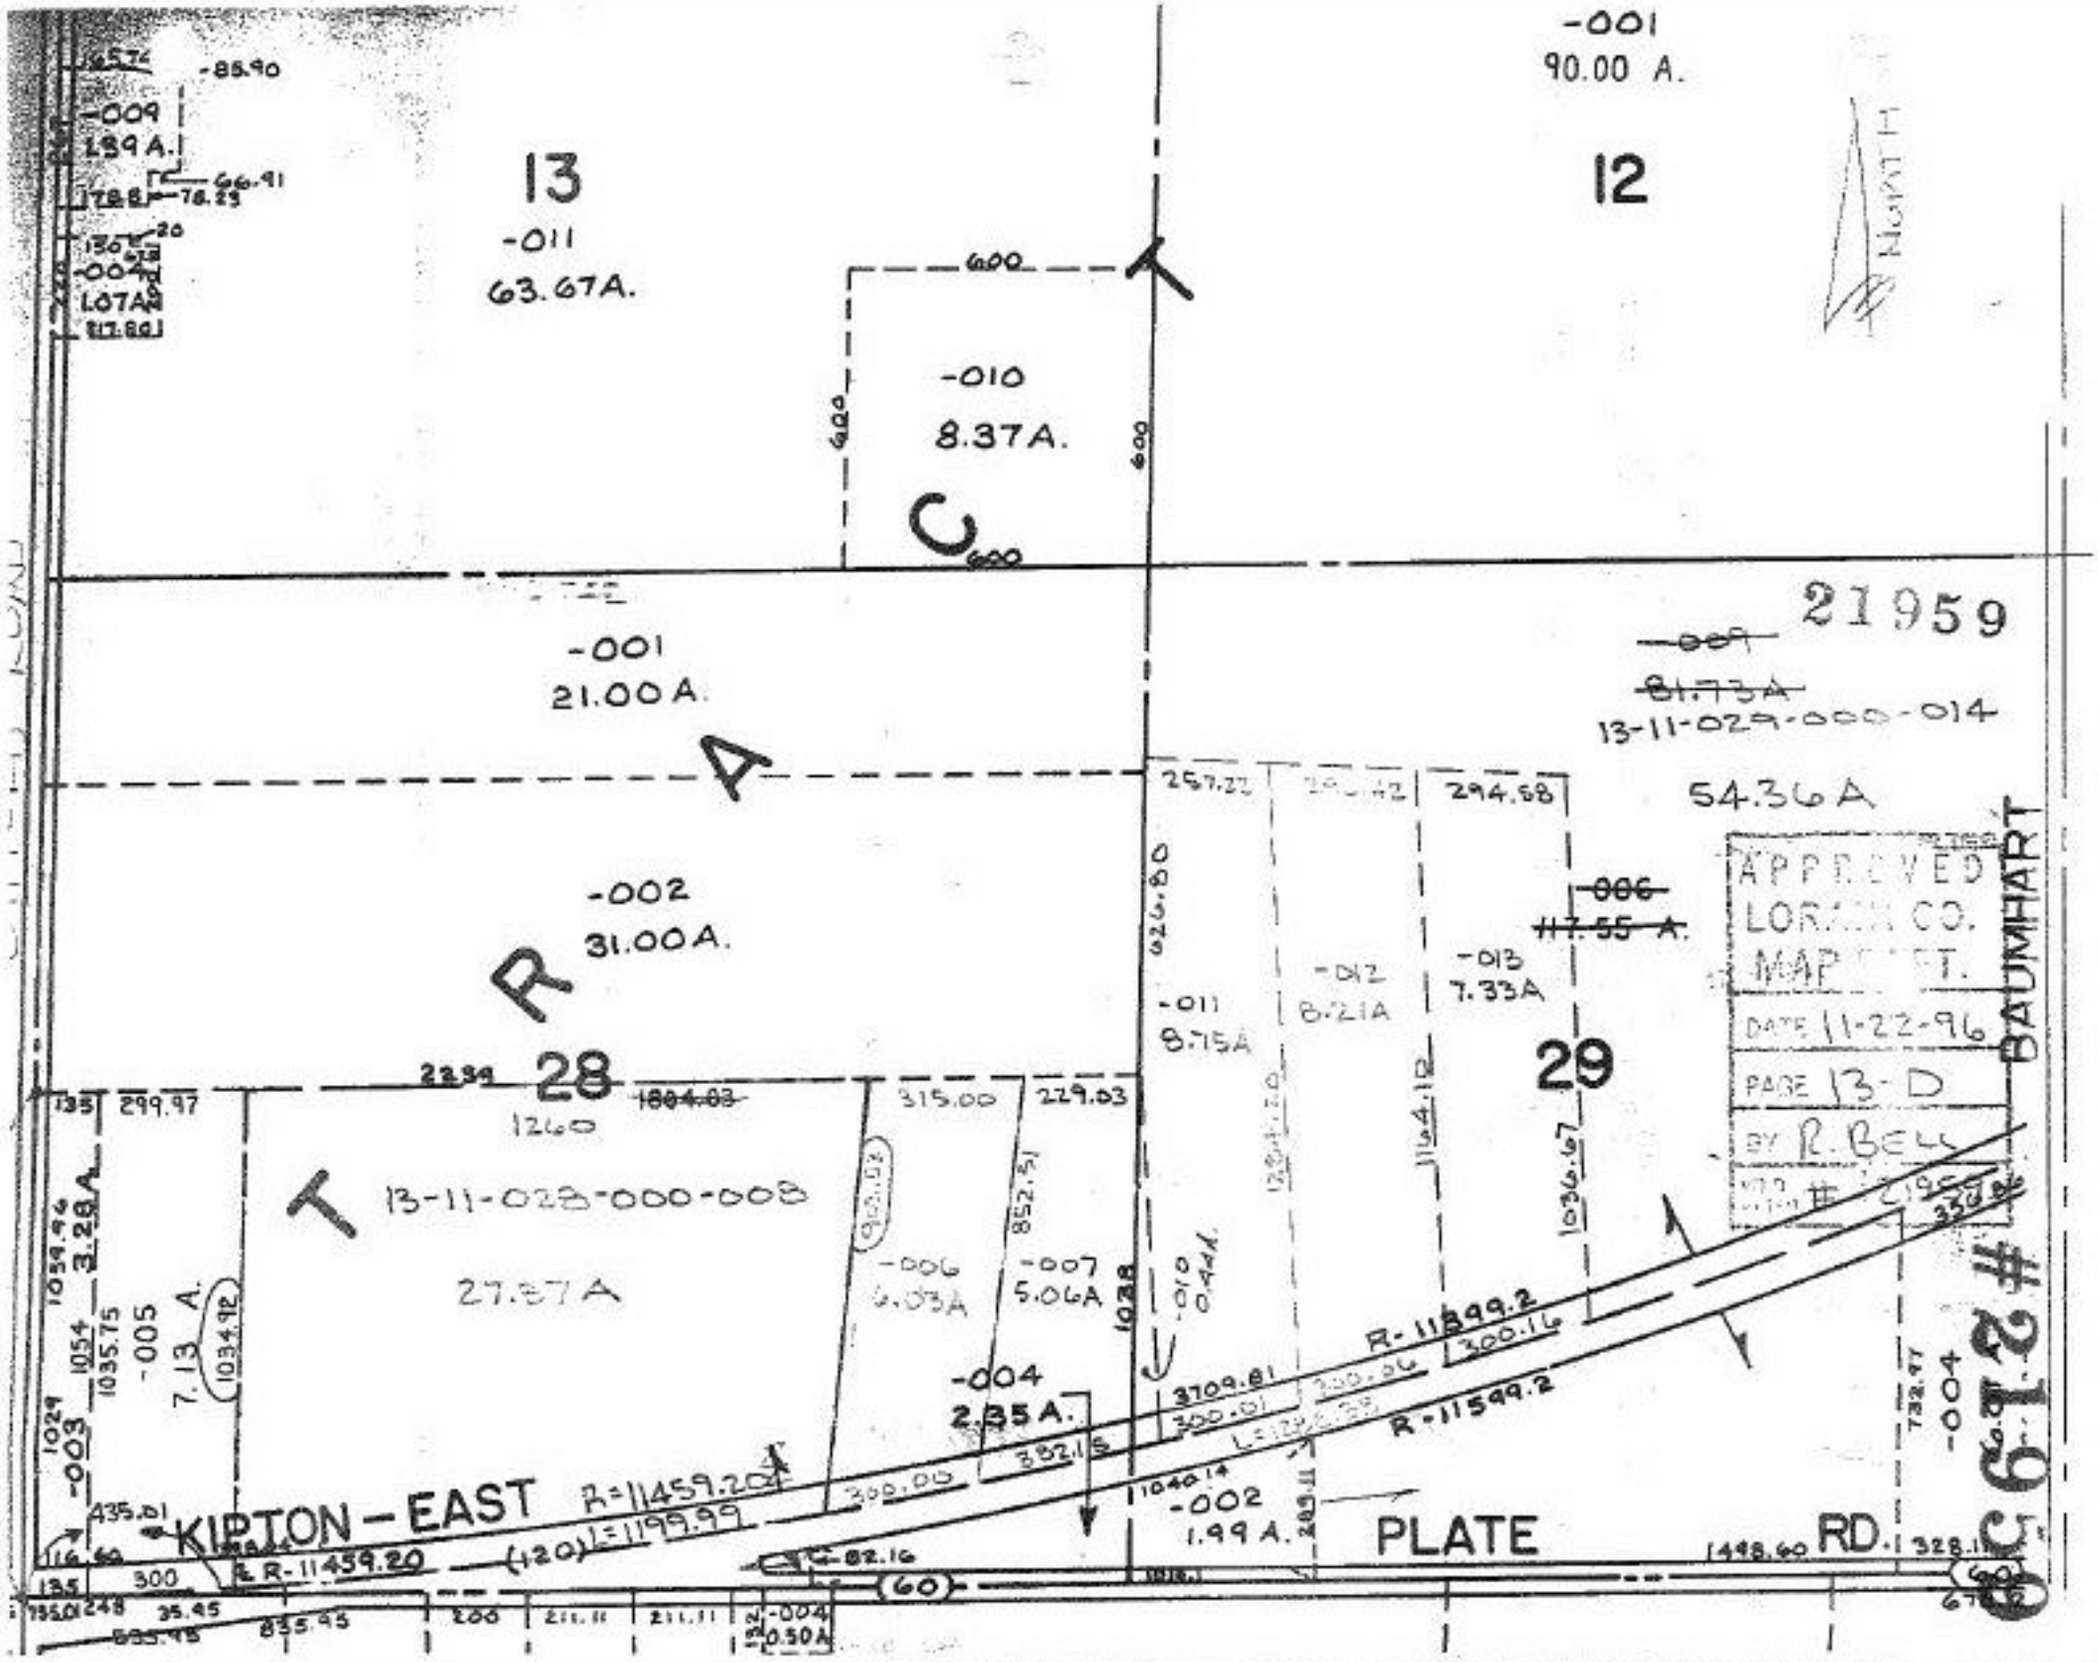
-001
90.00 A.
12
13
-011
63.67A.
-010
8.37A.
600
600
600
C
-001
21.00A.
A
-002
31.00A.
R
28
1260
T
13-11-028-000-008
27.87A
-005
7.13 A.
-003
3.28A.
-006
6.03A
-007
5.06A
-004
2.35A.
-010
0.44A.
-011
8.15A
-012
8.21A
-013
7.33A
29
-006
17.55 A.
21959
-009
81.73A
13-11-029-000-014
54.36A
APPROVED
LORAIN CO.
MAP DEPT.
DATE 11-22-96
PAGE 13-D
BY R. BECK
MAP # 2195
BAUMHART
KIPTON - EAST
PLATE
RD.
R=11459.20
R=11599.2
-002
1.99 A.
-004
0.50A
60
1448.60
1040.14
1038
1164.12
1036.67
626.80
852.31
882.15
3709.81
300.00
300.16
435.01
835.45
328.11
732.97
1034.92
1039.96
1035.75
1029
1054
299.97
315.00
229.03
294.68
257.22
2339
1804.03
1260
8 6 12 #