#21960

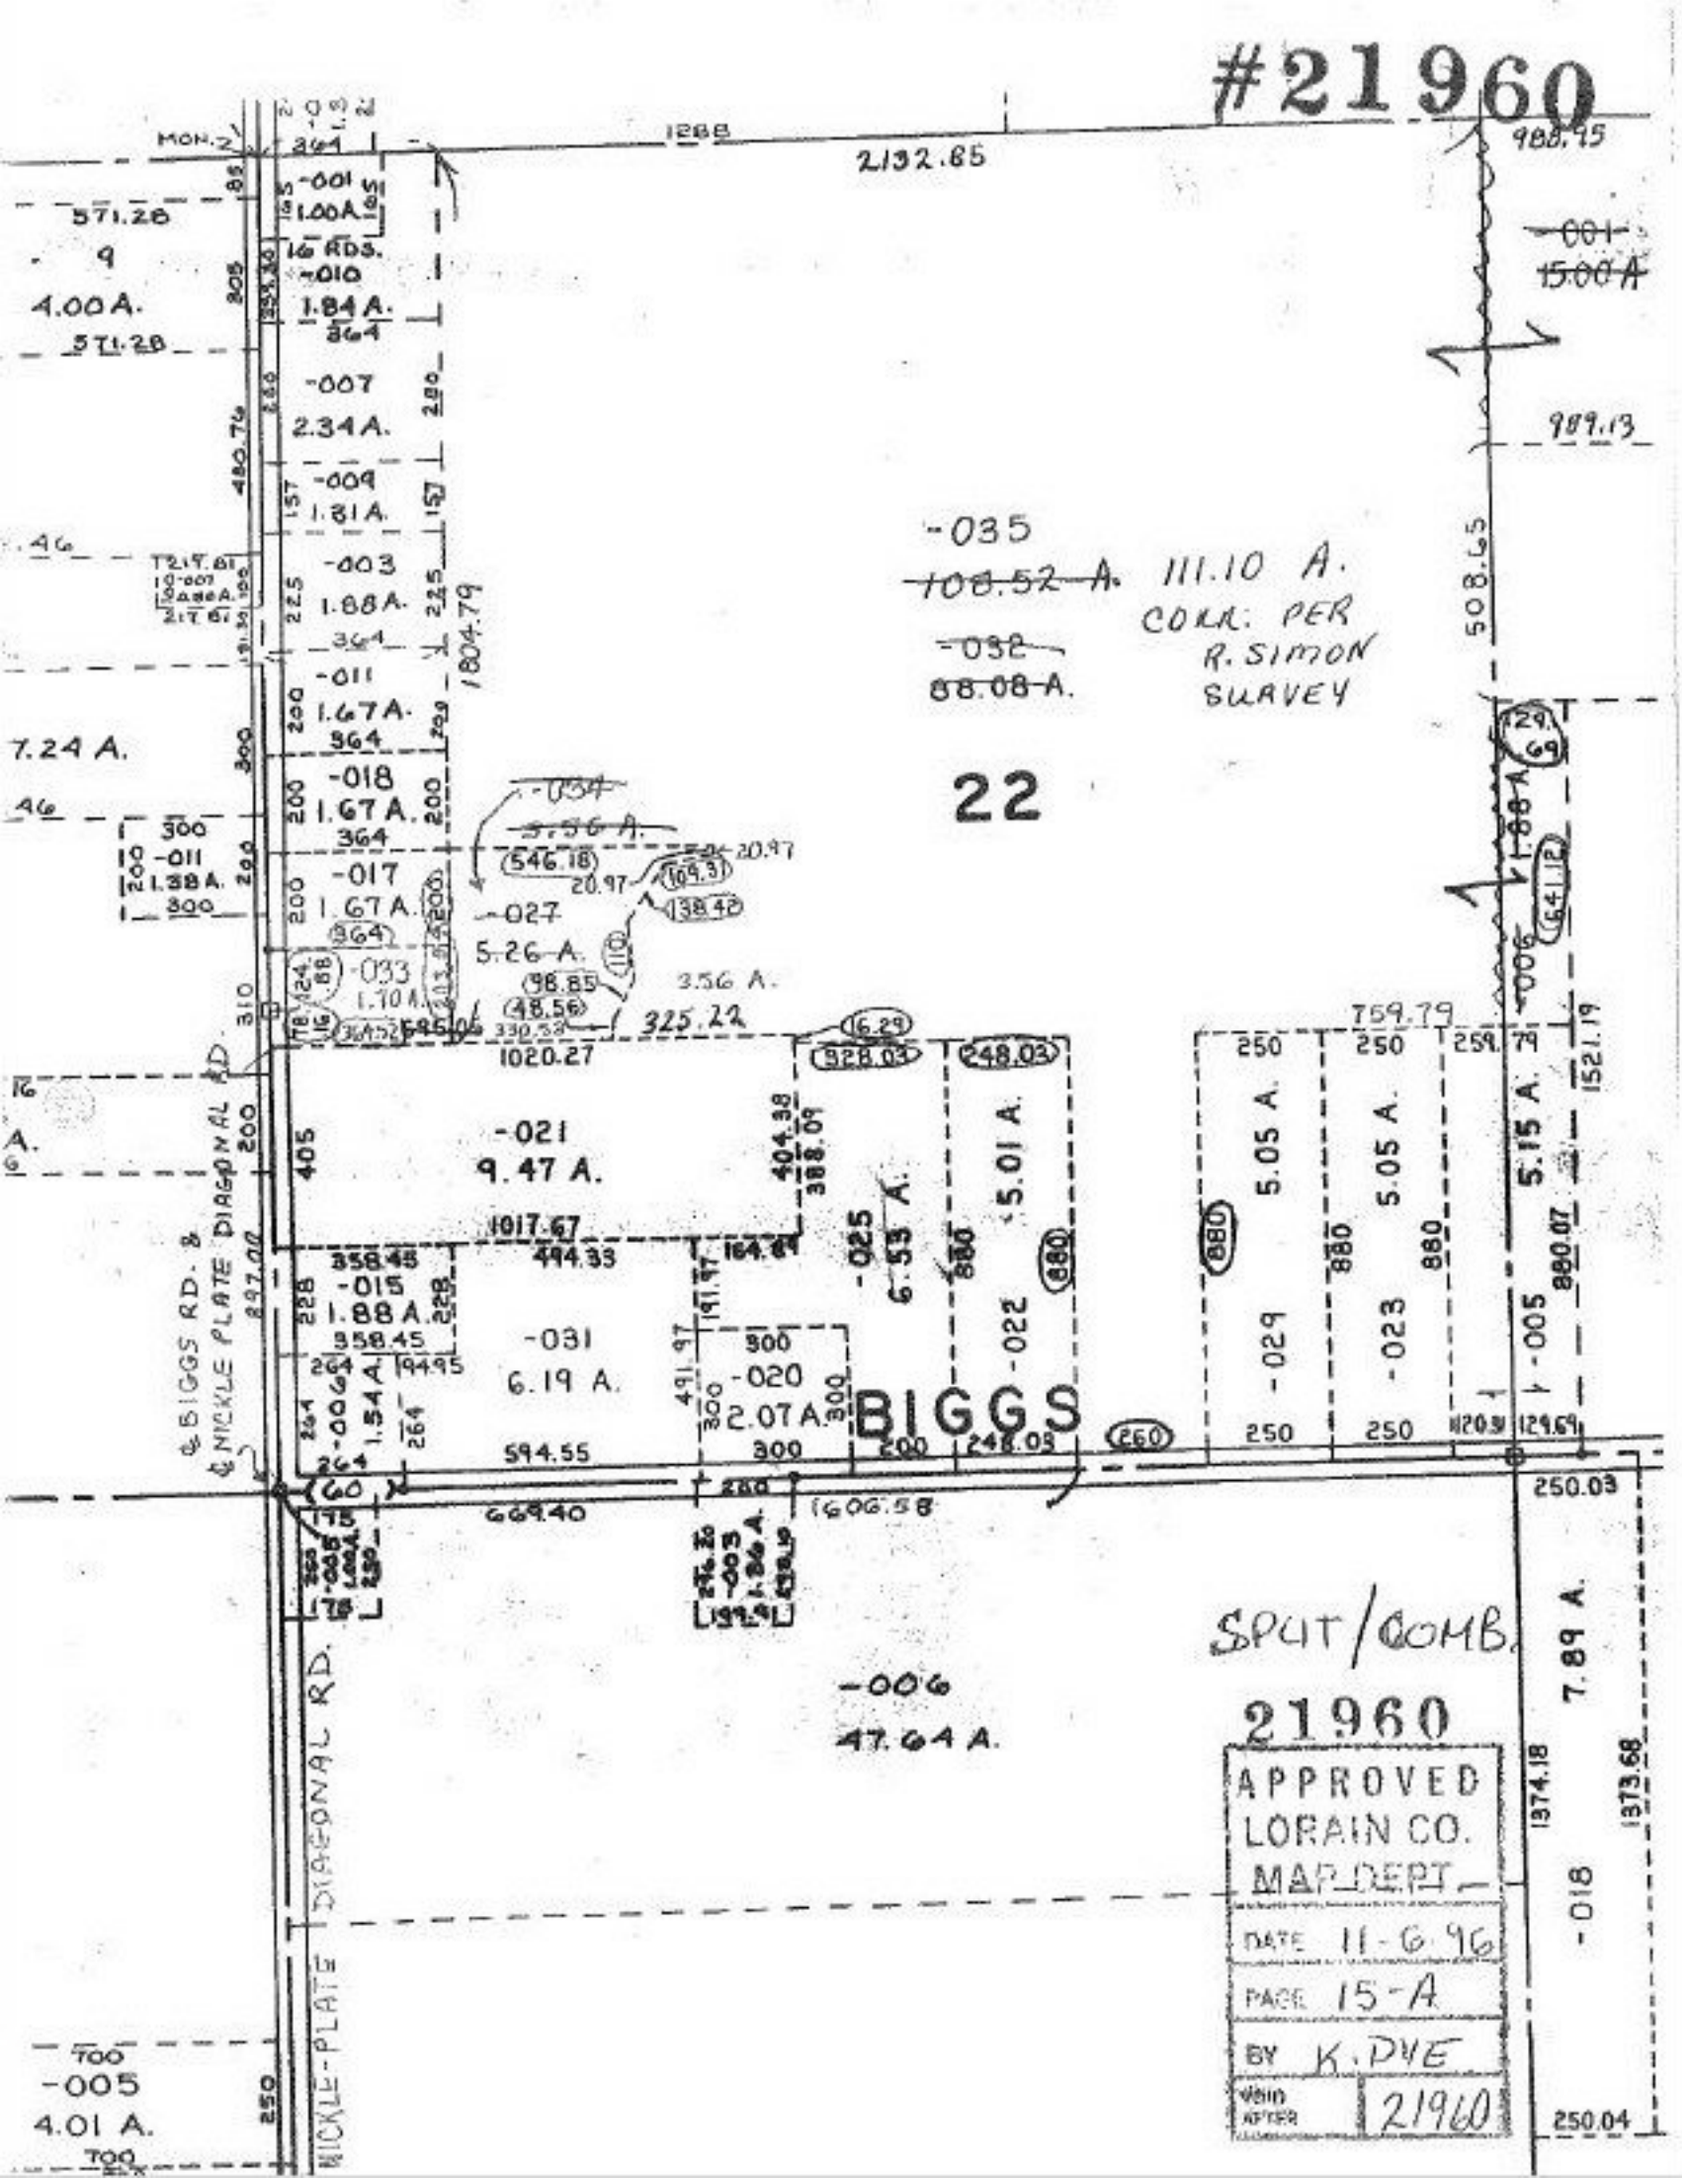
MON. N
1288
2132.85
988.95
571.26
9
4.00 A.
16 RDS.
-001
1.00 A.
-010
1.84 A.
364
-007
2.34 A.
-009
1.81 A.
-003
1.88 A.
-011
1.67 A.
364
-018
1.67 A.
364
-017
1.67 A.
364
-033
1.70 A.
7.24 A.
1804.79
-035
108.52 A.
111.10 A.
COR. PER
R. SIMON
SURVEY
-032
88.08 A.
22
-034
3.56 A.
-027
5.26 A.
3.56 A.
325.22
1020.27
-021
9.47 A.
-025
6.53 A.
-022
5.01 A.
5.05 A.
-029
5.05 A.
-023
5.15 A.
-005
-015
1.88 A.
-031
6.19 A.
-020
2.07 A.
BIGGS
-006
47.64 A.
-005
4.01 A.
-018
7.89 A.
BIGGS RD. &
NICKLE PLATE DIAGONAL RD.
NICKLE-PLATE DIAGONAL RD.
SPLIT/COMB.
21960
APPROVED
LORAIN CO.
MAP DEPT
DATE 11-6-96
PAGE 15-A
BY K. DYE
VOID AFTER 21960