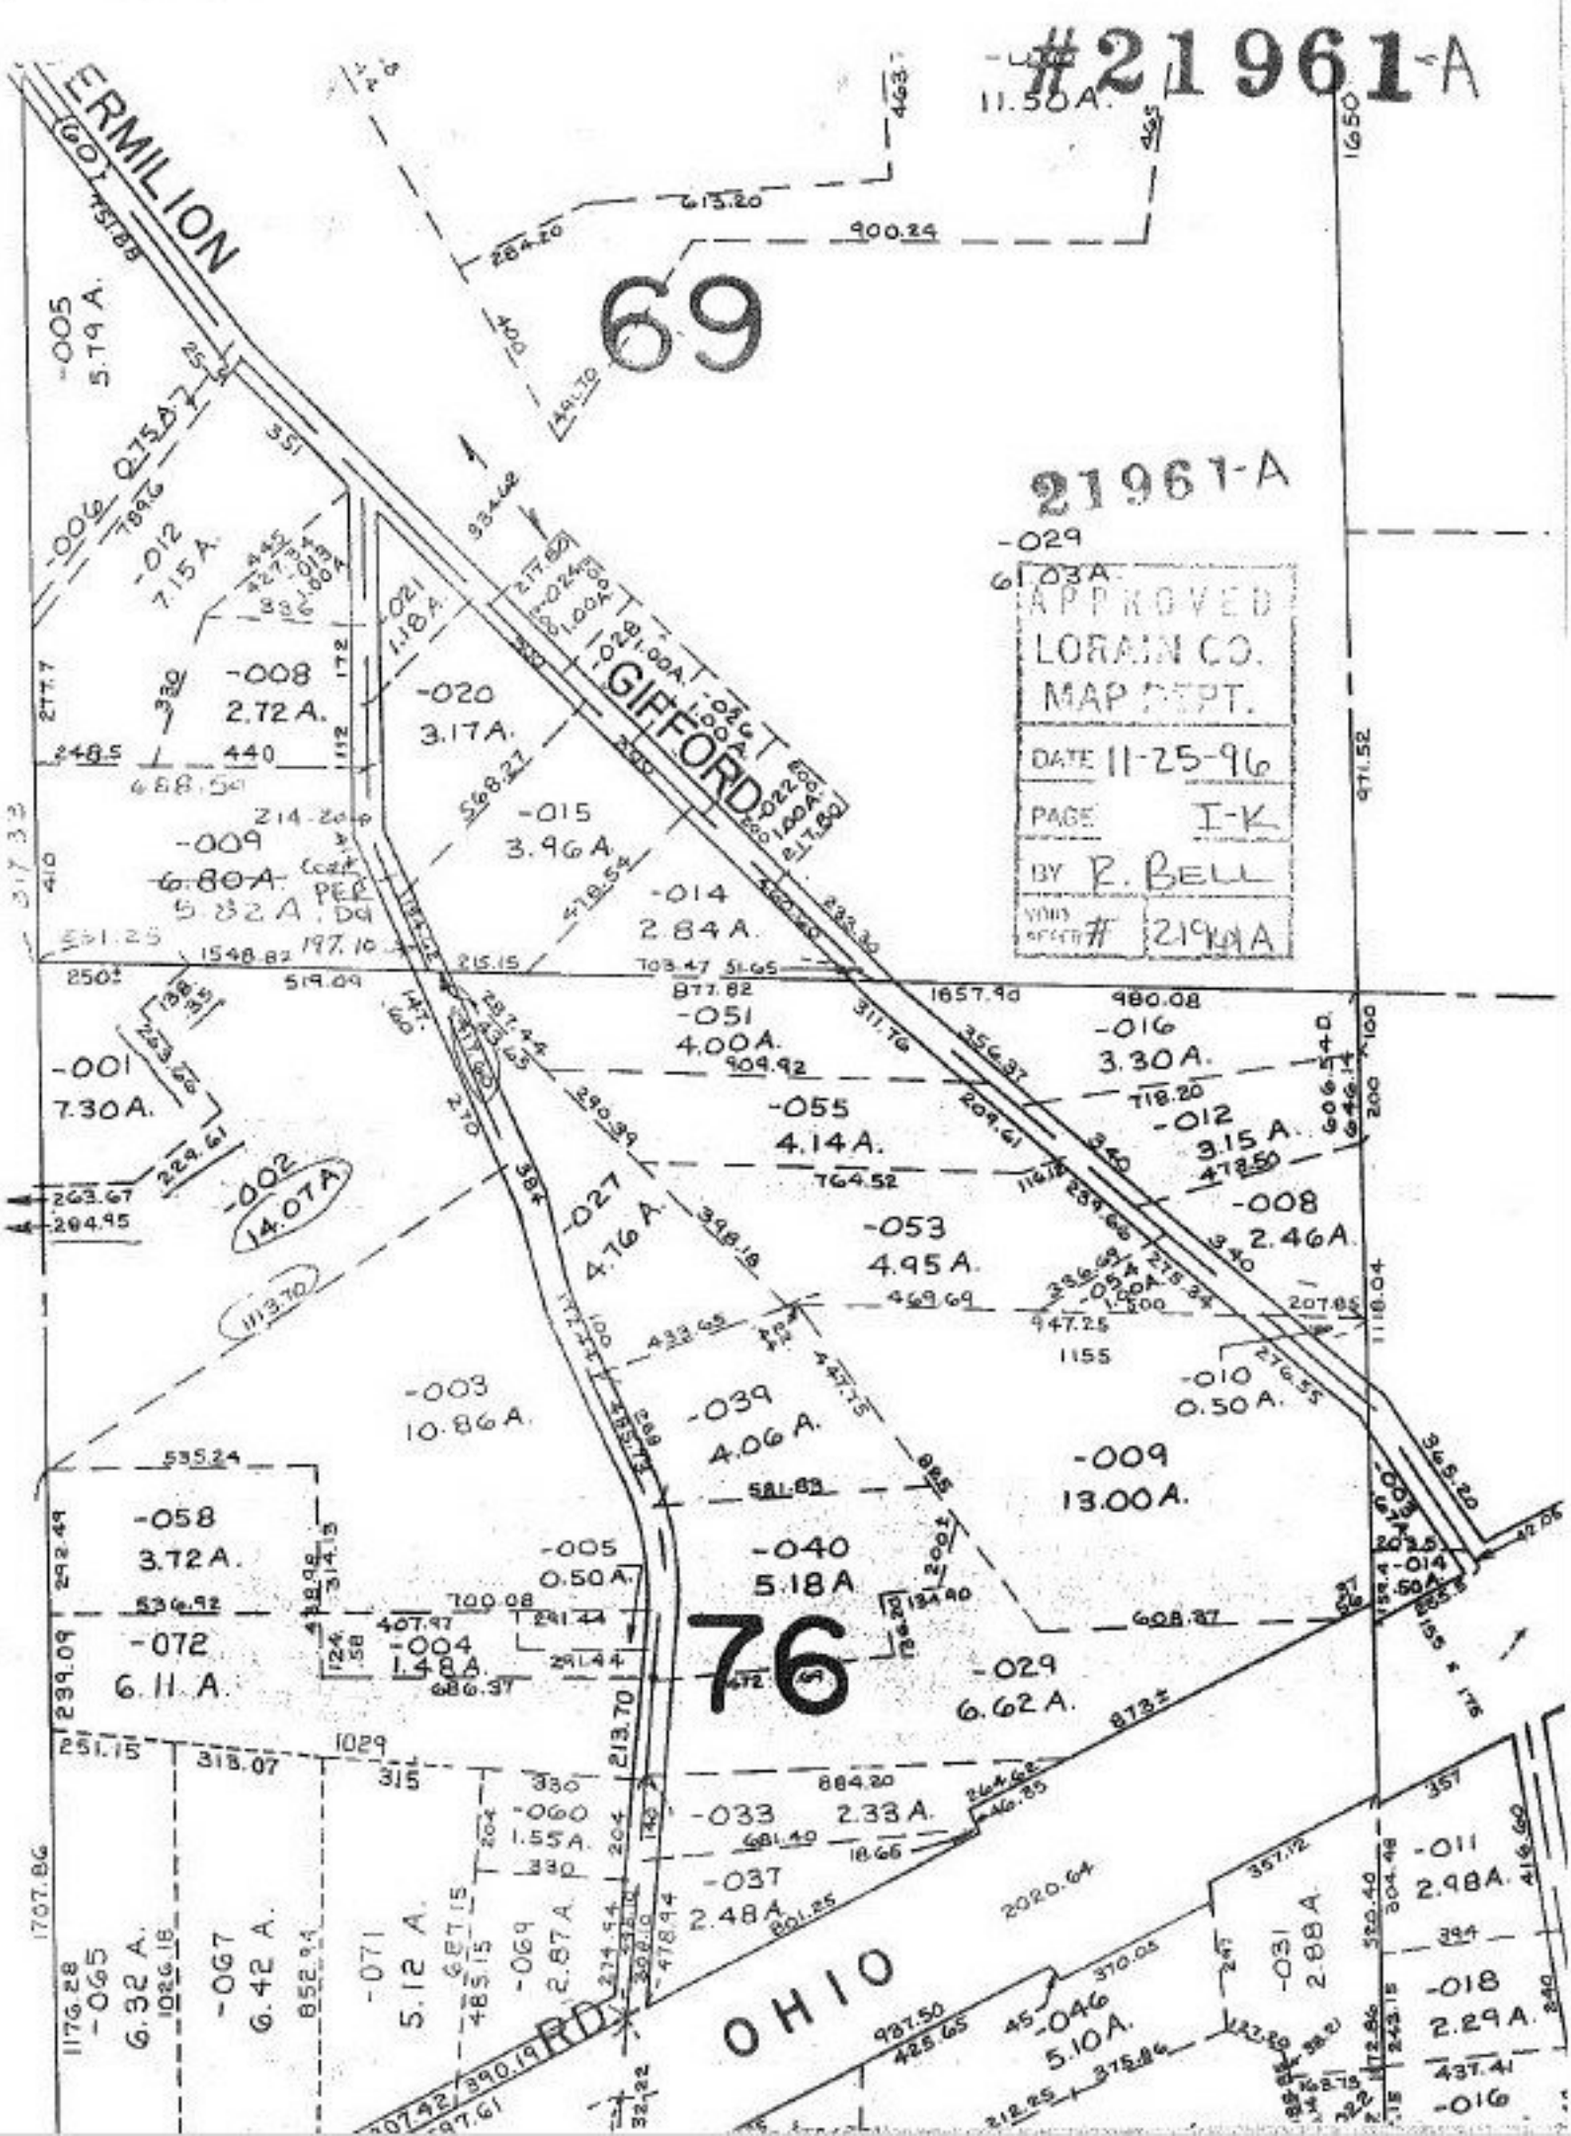
#21961-A
21961-A
APPROVED
LORAIN CO.
MAP DEPT.
DATE 11-25-96
PAGE I-K
BY R. BELL
VOID SEEDED # 21961A
69
76
ERMILION
GIFFORD
OHIO
RD
-005 5.79 A.
-006 0.75 A.
-012 7.15 A.
-008 2.72 A.
-020 3.17 A.
-021 1.18 A.
-015 3.96 A.
-009 6.80 A. 5.82 A.
-014 2.84 A.
-029 61.03 A.
-051 4.00 A.
-016 3.30 A.
-001 7.30 A.
-055 4.14 A.
-012 3.15 A.
-002 14.07 A.
-027 4.76 A.
-053 4.95 A.
-008 2.46 A.
-003 10.86 A.
-039 4.06 A.
-010 0.50 A.
-009 13.00 A.
-058 3.72 A.
-005 0.50 A.
-040 5.18 A.
-072 6.11 A.
-004 1.48 A.
-029 6.62 A.
-060 1.55 A.
-033 2.33 A.
-037 2.48 A.
-065 6.32 A.
-067 6.42 A.
-071 5.12 A.
-069 2.87 A.
-046 5.10 A.
-031 2.88 A.
-011 2.98 A.
-018 2.29 A.
-016