#21961-A

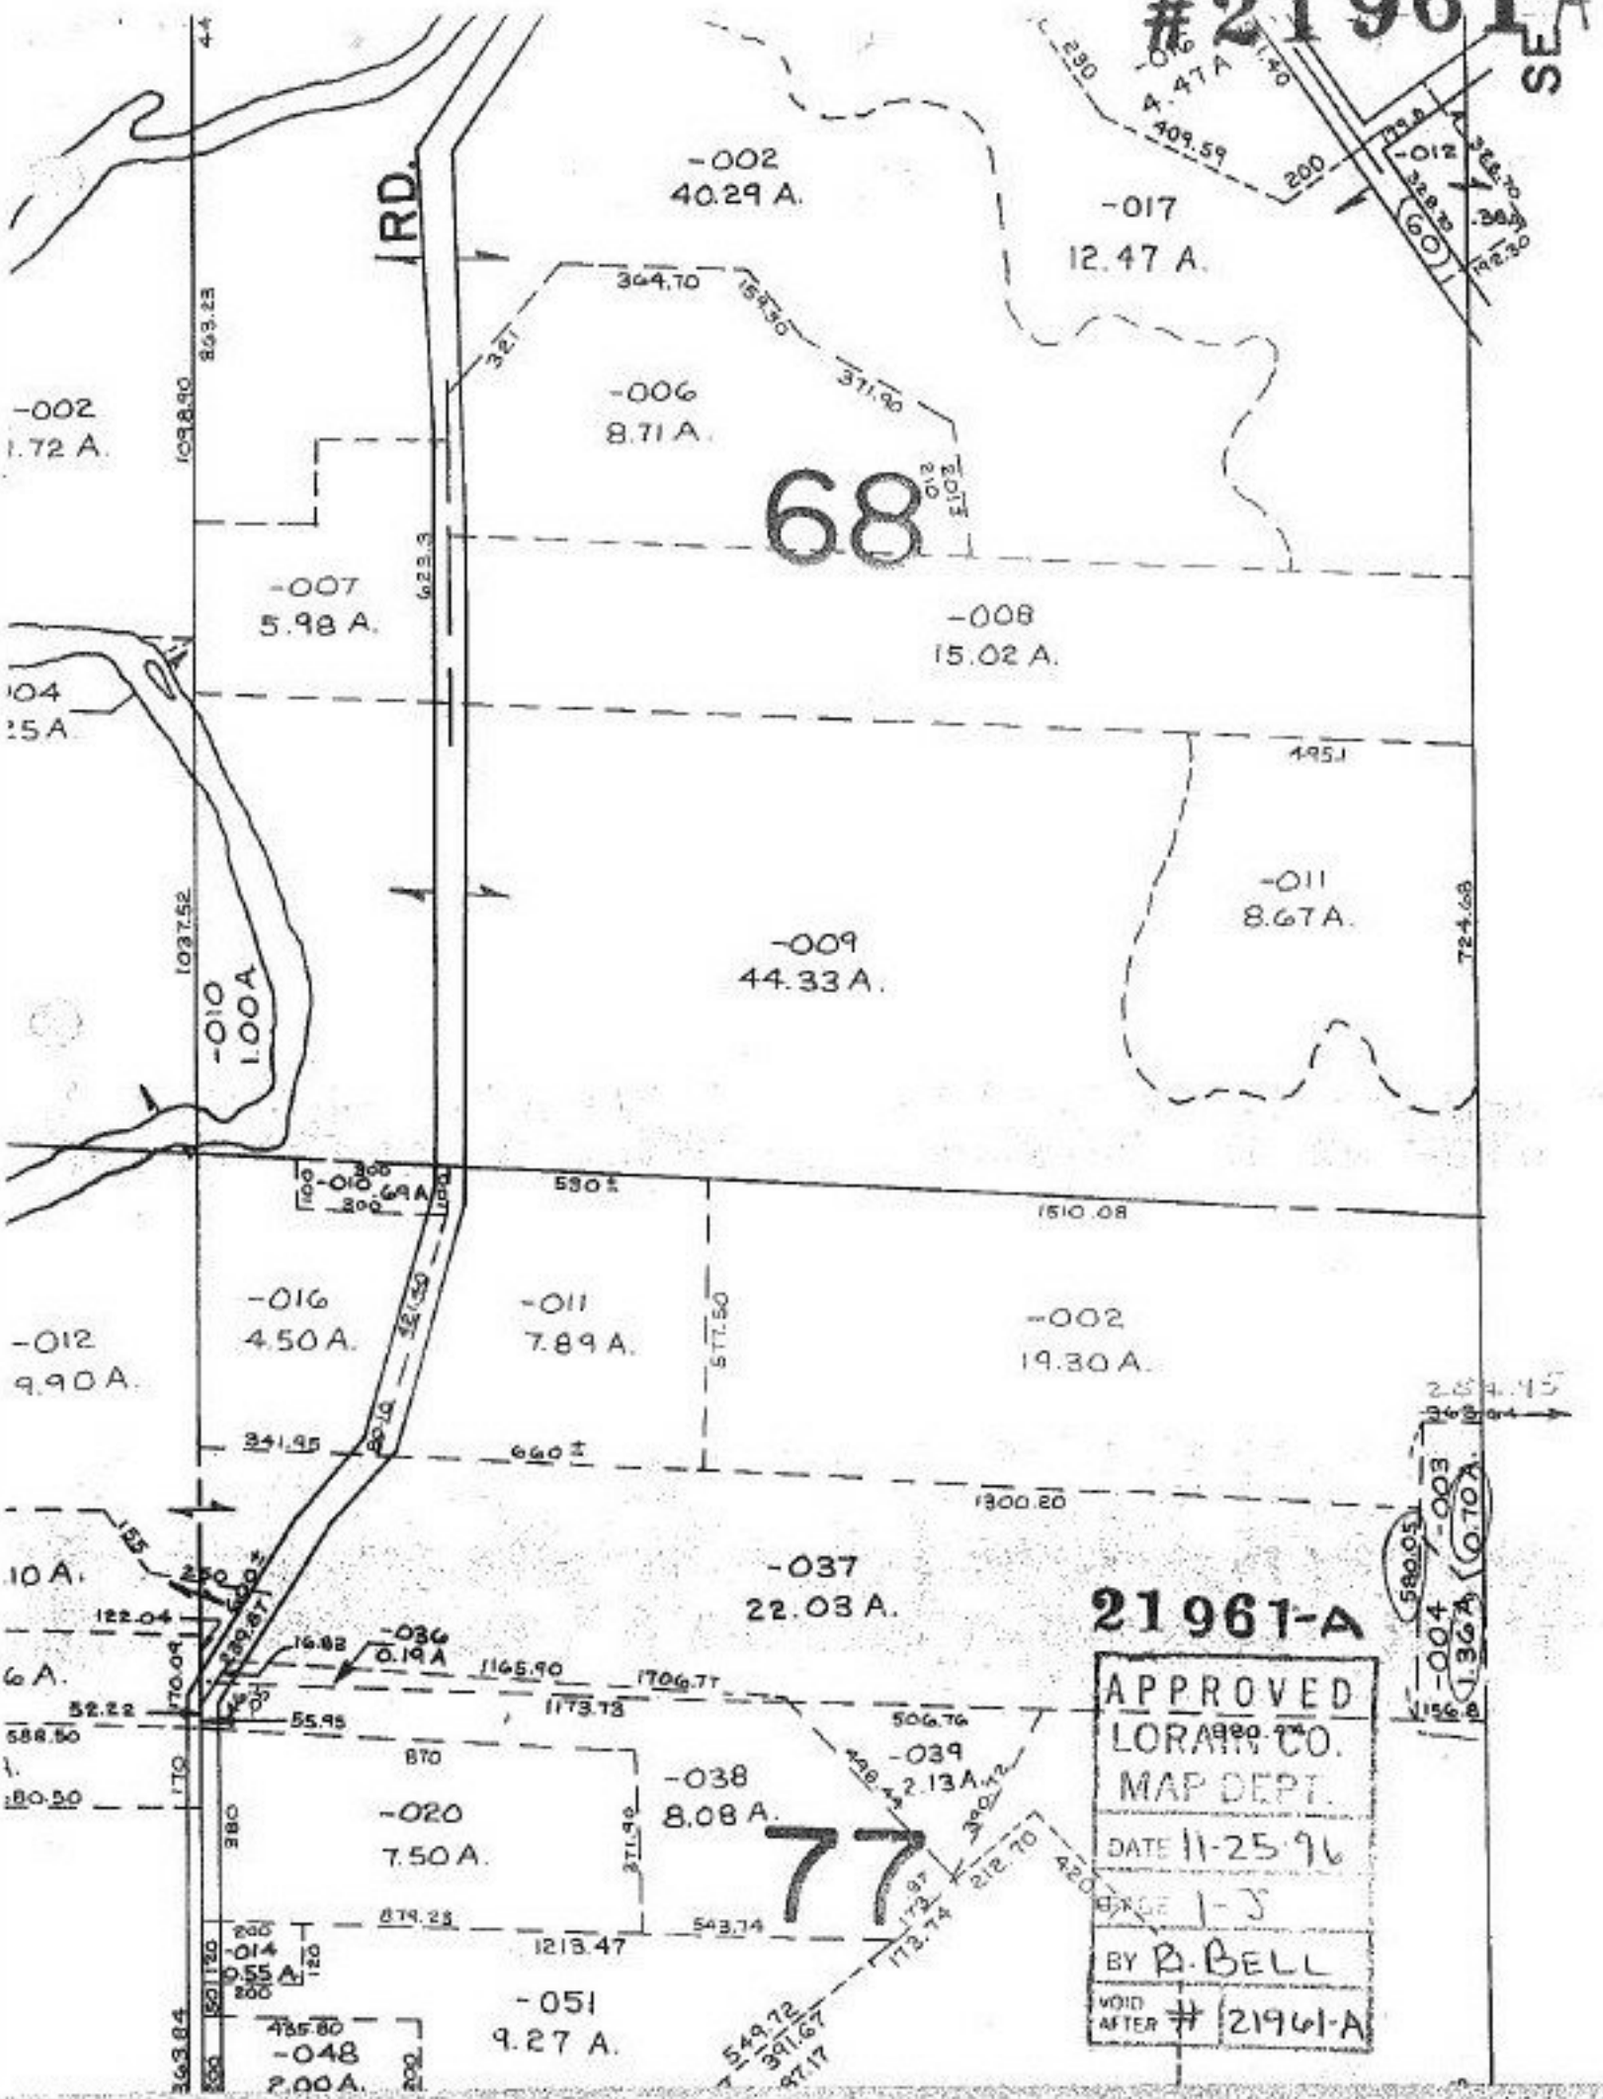
RD.
-002
40.29 A.
-017
12.47 A.
-006
8.71 A.
68
-007
5.98 A.
-008
15.02 A.
-009
44.33 A.
-011
8.67 A.
-010
1.00 A.
-016
4.50 A.
-011
7.89 A.
-002
19.30 A.
-012
9.90 A.
-037
22.03 A.
-036
0.19 A
-020
7.50 A.
-038
8.08 A.
77
-039
2.13 A.
-014
0.55 A.
-051
9.27 A.
-048
2.00 A.
-003
0.70 A.
-004
1.36 A.
21961-A
APPROVED
LORAIN CO.
MAP DEPT.
DATE 11-25-96
BY R. BELL
VOID AFTER # 21961-A