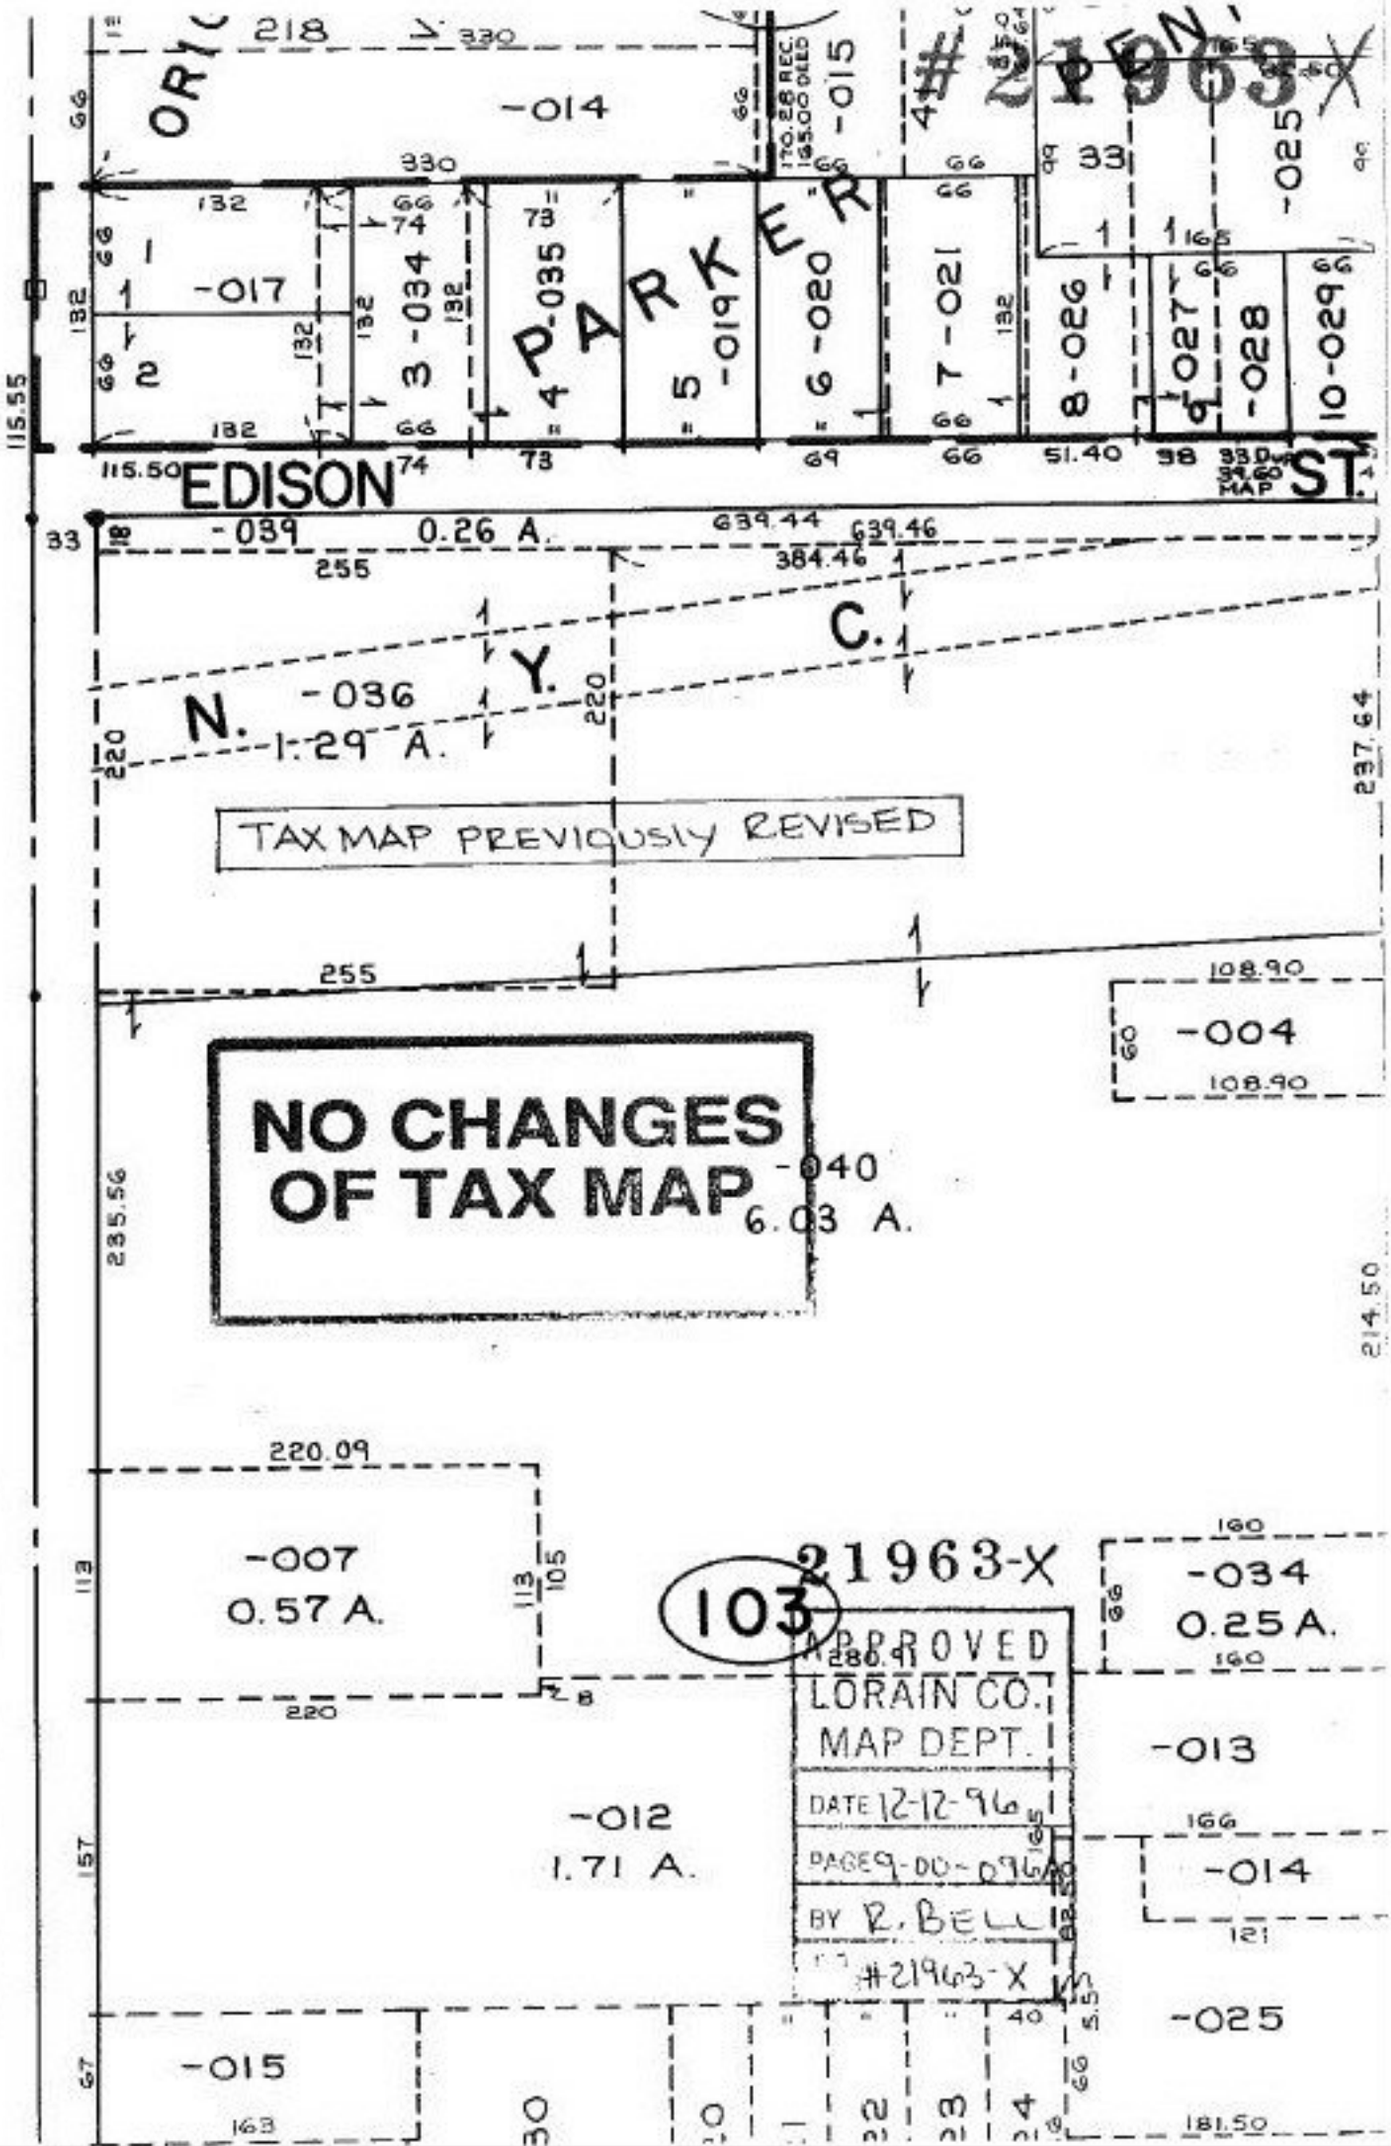
ORIG
218
330
-014
-015
#21963-X
PENN
-025
33
132
74
73
-017
-034
-035
PARKER
-019
-020
-021
-026
-027
-028
-029
115.55
115.50
EDISON
ST.
-039
0.26 A.
639.44
639.46
384.46
255
C.
Y.
N.
-036
1.29 A.
220
237.64
TAX MAP PREVIOUSLY REVISED
108.90
-004
NO CHANGES
OF TAX MAP
-040
6.03 A.
235.56
214.50
220.09
-007
0.57 A.
113
105
103
21963-X
APPROVED
LORAIN CO.
MAP DEPT.
DATE 12-12-96
PAGE 9-00-096
BY R. BELL
#21963-X
280.91
-034
0.25 A.
160
-013
166
-014
121
-012
1.71 A.
157
-025
-015
163
181.50
SEE 9-00-095-B