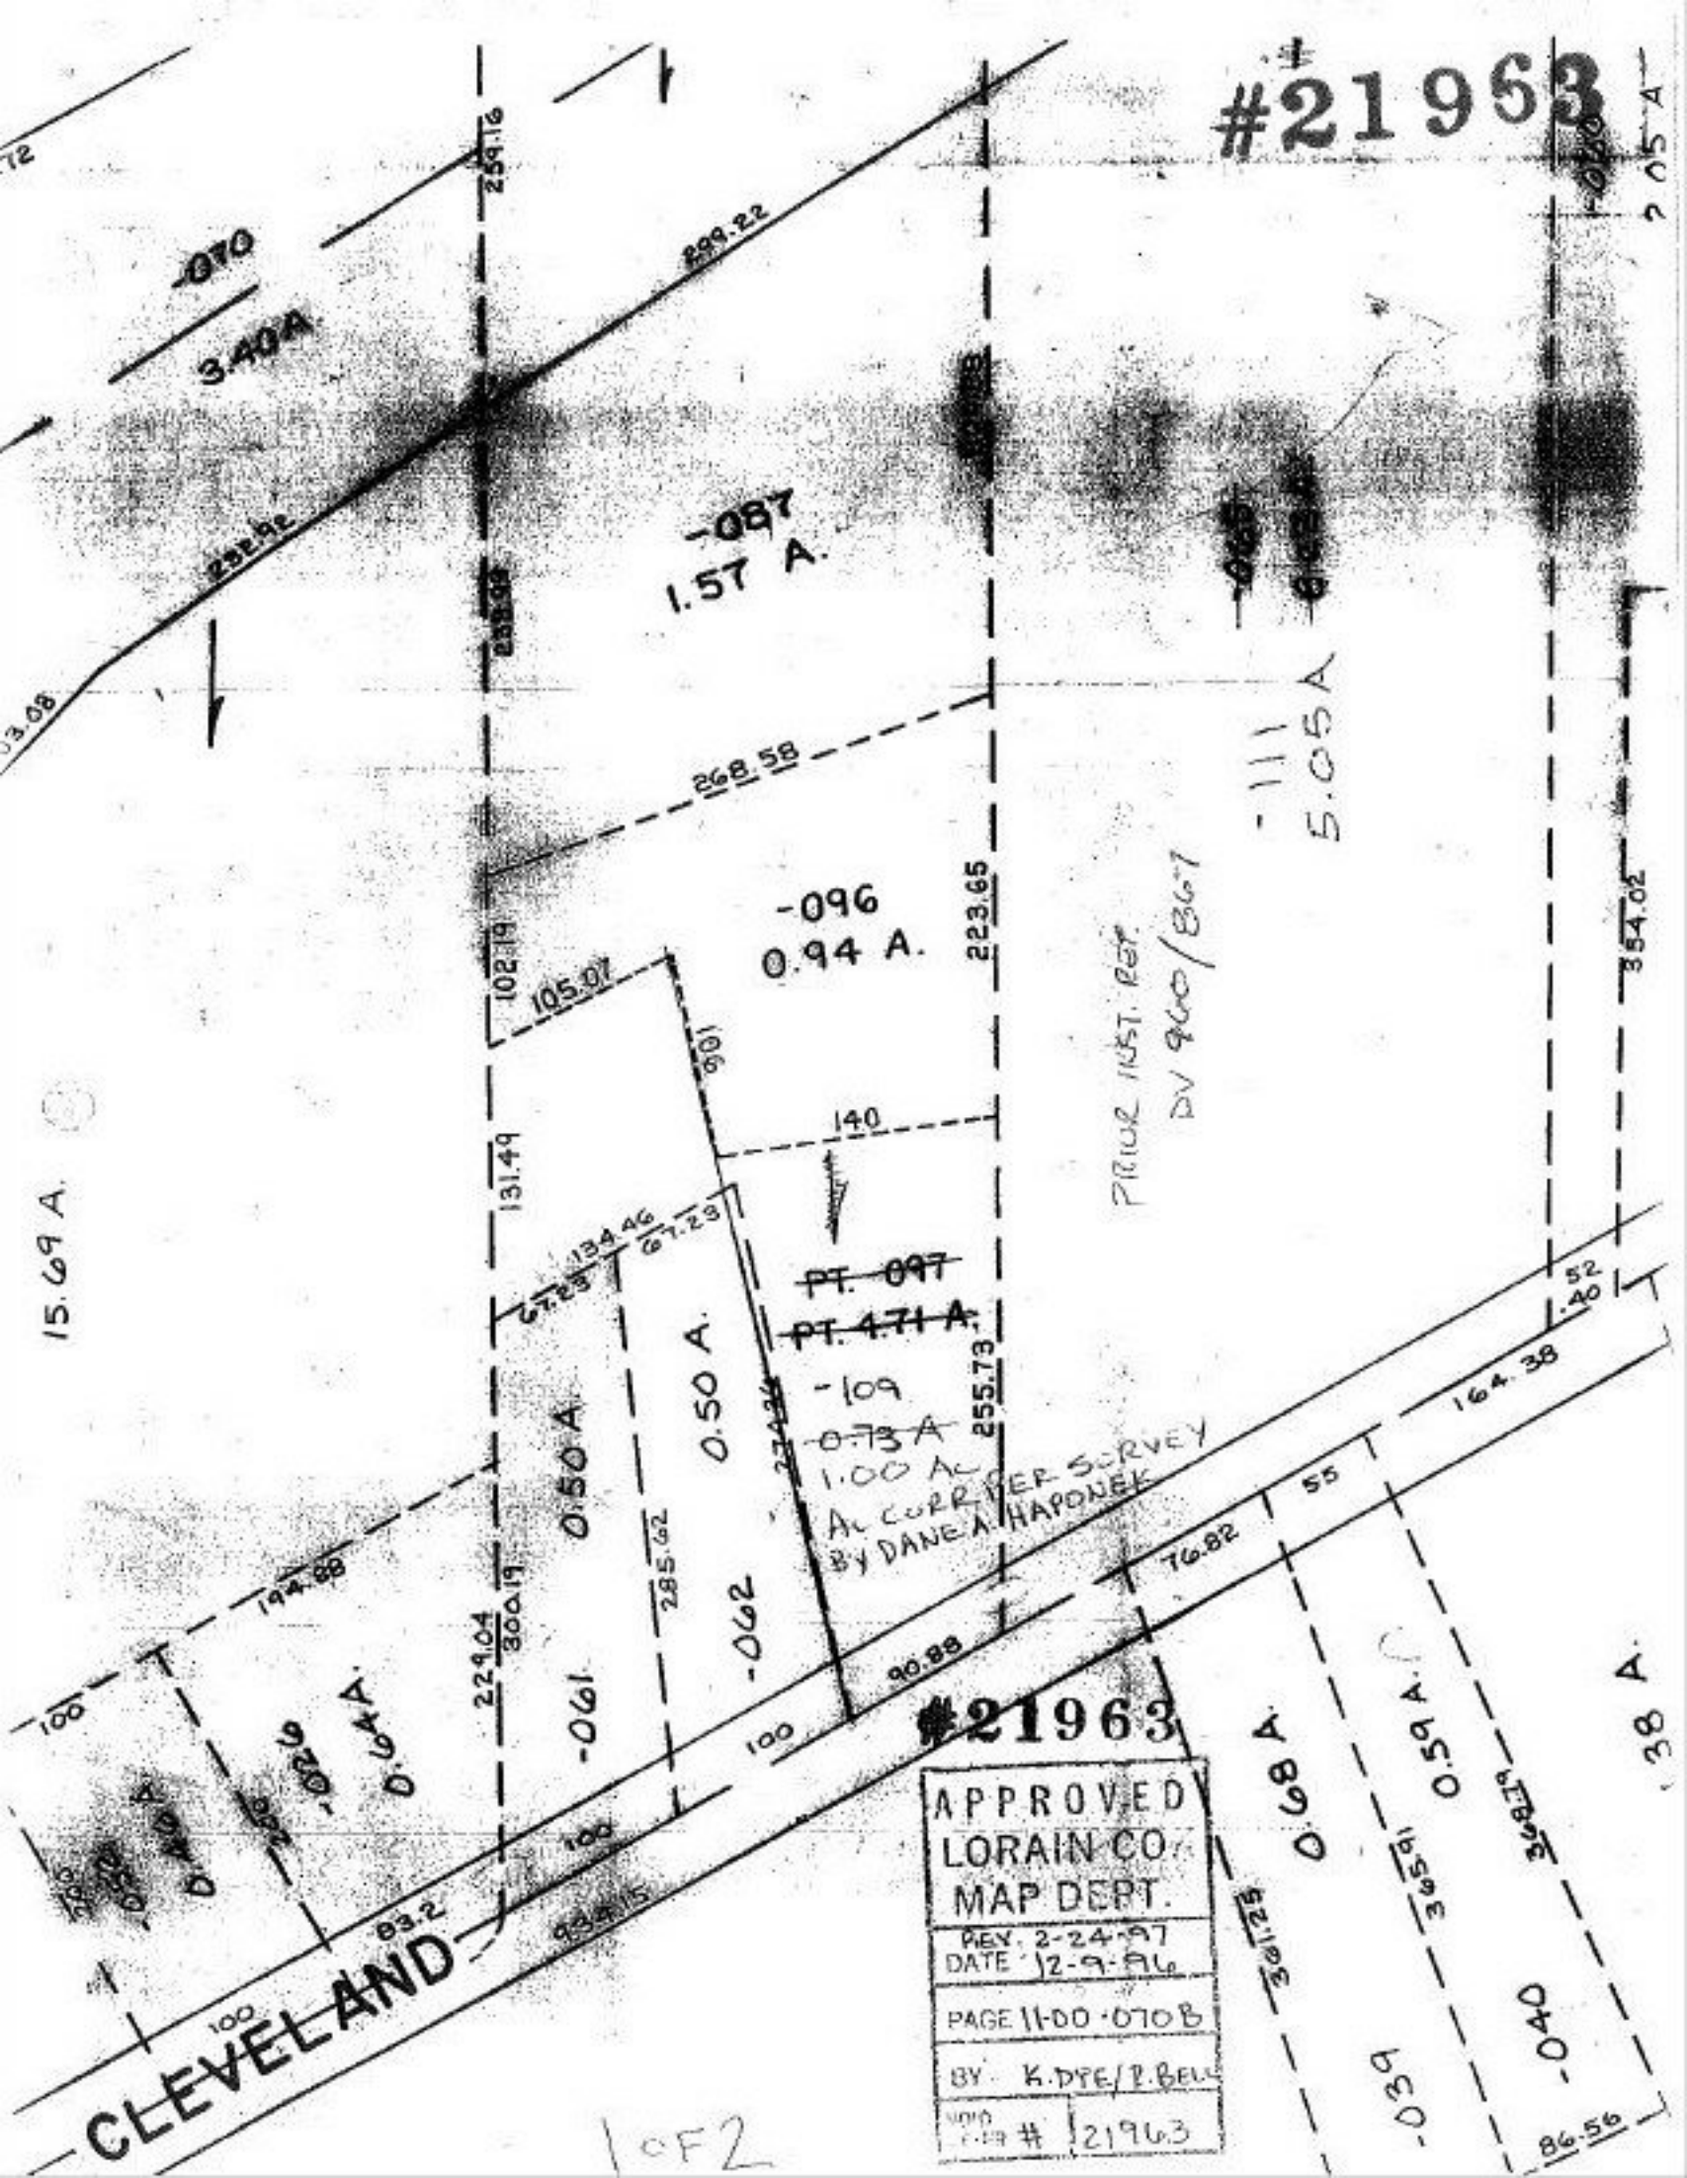
#21963
-070
3.40A
259.16
299.22
-087
1.57 A.
-111
5.05A
268.58
-096
0.94 A.
223.65
105.07
102.19
131.49
140
PT. 097
PT. 4.71 A.
-109
0.73A
1.00 Ac
AS CORRECTED SURVEY
BY DANE A. HAPONEK
255.73
0.50 A.
0.50 A.
-062
-061
-029
0.64A.
0.40 A.
CLEVELAND
#21963
APPROVED
LORAIN CO.
MAP DEPT.
REV. 2-24-97
DATE 12-9-96
PAGE 11-00-070B
BY K.DYE/P.BELL
VOID FILE # 21963
1 OF 2