#21964

DETAIL

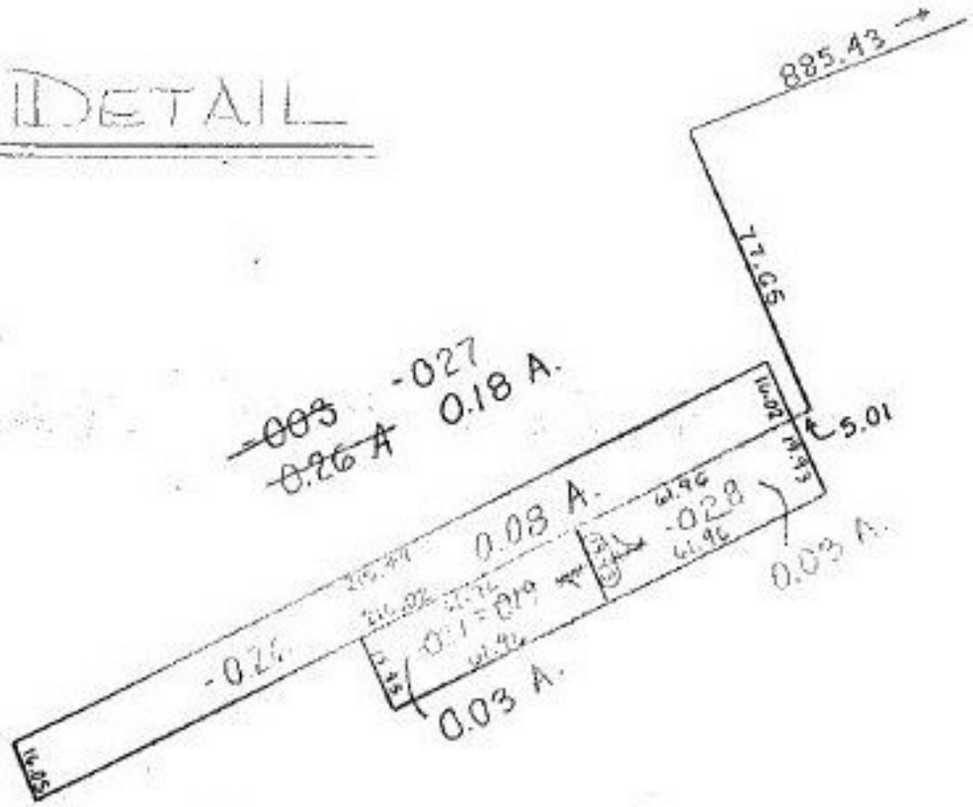

21964

APPROVED
LORAIN CO.
MAP DEPT.

DATE 11-6-96

PARCEL 500 042 B

BY K. DYE

VOID AFTER # 21964