SEE 5-00-041-B

#21964

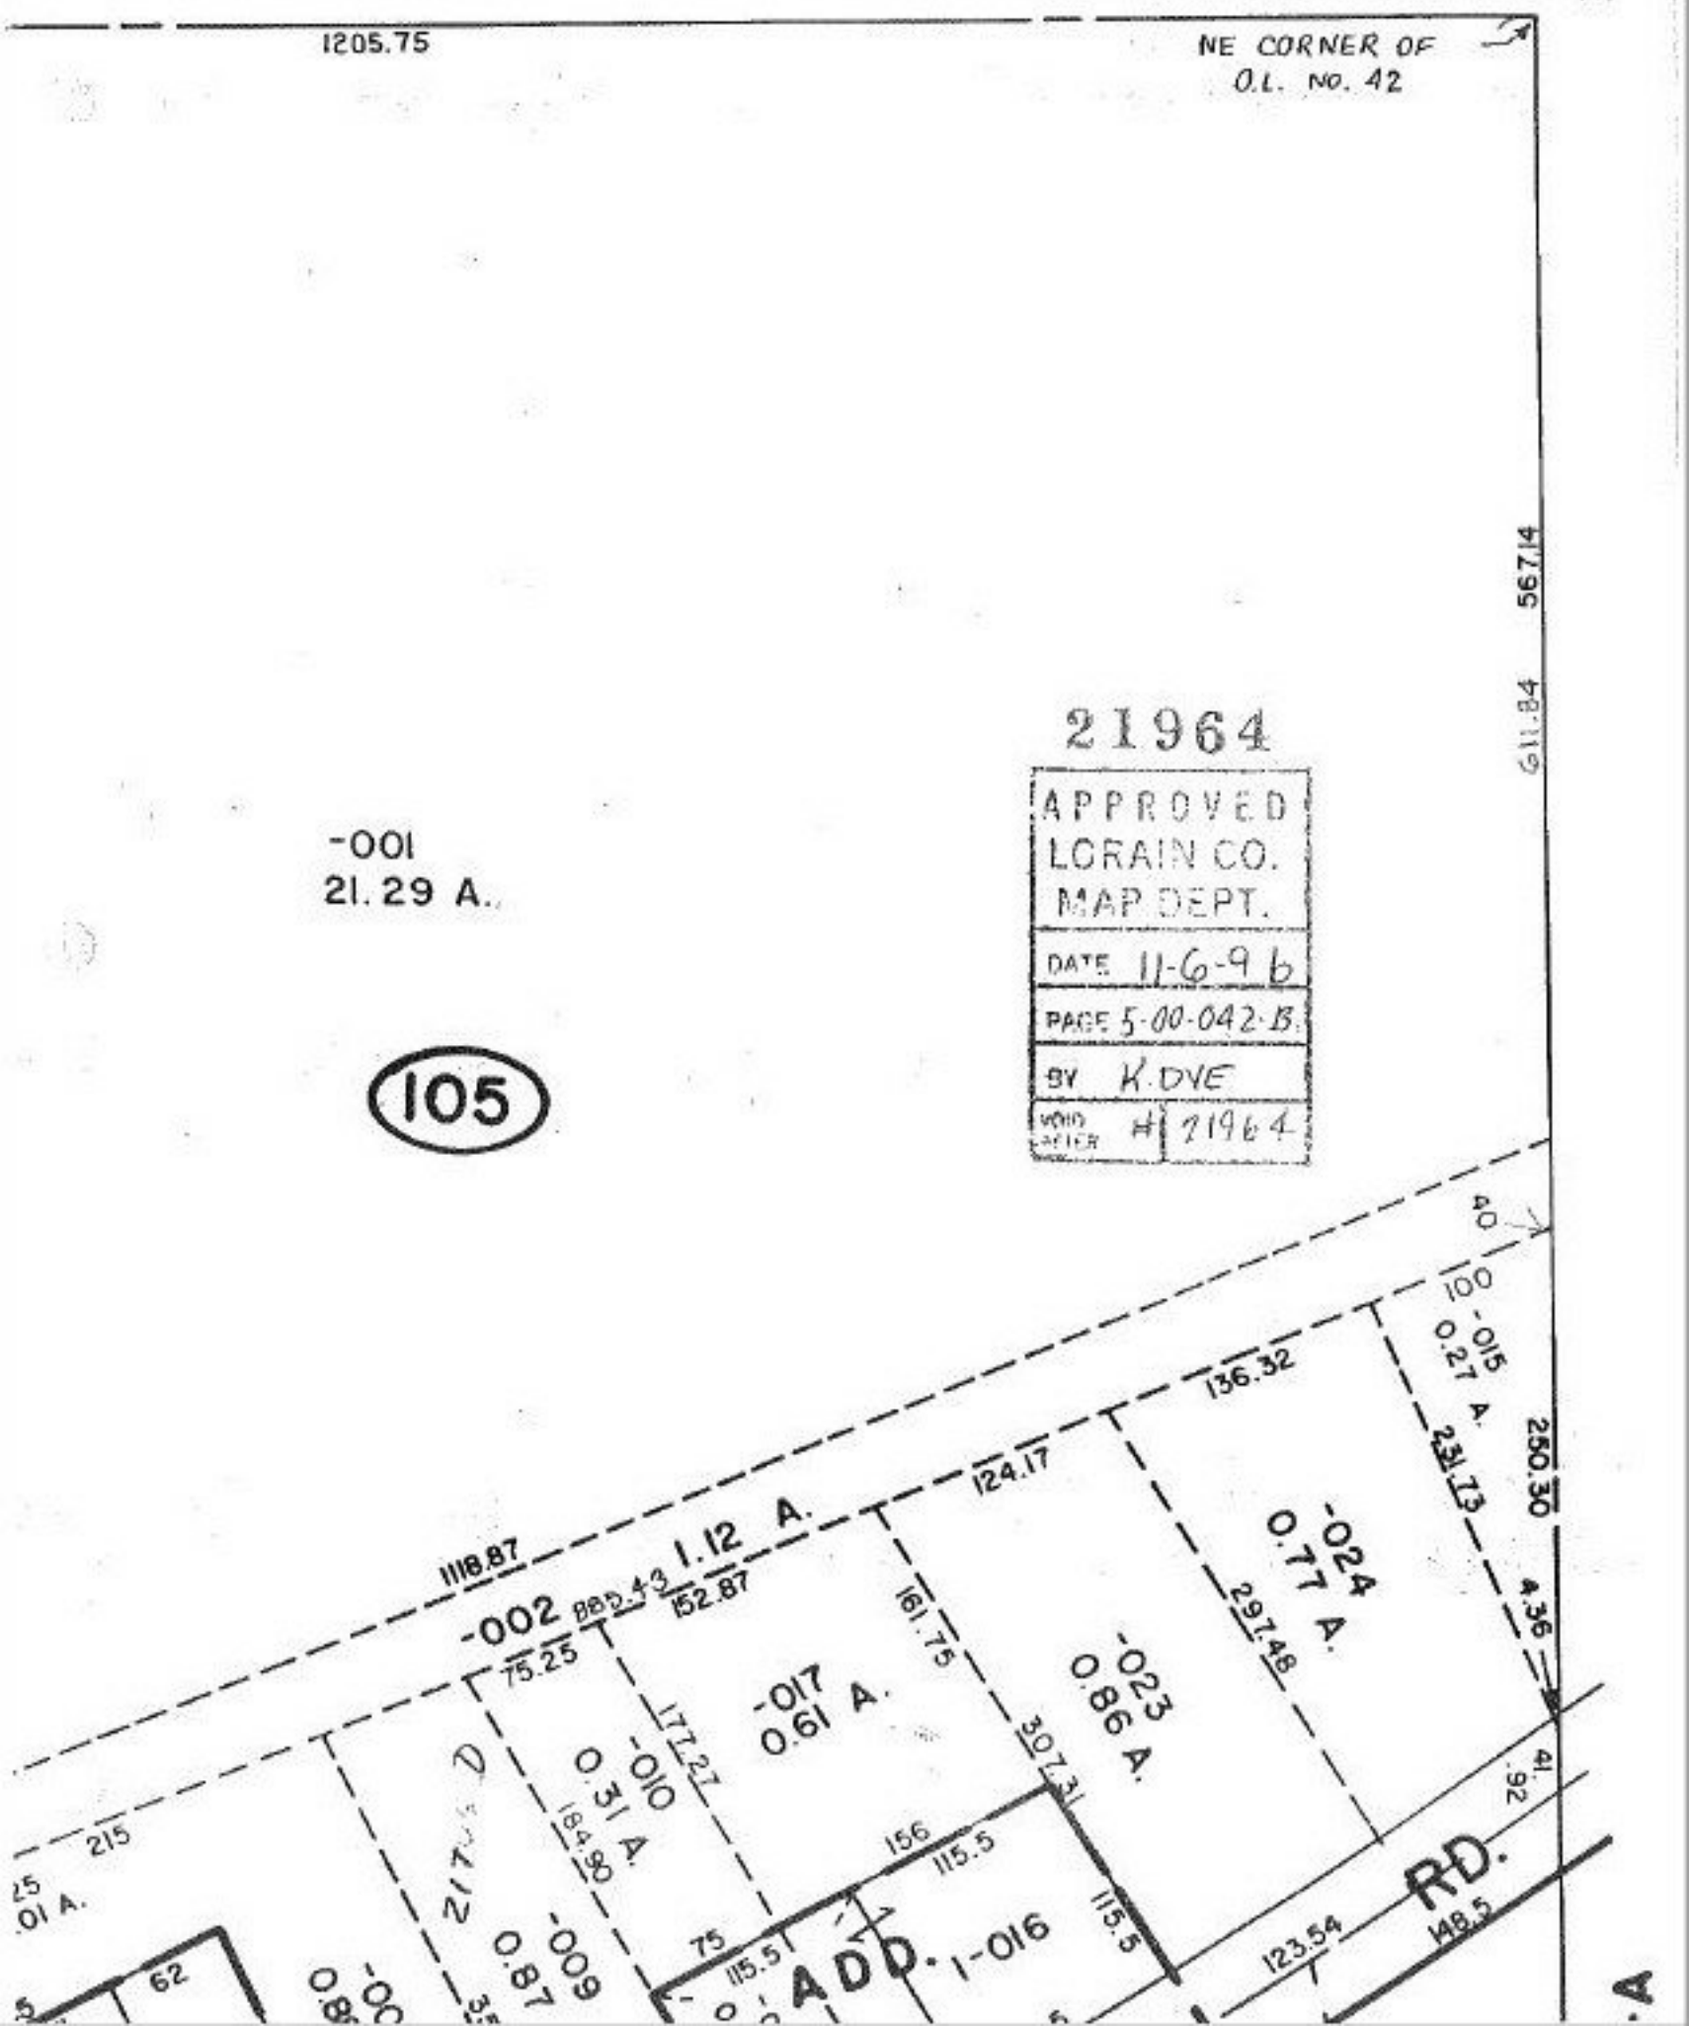

21964

APPROVED
LORAIN CO.
MAP DEPT.

DATE 11-6-96

PAGE 5-00-042-B

BY K.DVE

VOID AFTER # 21964