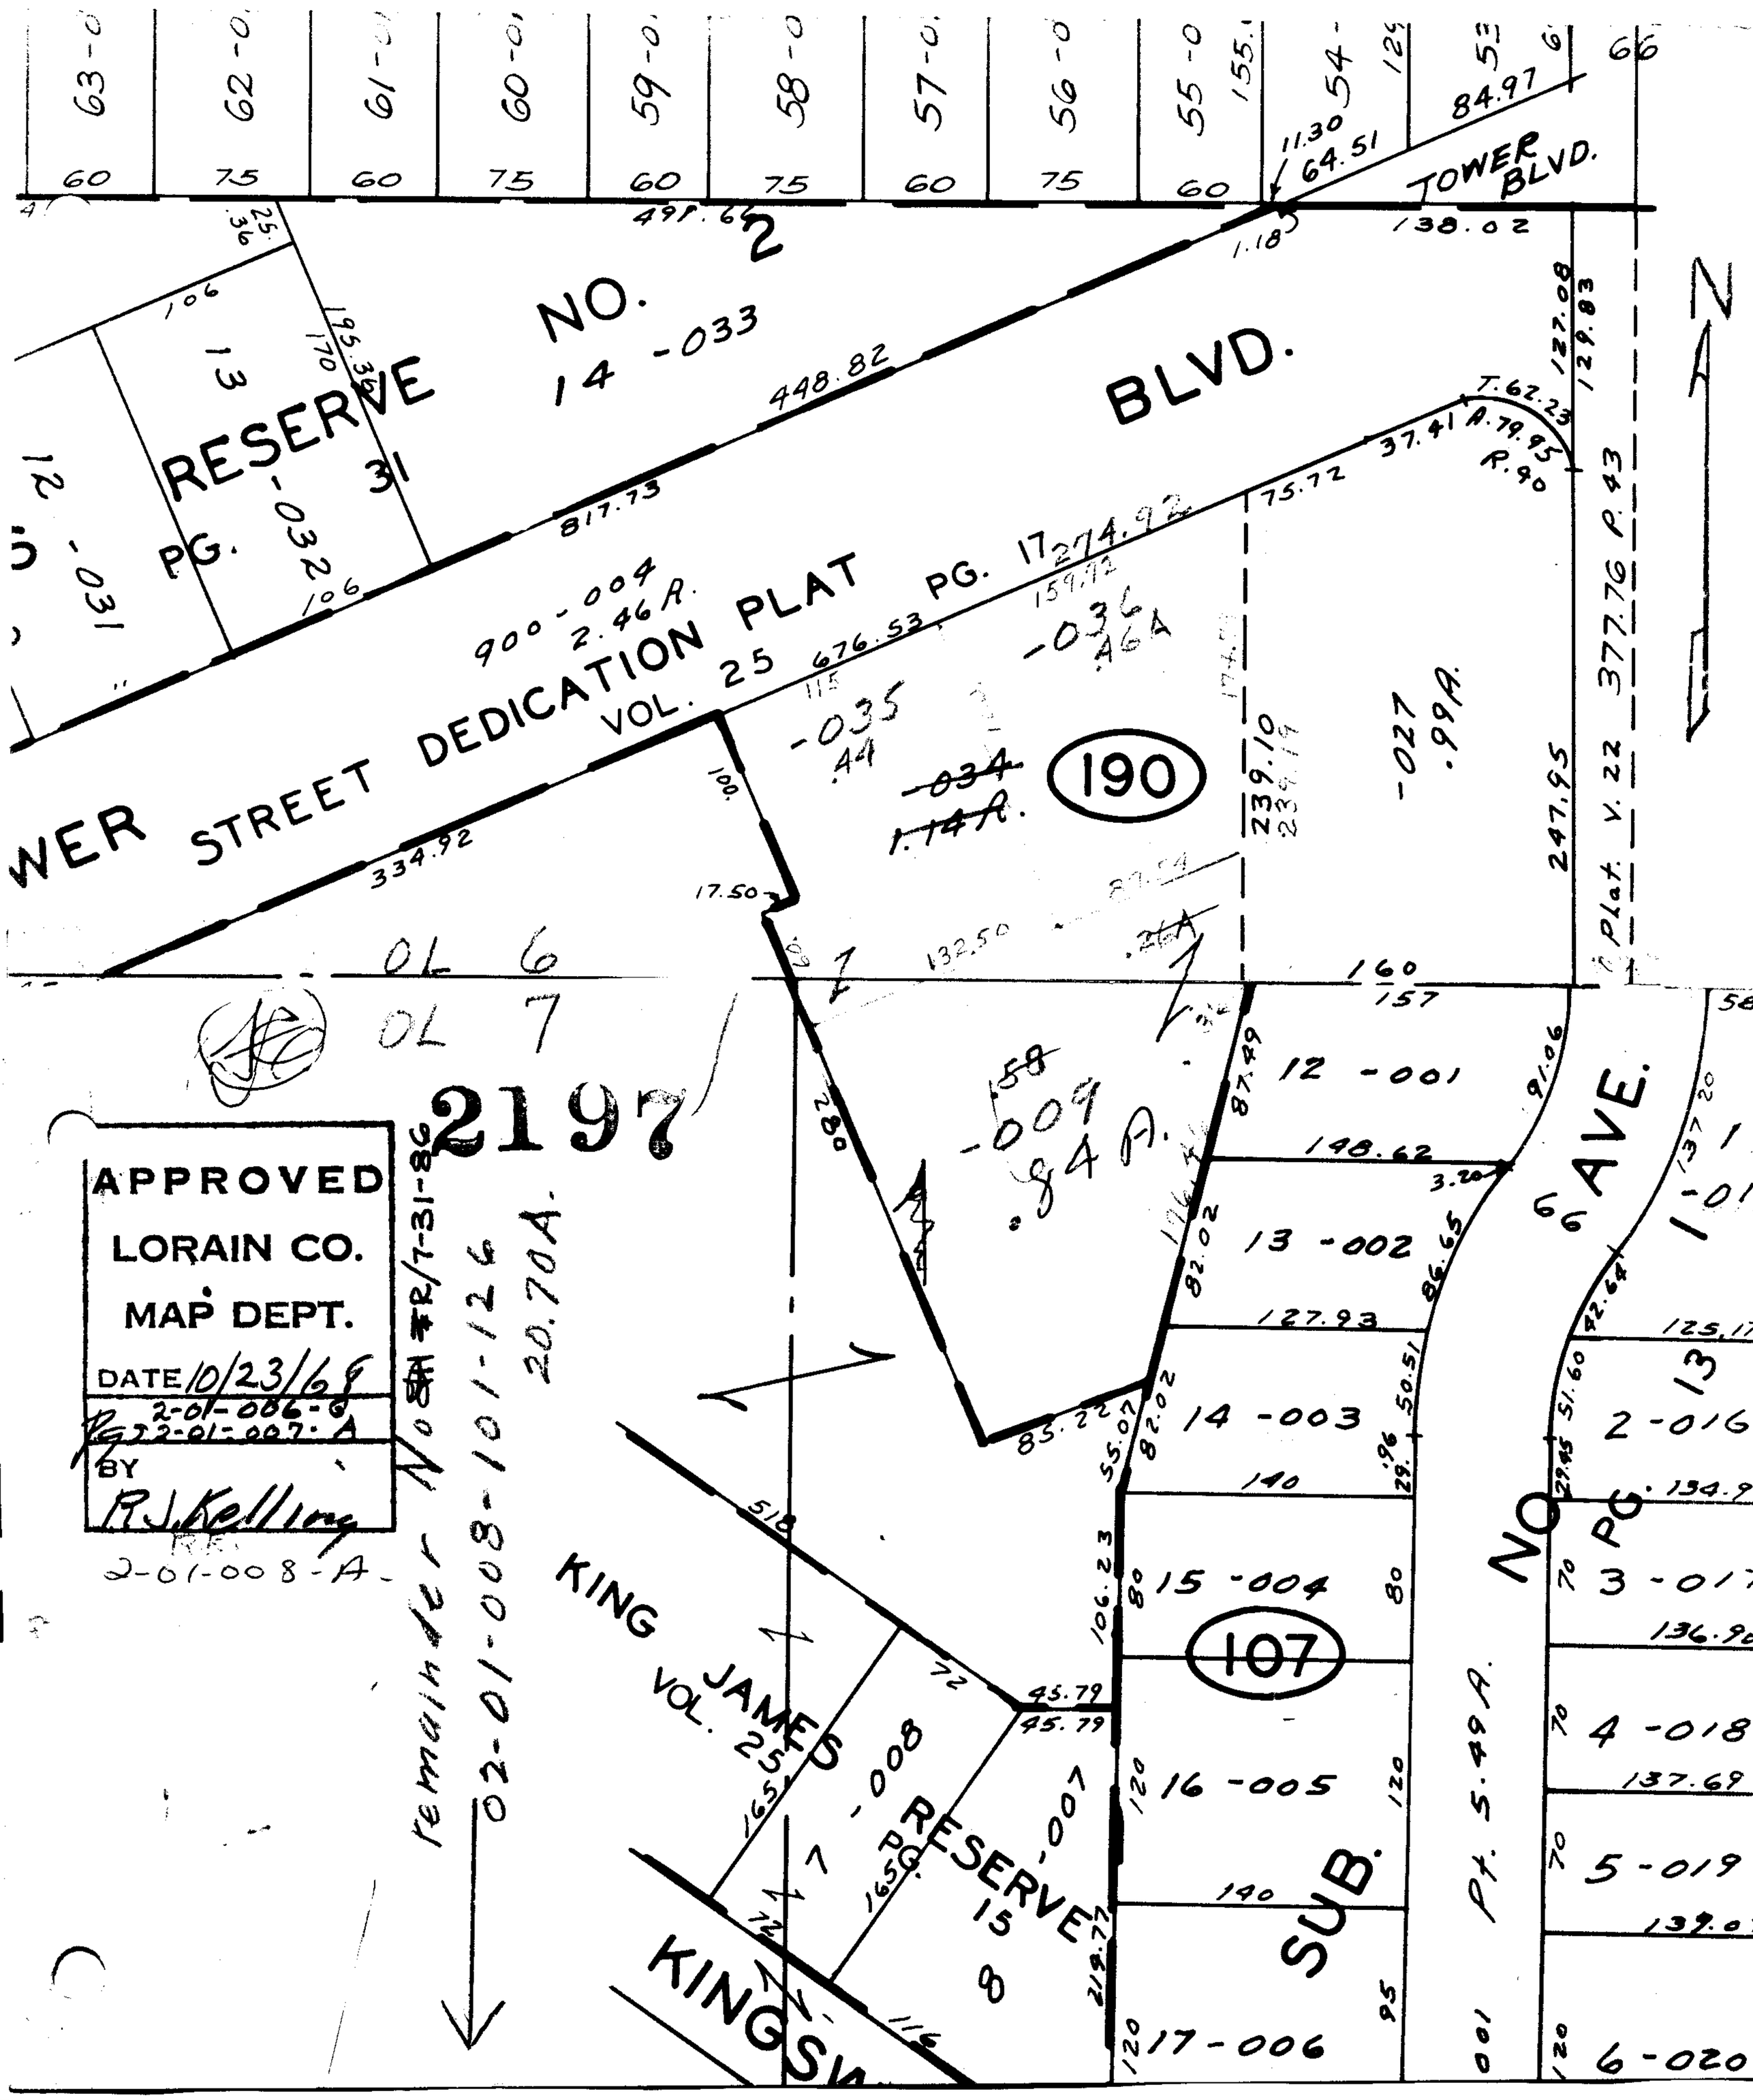
TOWER BLVD.
BLVD.
RESERVE NO. 14 -033
RESERVE -032
PG.
TOWER STREET DEDICATION PLAT
VOL. 25 PG. 17
KING JAMES
VOL. 25
KINGSW
RESERVE
SUB.
NO
AVE.
APPROVED
LORAIN CO.
MAP DEPT.
DATE 10/23/68
2-01-006-G
2-01-007-A
BY
R.J. Kelling
2-01-008-A
2197
REMAINDER
02-01-008-101-126
20.70A.
190
107
12 -001
13 -002
14 -003
15 -004
16 -005
17 -006
2-016
3-017
4-018
5-019
6-020