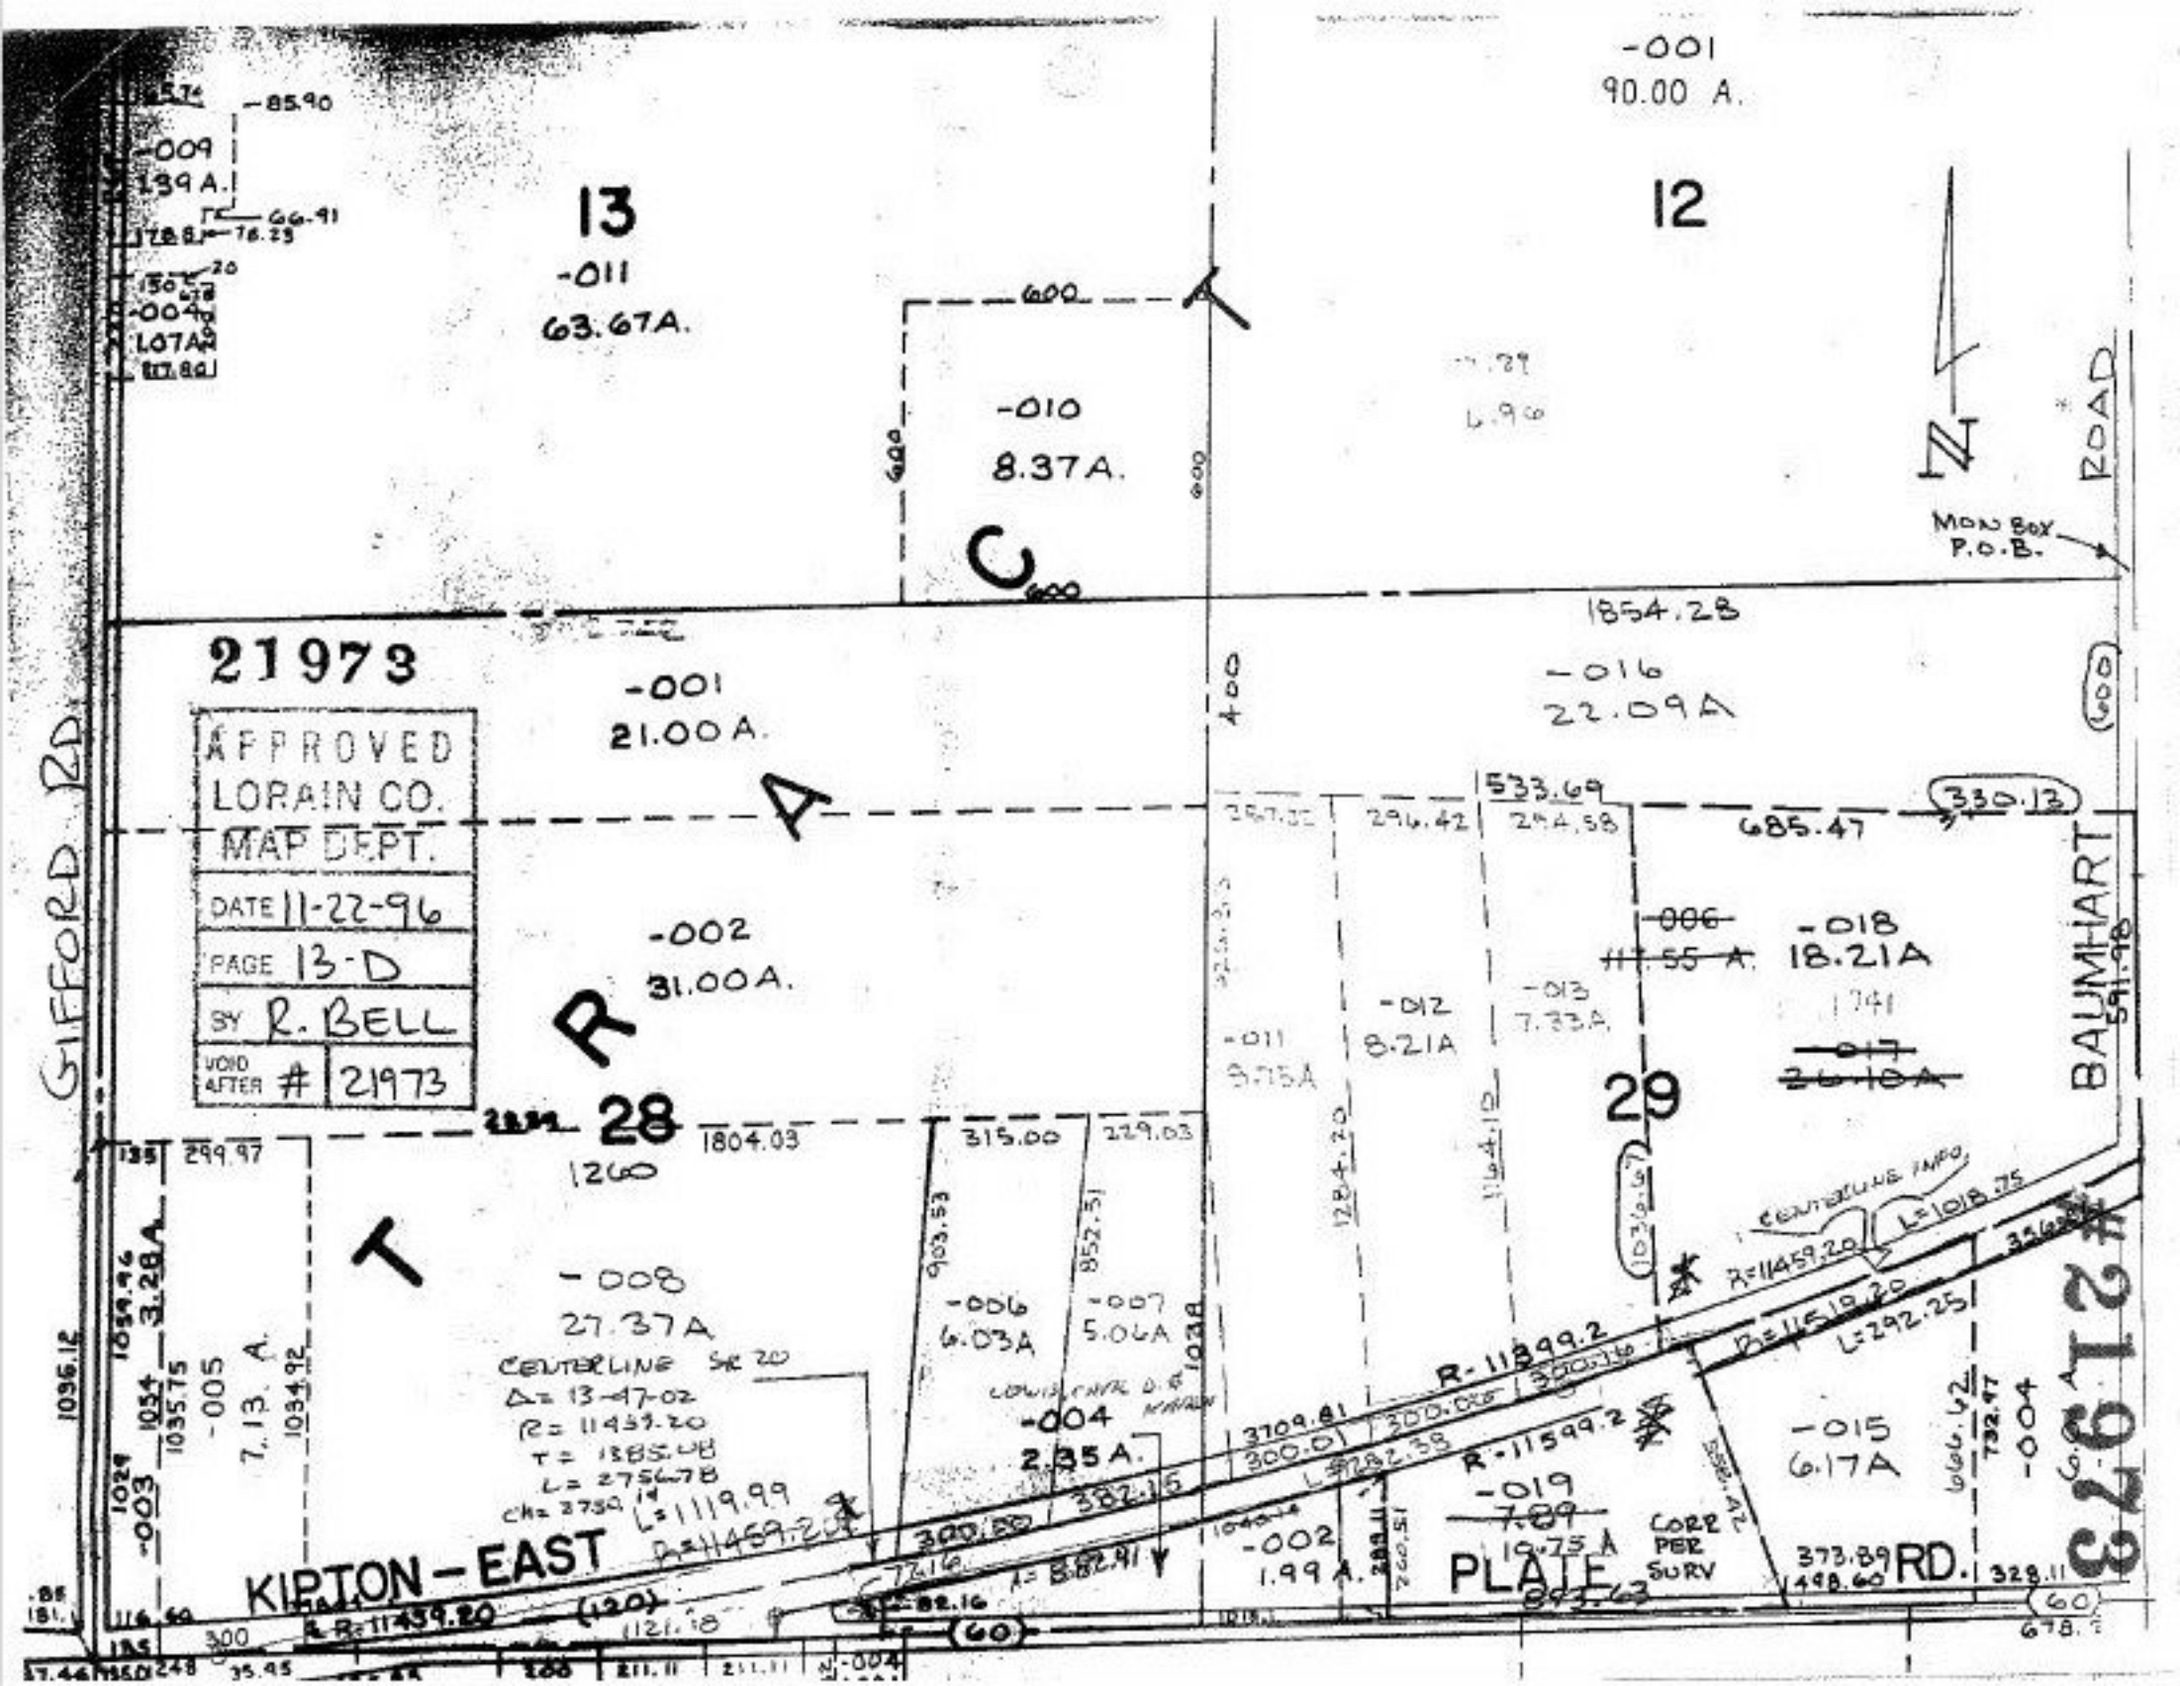
-001
90.00 A.
13
-011
63.67A.
12
-009
139 A.
-010
8.37A.
MON BOX
P.O.B.
ROAD
21973
APPROVED
LORAIN CO.
MAP DEPT.
DATE 11-22-96
PAGE 13-D
BY R. BELL
VOID AFTER # 21973
-001
21.00 A.
-016
22.09A
-002
31.00A.
-018
18.21A
-012
8.21A
-013
7.33A.
-011
9.75A
29
28
1260
-008
27.37A
CENTERLINE SR 20
Δ= 13-47-02
R= 11459.20
T= 1885.08
L= 2756.78
Ch= 2750.14
L=1119.99
R=11459.20
-005
7.13. A.
-006
6.03A
-007
5.06A
-004
2.35A.
-003
3.28A.
-002
1.99A.
-019
7.89
19.75 A
-015
6.17A
-004
CORR PER SURV
GIFFORD RD.
BAUMHART
KIPTON - EAST
PLATE
RD.
CENTERLINE IMPO.
L=1018.75
R=11459.20
L=292.25
R-11599.2
R-11899.2
L=782.39
L=882.91
1854.28
1804.03
533.69
685.47
330.12
315.00
229.03
299.97
1121.18
373.89
498.60
328.11
678.
