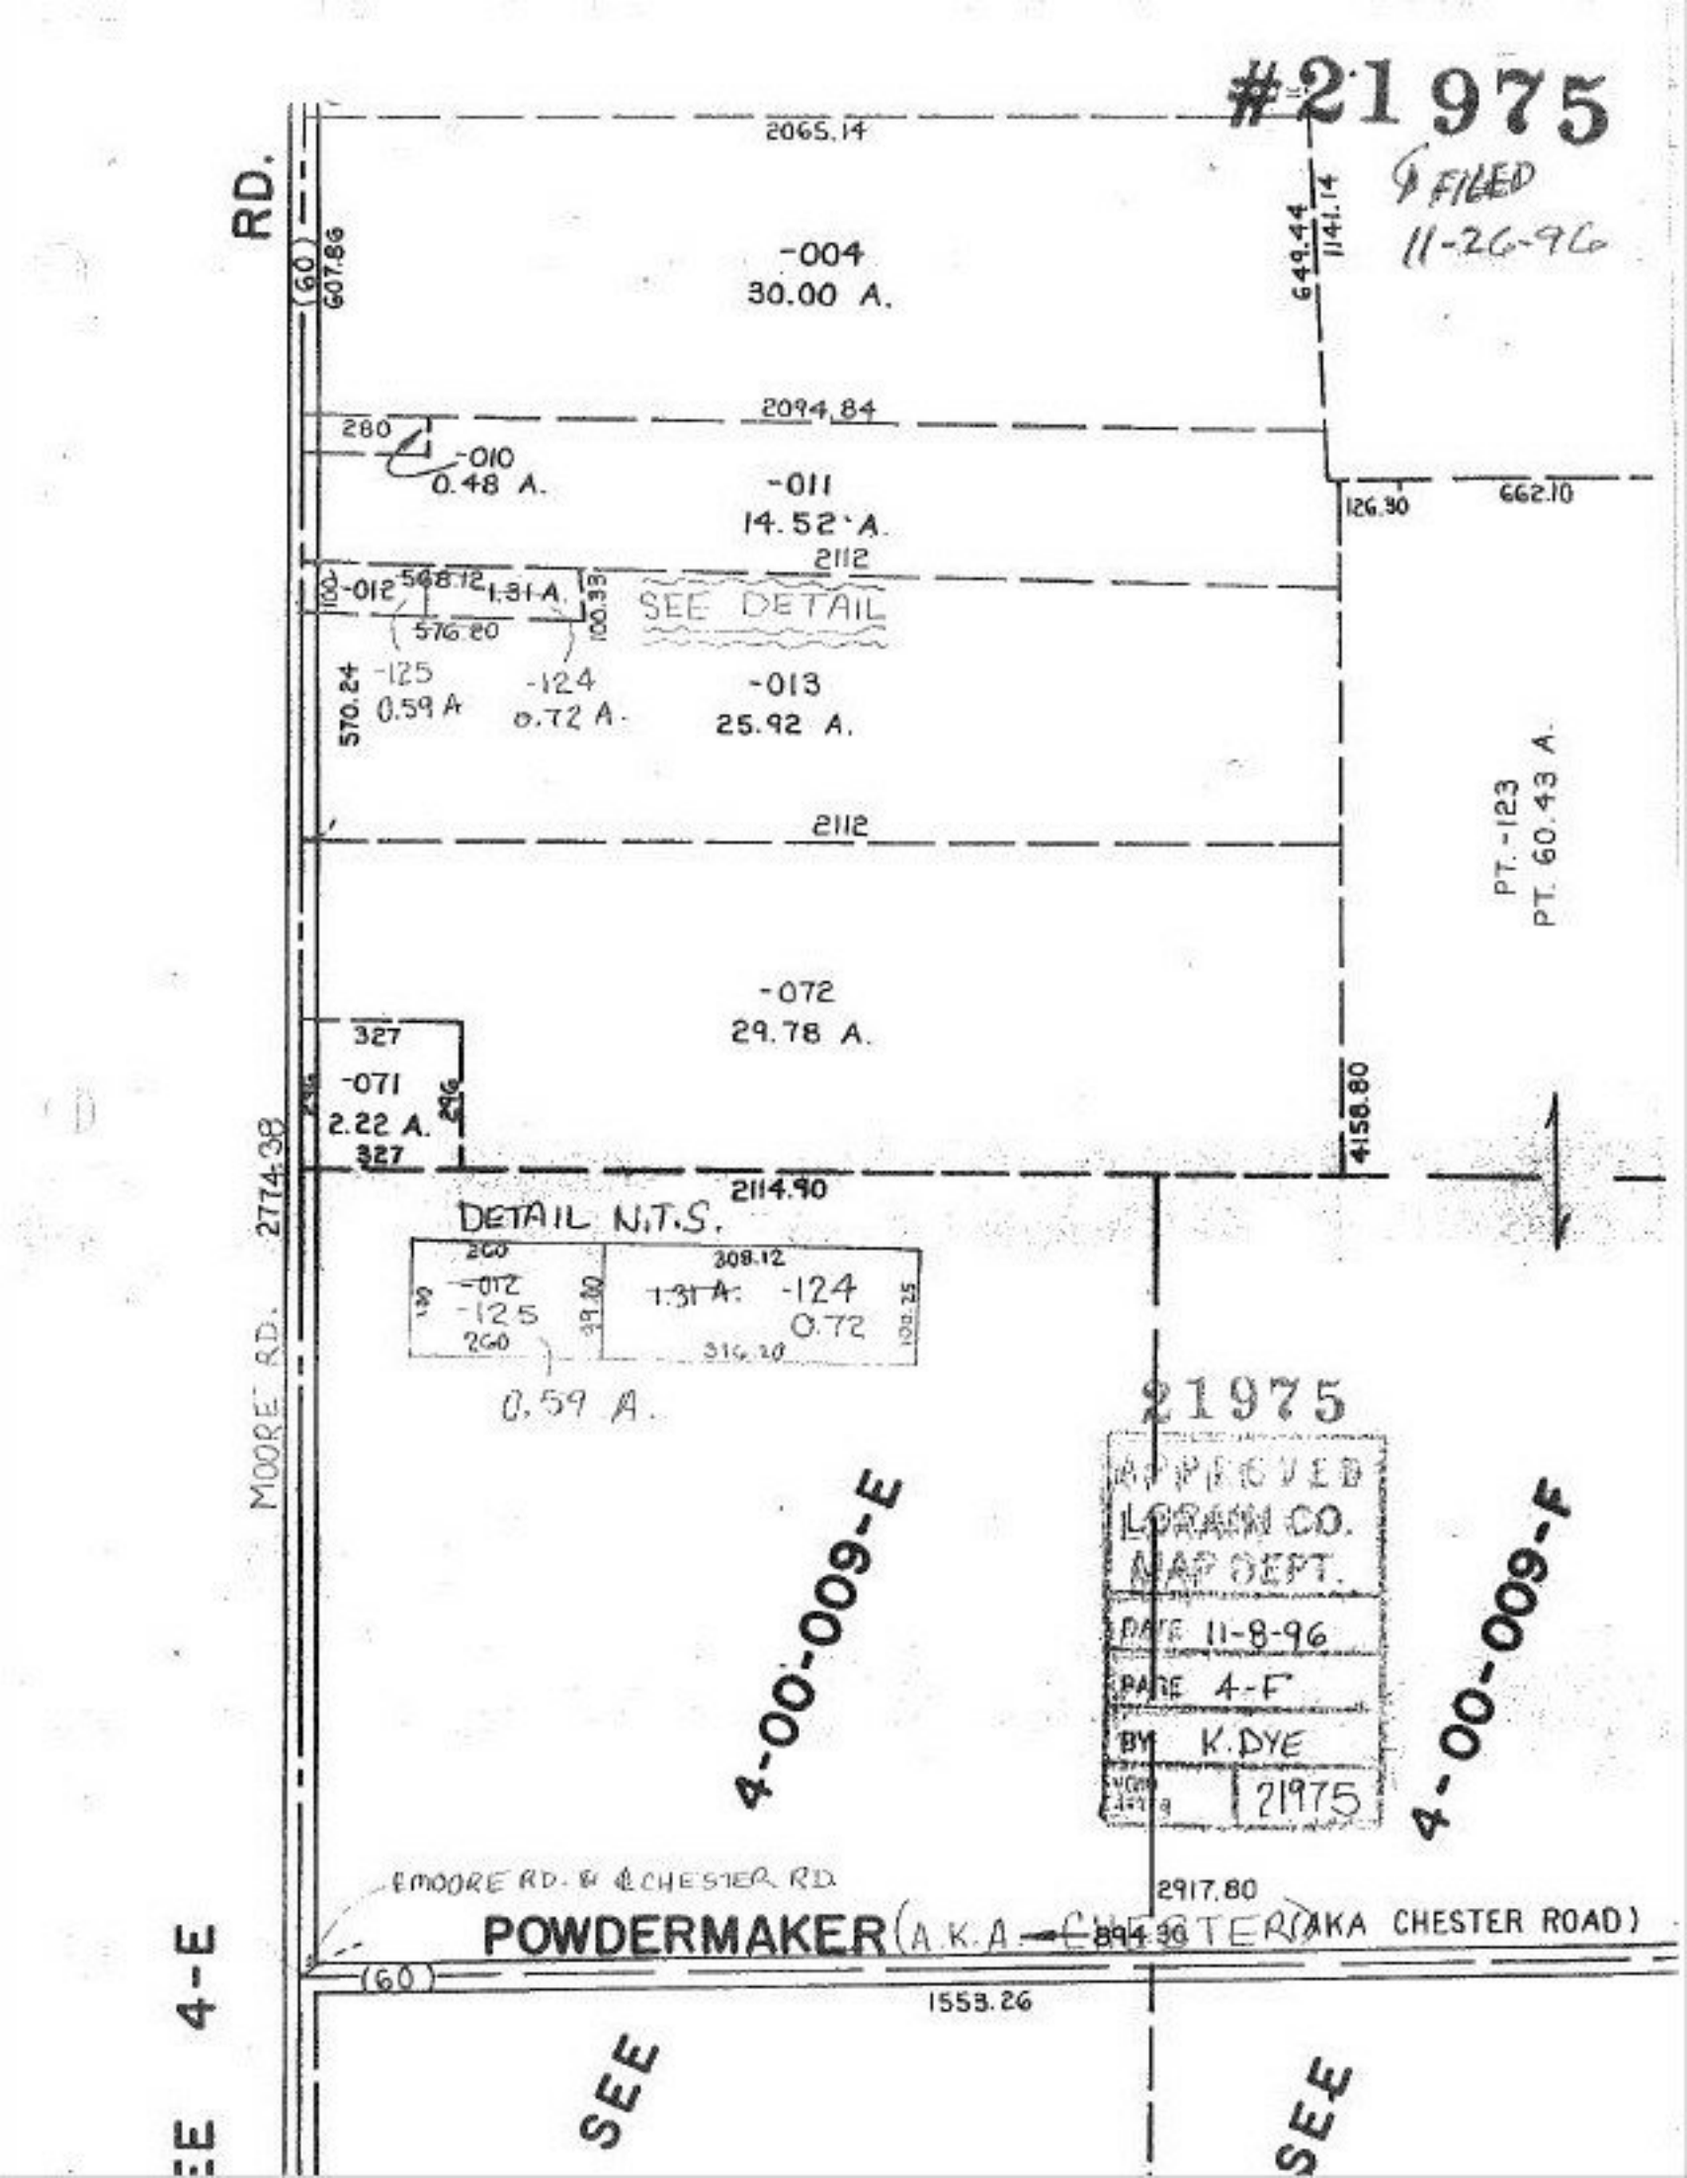
#21975
FILED
11-26-96
2065.14
649.44
1141.14
-004
30.00 A.
2094.84
280
-010
0.48 A.
-011
14.52 A.
126.30
662.10
2112
100
-012
568.12
1.31 A.
100.33
SEE DETAIL
576.20
570.24
-125
0.59 A
-124
0.72 A.
-013
25.92 A.
2112
PT. -123
PT. 60.43 A.
-072
29.78 A.
327
-071
2.22 A.
296
327
4158.80
2774.38
2114.90
DETAIL N.T.S.
200
308.12
-012
-125
200
1.31 A.
-124
0.72
316.20
0.59 A.
21975
APPROVED
LORAIN CO.
MAP DEPT.
DATE 11-8-96
PAGE 4-F
BY K.DYE
21975
4-00-009-E
4-00-009-F
MOORE RD.
RD.
(60)
607.86
MOORE RD. & CHESTER RD.
2917.80
894.36
POWDERMAKER (A.K.A. CHESTER) (AKA CHESTER ROAD)
(60)
1553.26
SEE
SEE
EE 4-E