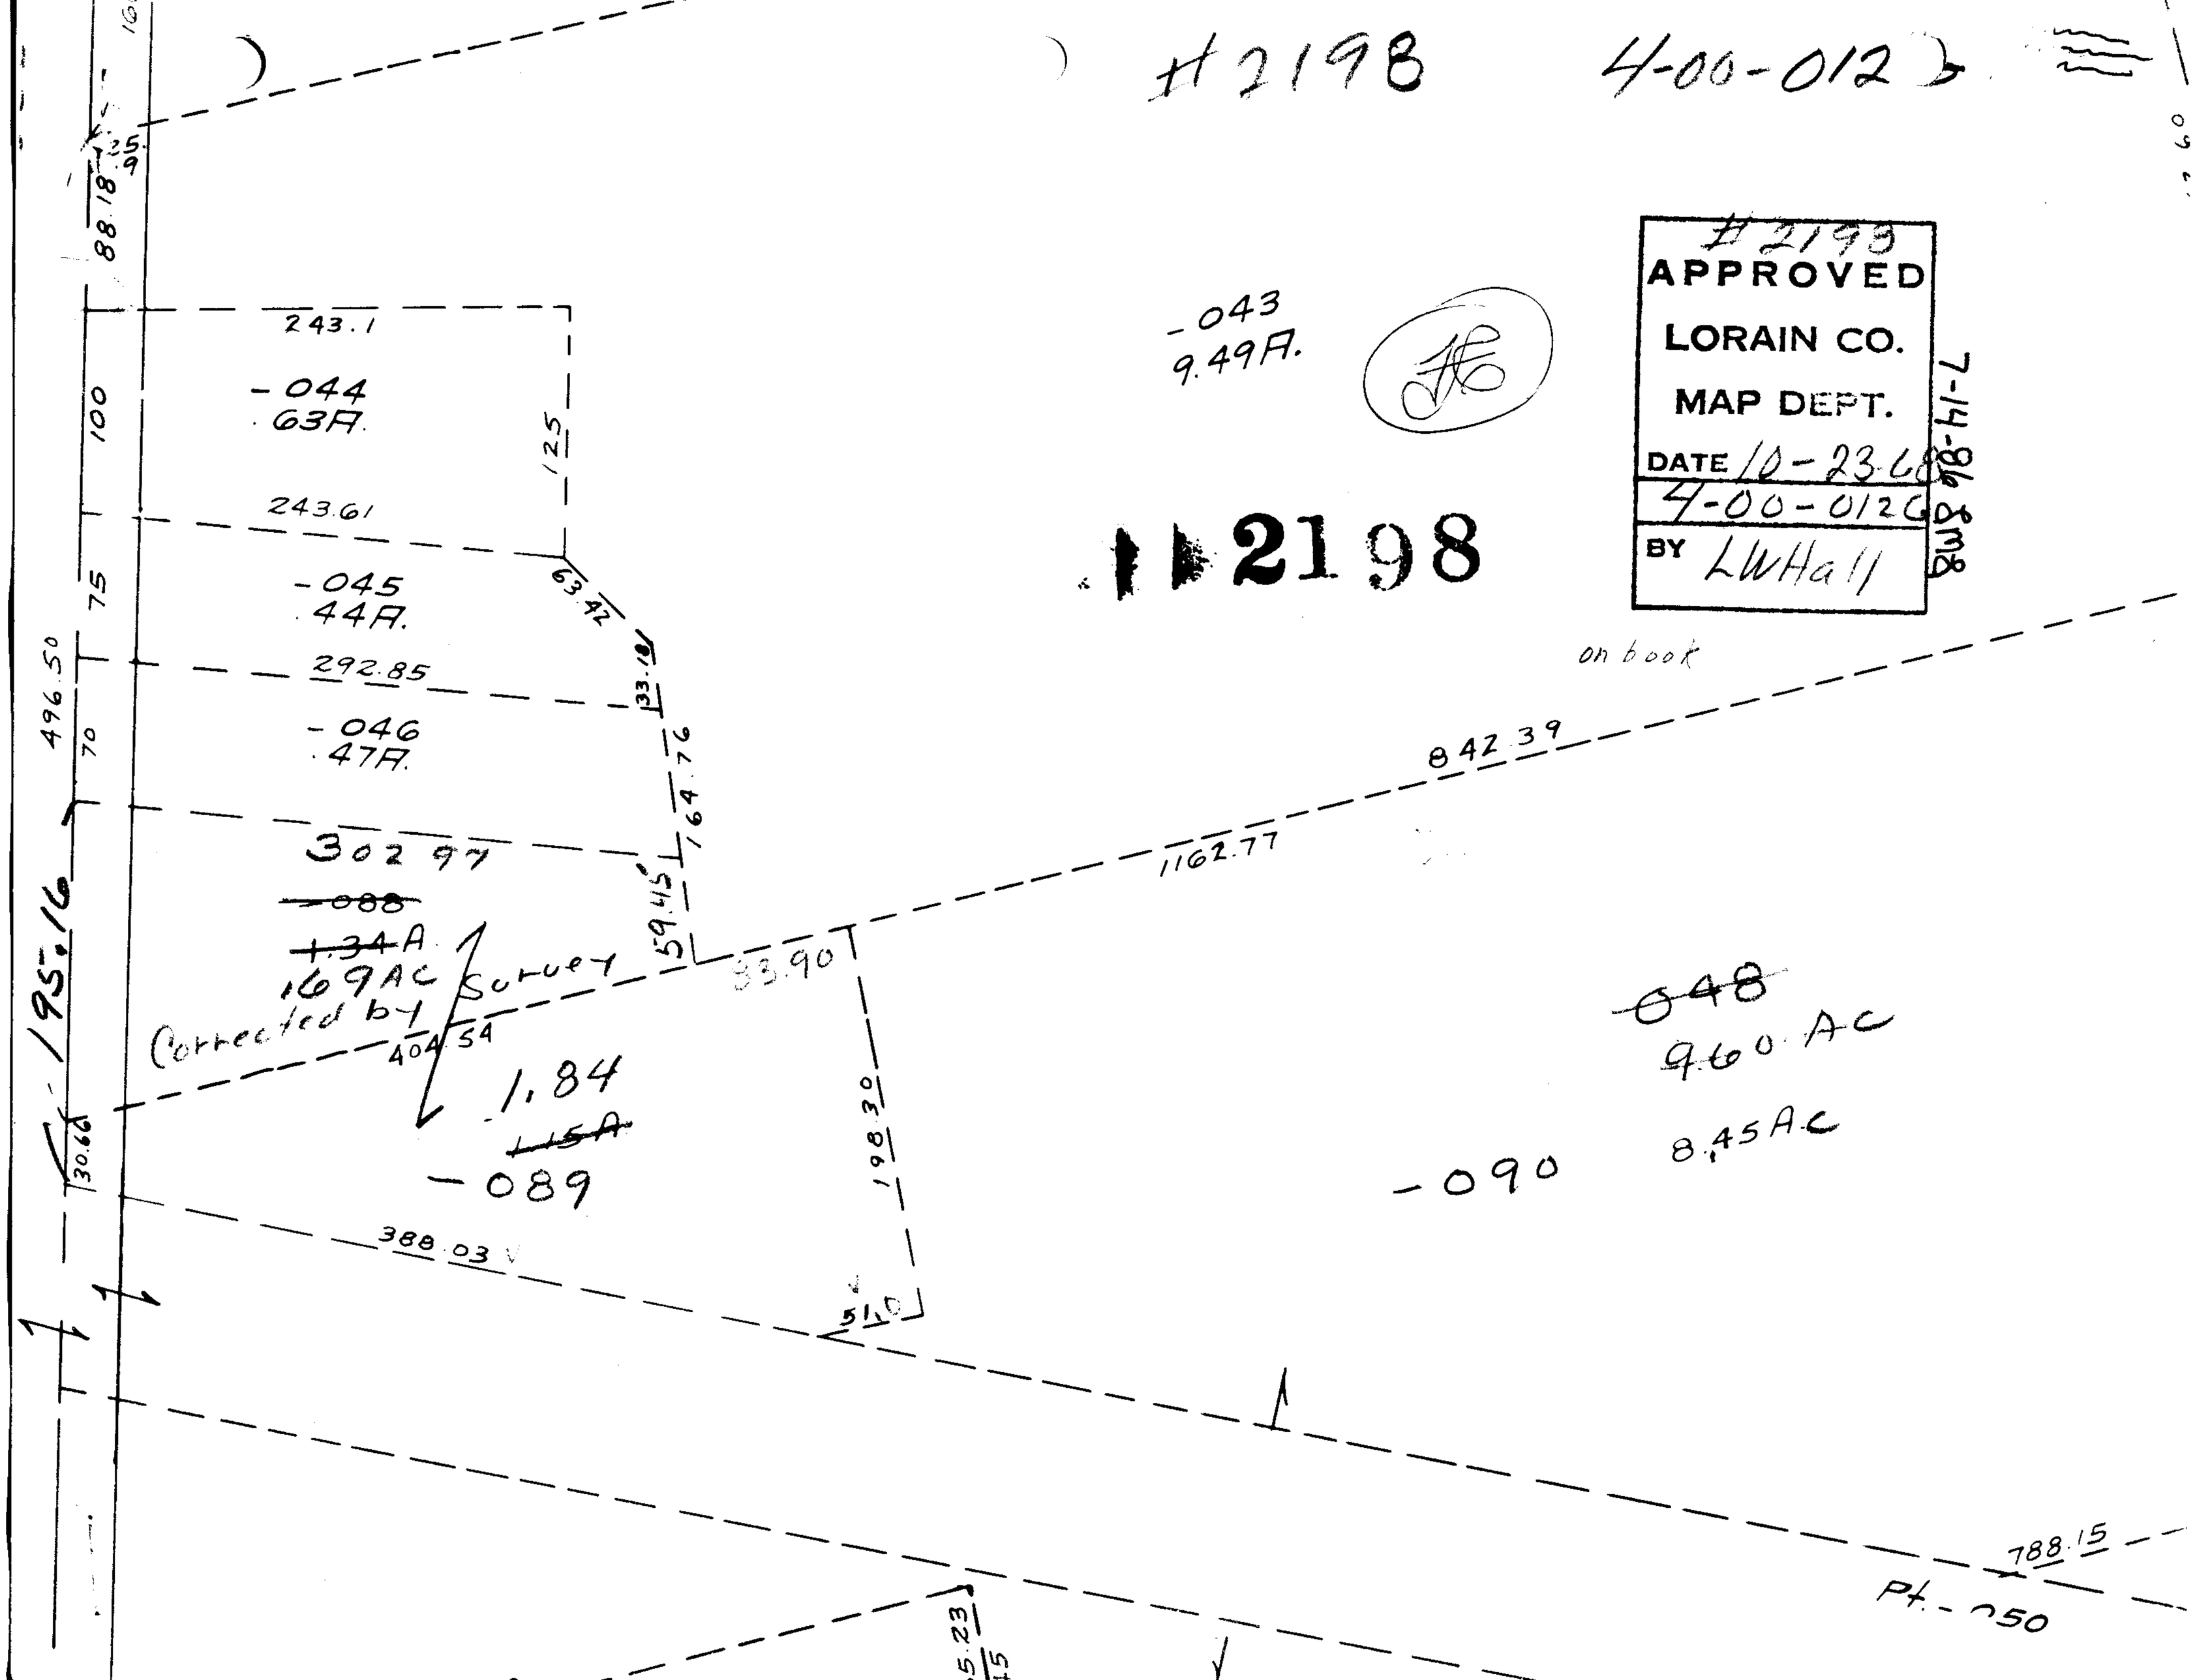
#2198
4-00-012
#2198
APPROVED
LORAIN CO.
MAP DEPT.
DATE 10-23-68
4-00-012C
BY LWHall
7-14-86 8MB
2198
-043
9.49A.
on book
243.1
-044
.63A.
243.61
-045
.44A.
292.85
-046
.47A.
302.97
~~-088~~
~~1.34~~A
.69AC
Corrected by Survey
404.54
1.84
~~1.15A~~
-089
388.03
-090
~~048~~
9.60 AC
8.45 AC
842.39
1162.77
83.90
198.30
51.0
788.15
Pt. -050
496.50
195.16
30.66
100
75
70
125
63.42
33.18
164.76
59.45
88.18
25.9