#21994

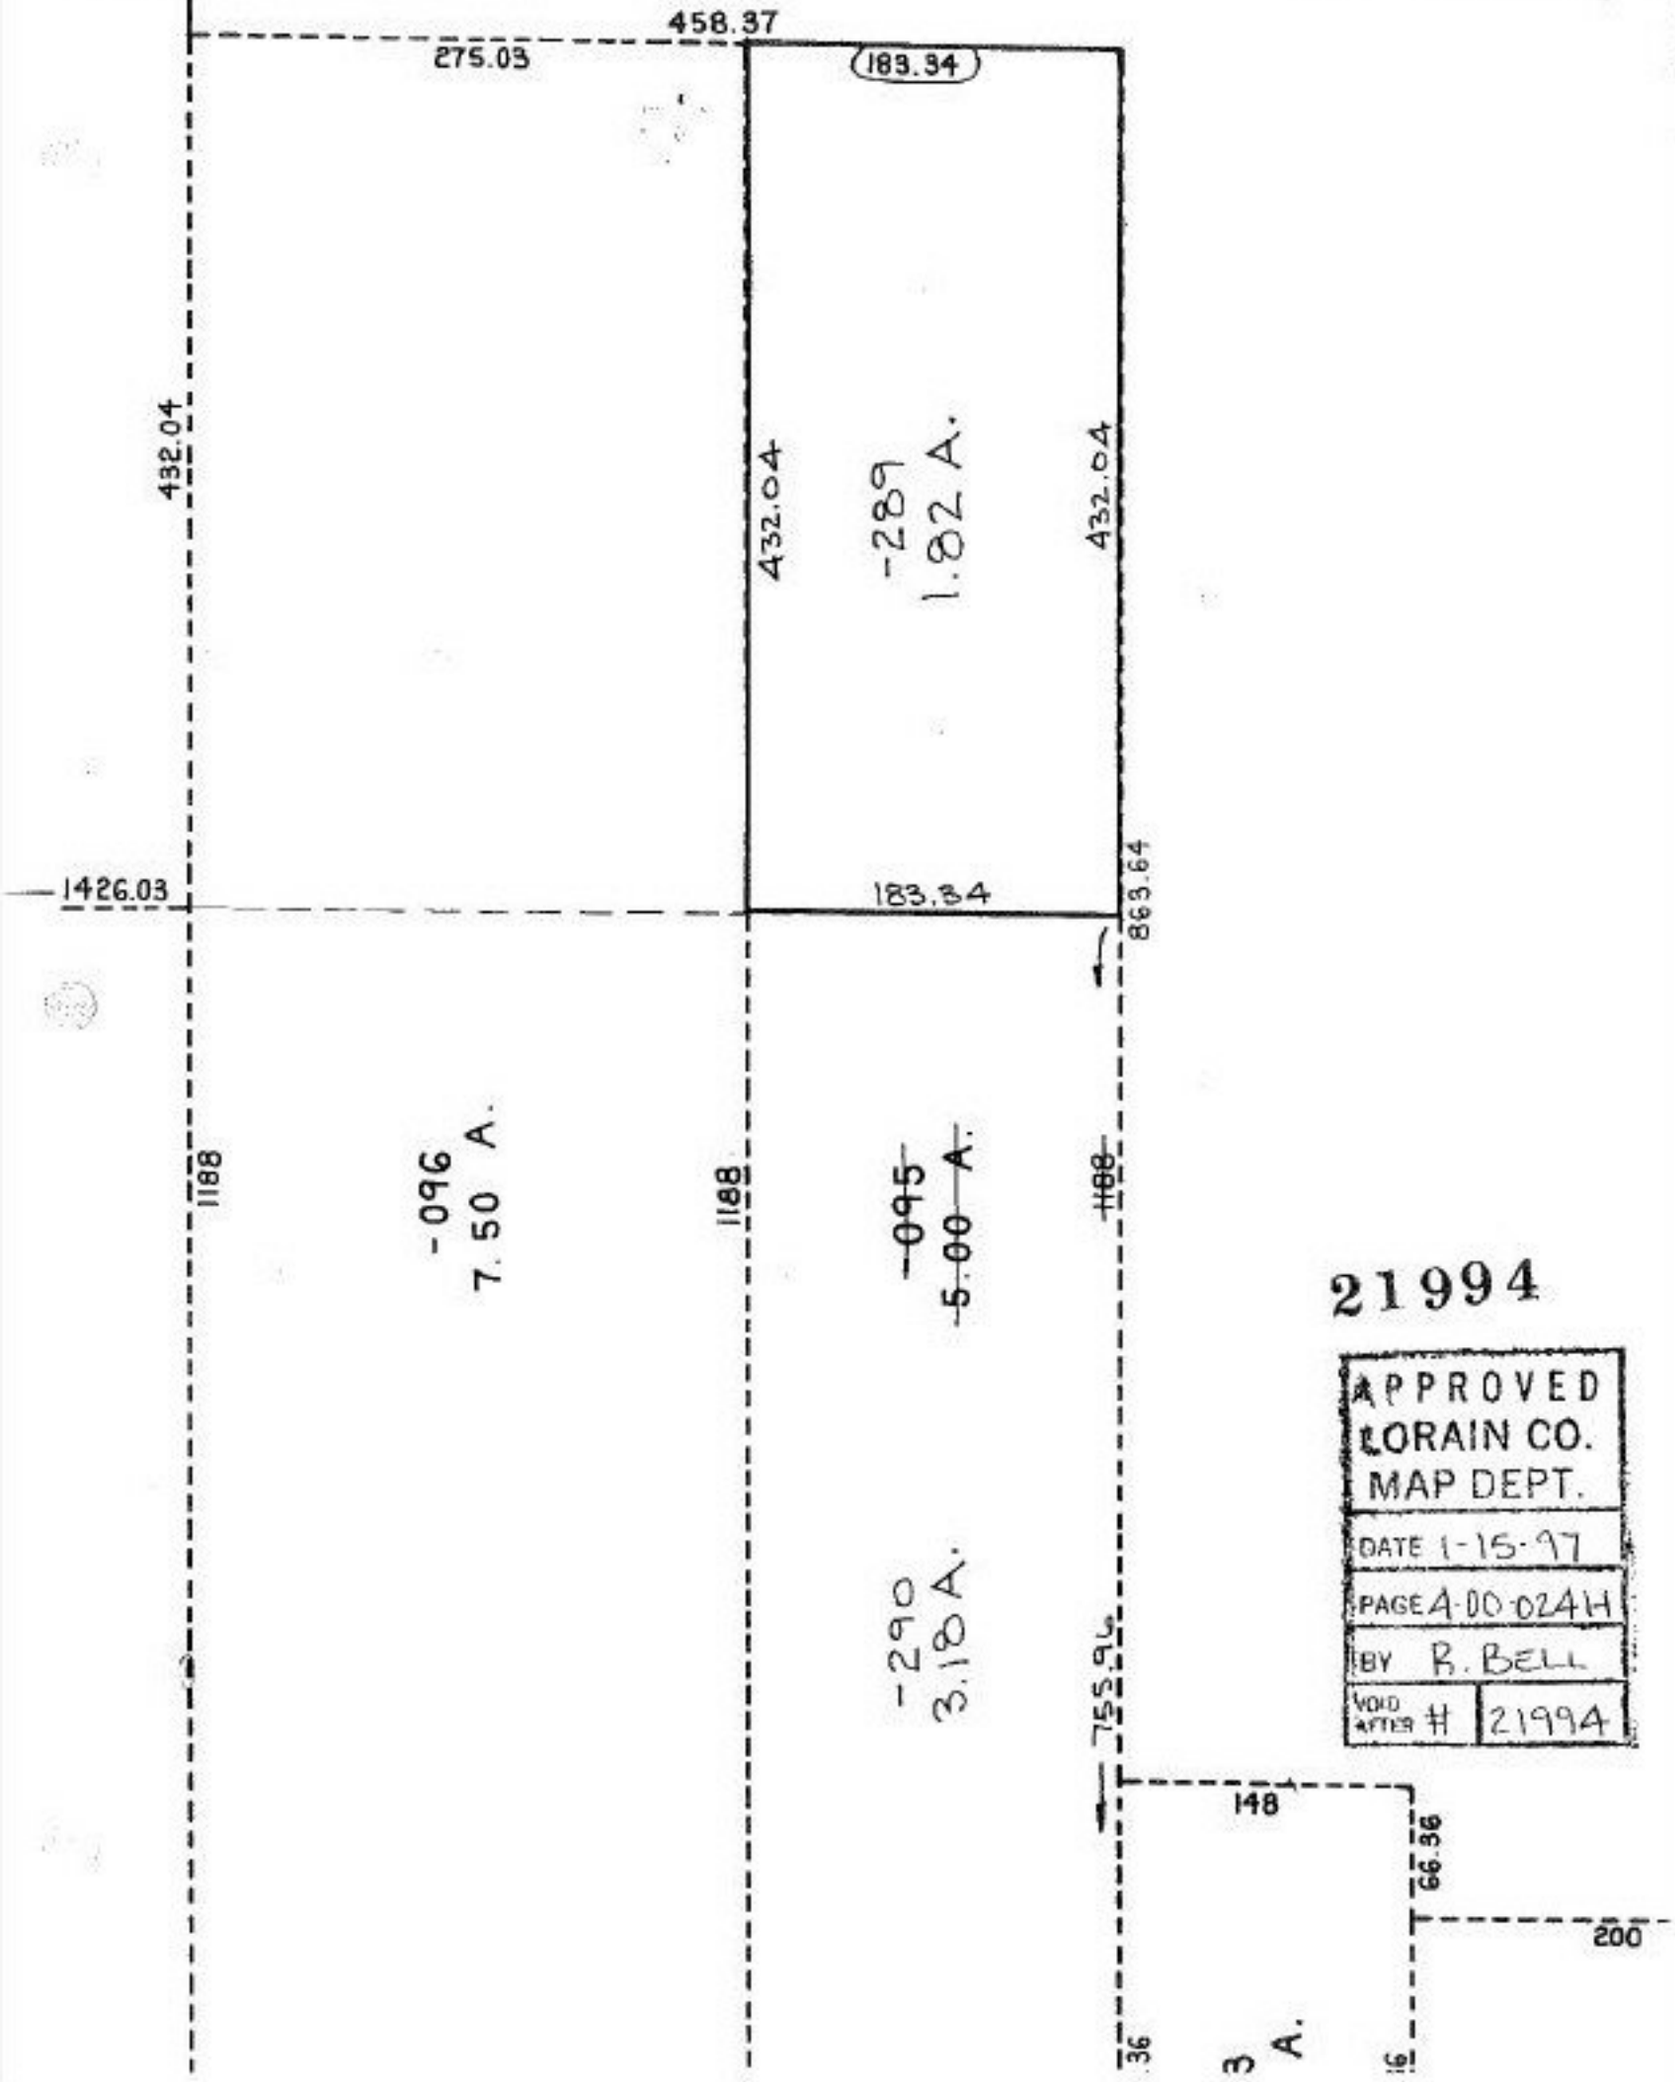

21994

APPROVED
LORAIN CO.
MAP DEPT.

DATE 1-15-97

PAGE 4-00-024H

BY R. BELL

VOID AFTER # 21994