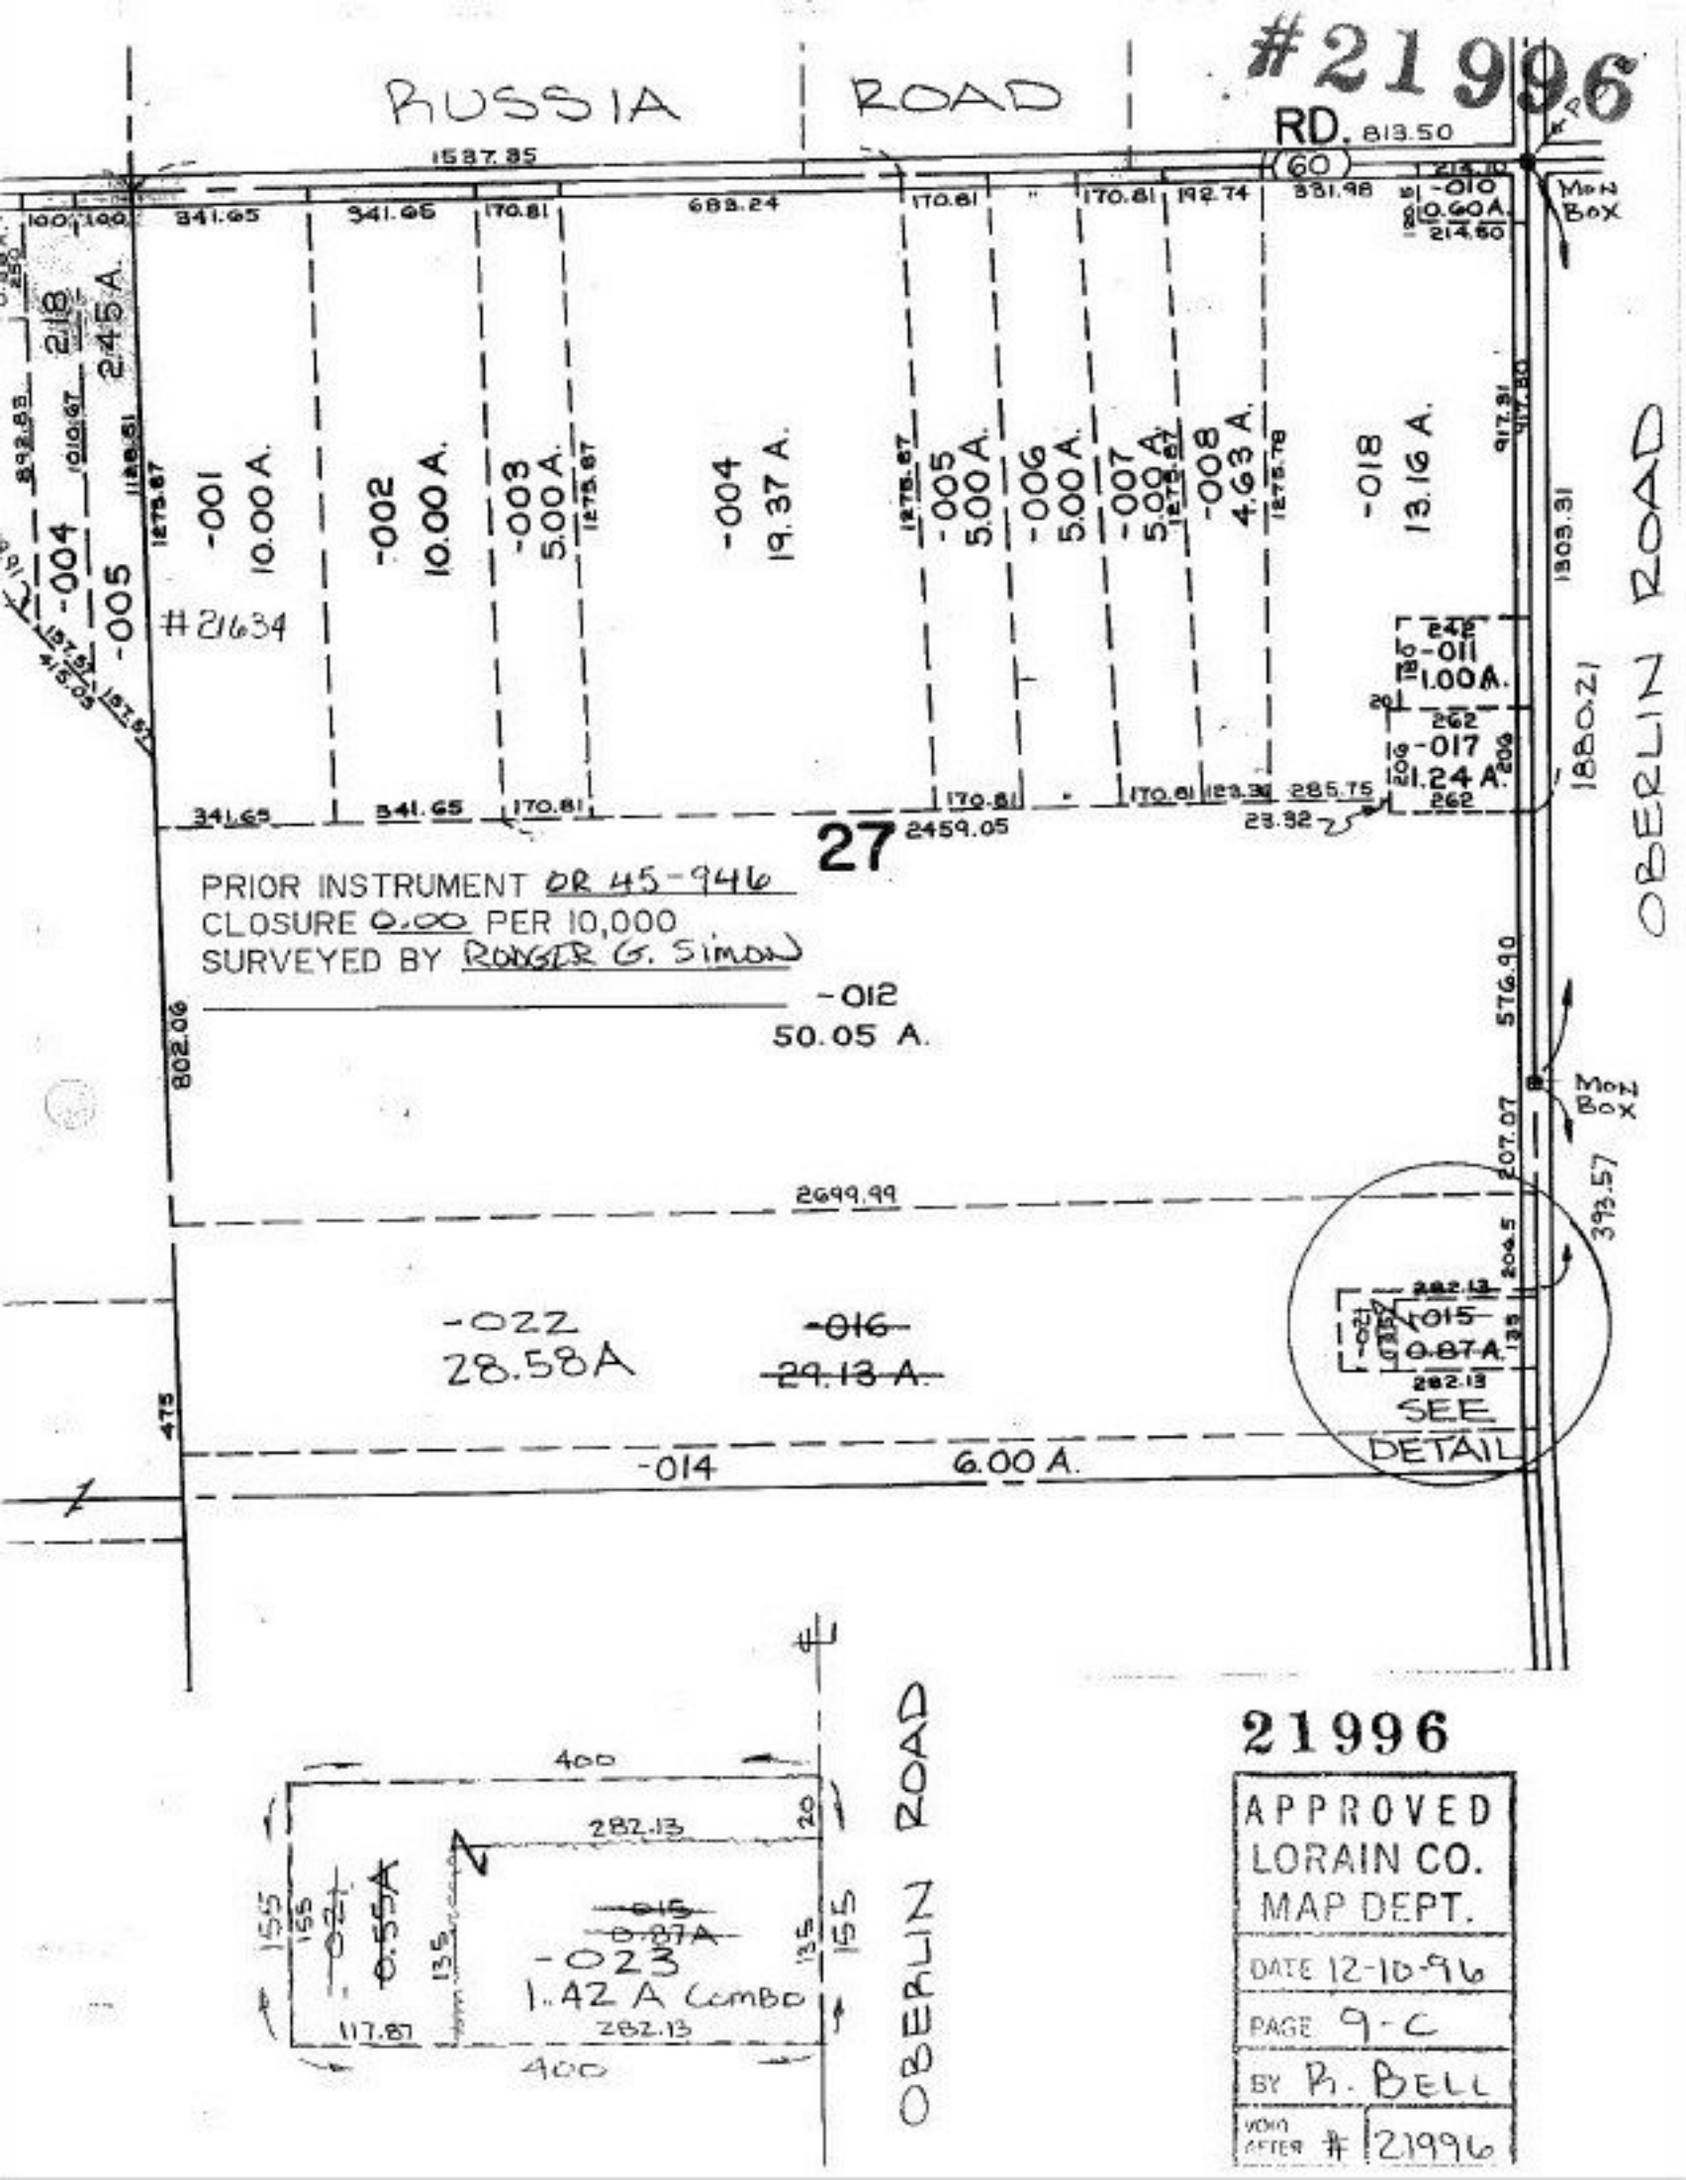
#21996
RUSSIA ROAD
RD. 813.50
60
1587.35
341.65
341.65
170.81
683.24
170.81
170.81
192.74
331.98
213.10
-010
0.60A.
214.60
Mail Box
100
100
218
245 A.
-004
-005
#21634
-001
10.00 A.
-002
10.00 A.
-003
5.00 A.
-004
19.37 A.
-005
5.00 A.
-006
5.00 A.
-007
5.00 A.
-008
4.63 A.
-018
13.16 A.
-011
1.00A.
-017
21.24 A.
OBERLIN ROAD
1803.21
917.81
917.80
1303.31
341.65
341.65
170.81
170.81
170.81
123.36
285.75
23.32
27
2459.05
PRIOR INSTRUMENT OR 45-946
CLOSURE 0.00 PER 10,000
SURVEYED BY ROGER G. SIMON
-012
50.05 A.
802.06
576.90
Mail Box
207.07
393.57
2699.99
-022
28.58A
-016
29.13 A.
282.13
-021
-015
0.87A
282.13
SEE DETAIL
475
-014
6.00 A.
℄
400
282.13
20
155
155
-021
0.55A
135
-015
0.87A
-023
1.42 A Combo
135
155
117.87
282.13
400
OBERLIN ROAD
21996
APPROVED
LORAIN CO.
MAP DEPT.
DATE 12-10-96
PAGE 9-C
BY R. BELL
VOID AFTER # 21996