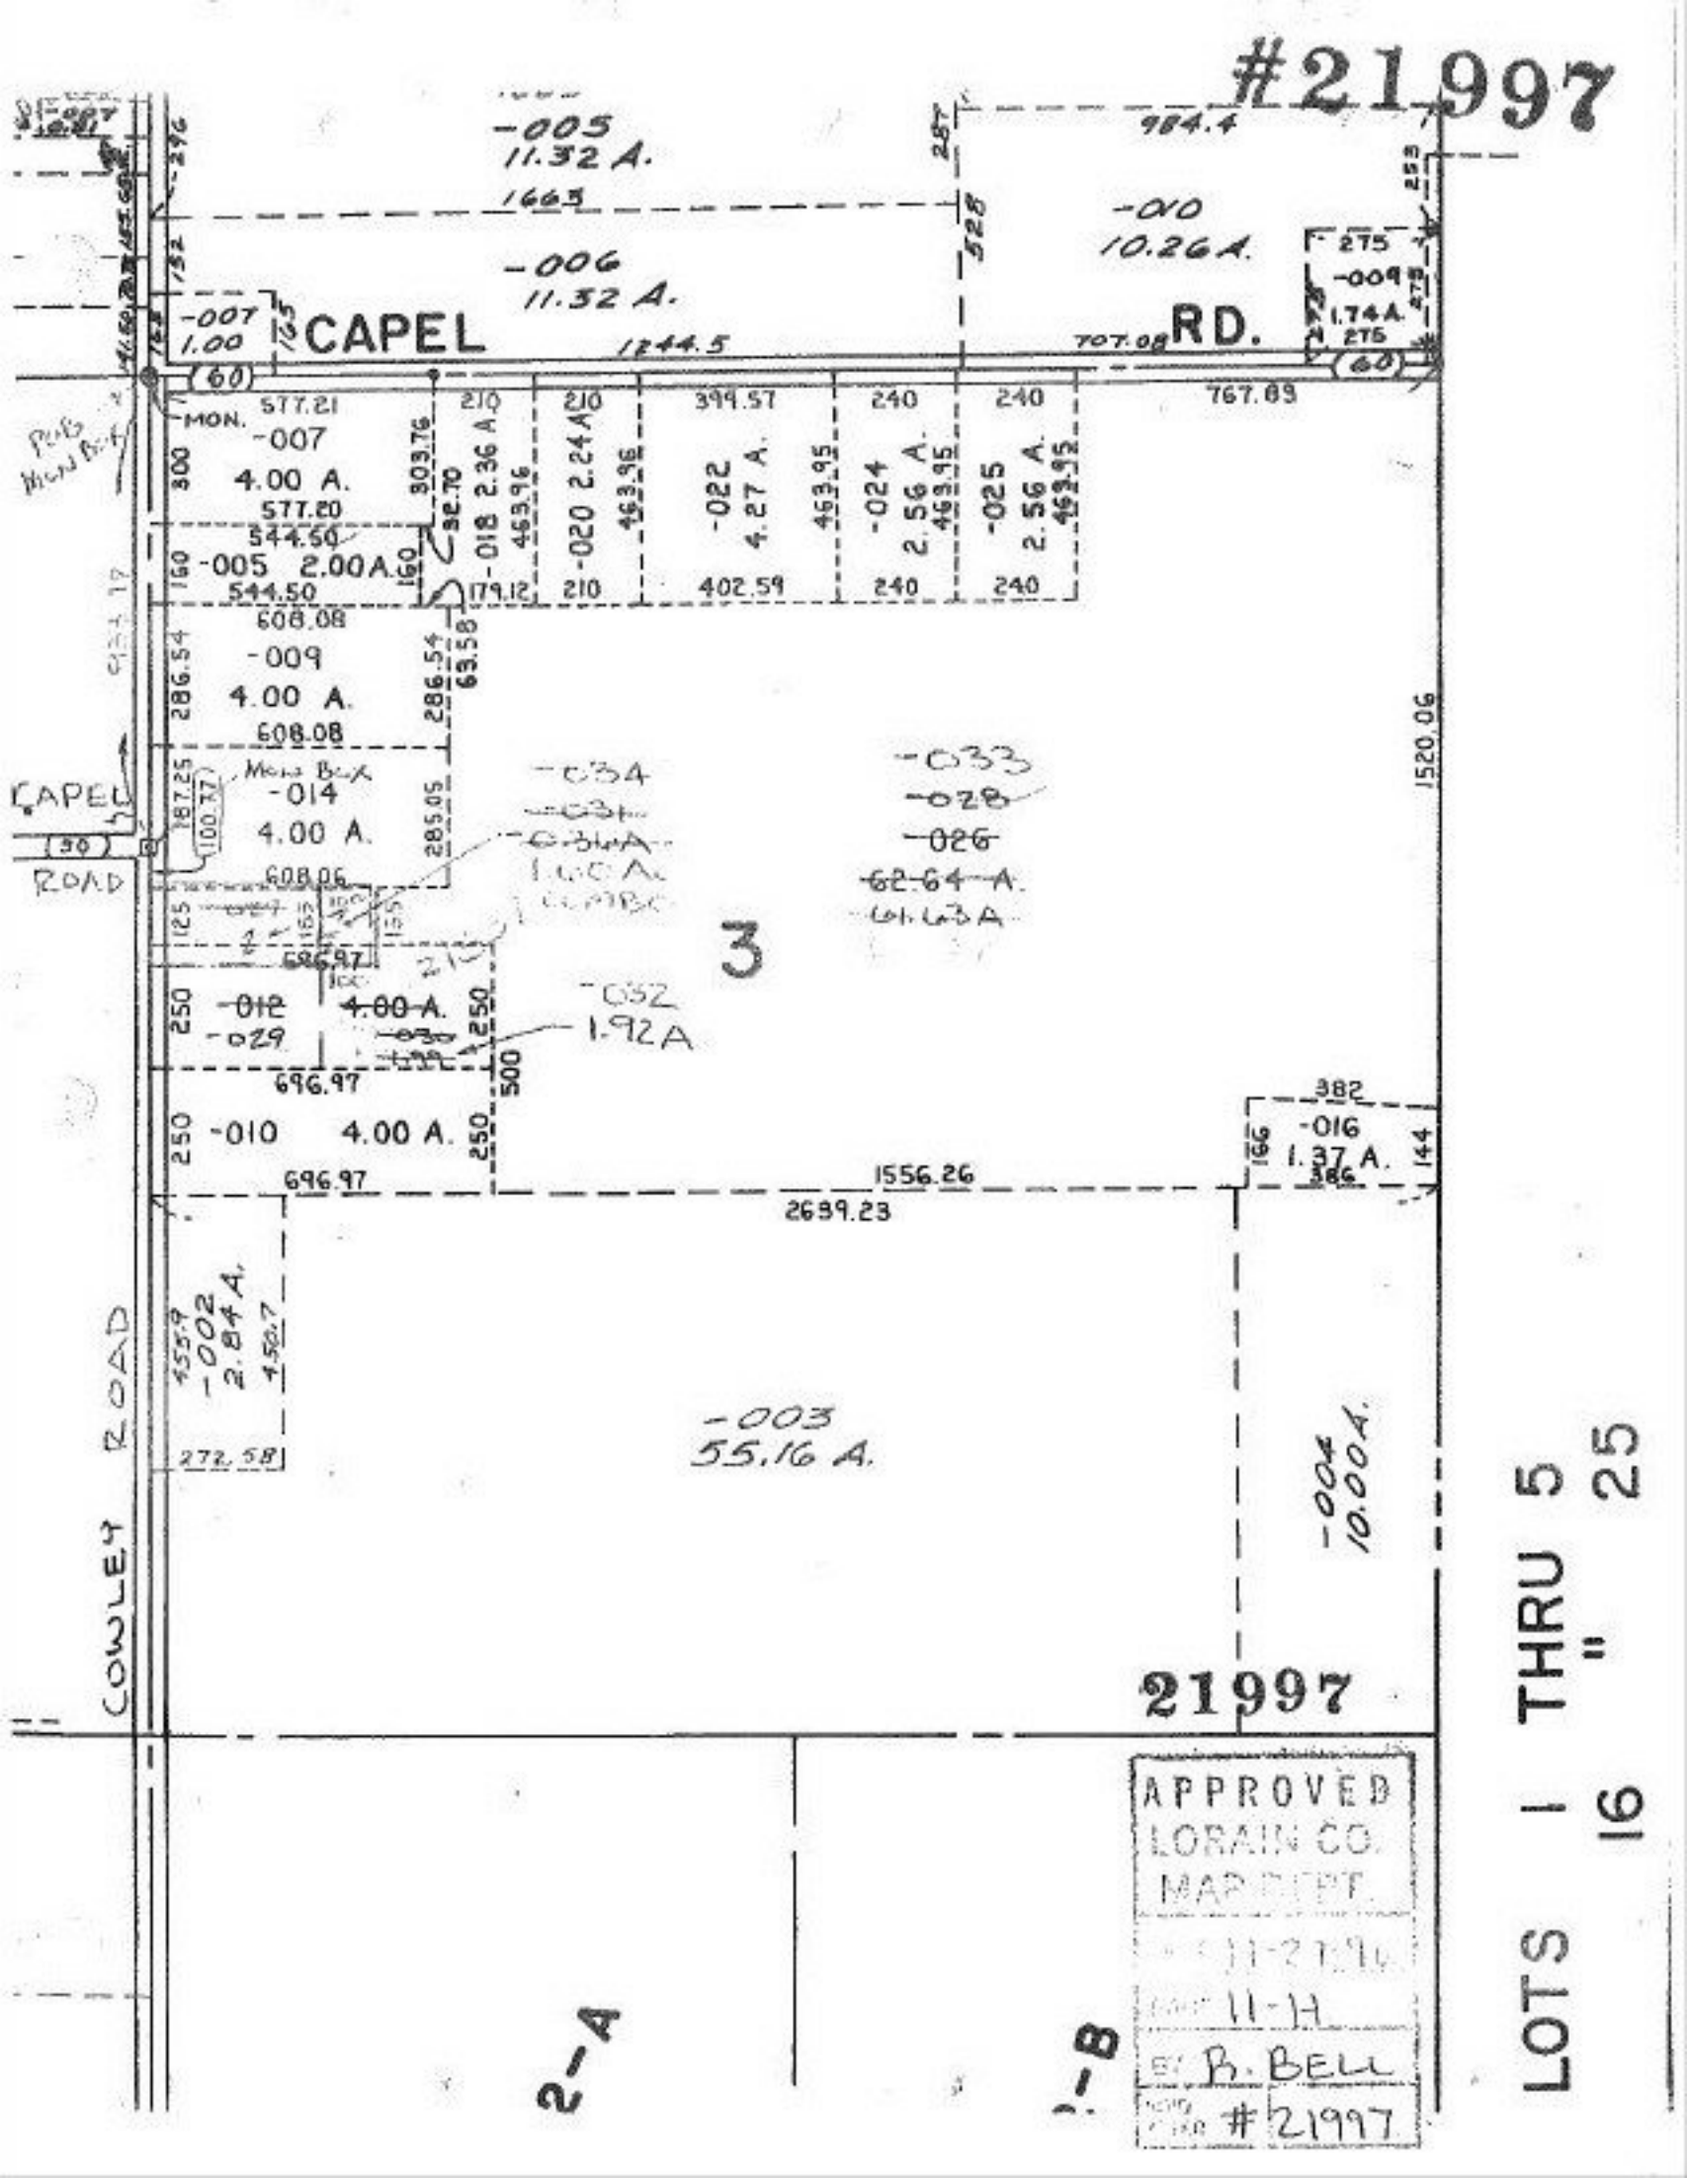
#21997
-005
11.32 A.
1663
-006
11.32 A.
-007
1.00
CAPEL
1244.5
984.4
-010
10.26 A.
-009
1.74 A.
707.08
RD.
767.89
-007
4.00 A.
577.21
577.20
544.50
-005 2.00 A.
544.50
608.08
-009
4.00 A.
608.08
-014
4.00 A.
608.06
CAPEL
ROAD
-018 2.36 A
-020 2.24 A
-022
4.27 A.
-024
2.56 A.
-025
2.56 A.
-034
-031
-033
-028
-026
62.64 A.
61.63 A
3
-032
1.92 A
-012
-029
4.00 A.
696.97
-010 4.00 A.
696.97
1556.26
2639.23
-016
1.37 A.
-002
2.84 A.
-003
55.16 A.
-004
10.00 A.
COWLEY ROAD
21997
APPROVED
LORAIN CO.
MAP DEPT.
11-H
R. BELL
#21997
LOTS 1 THRU 5
16 " 25
2-A
-B