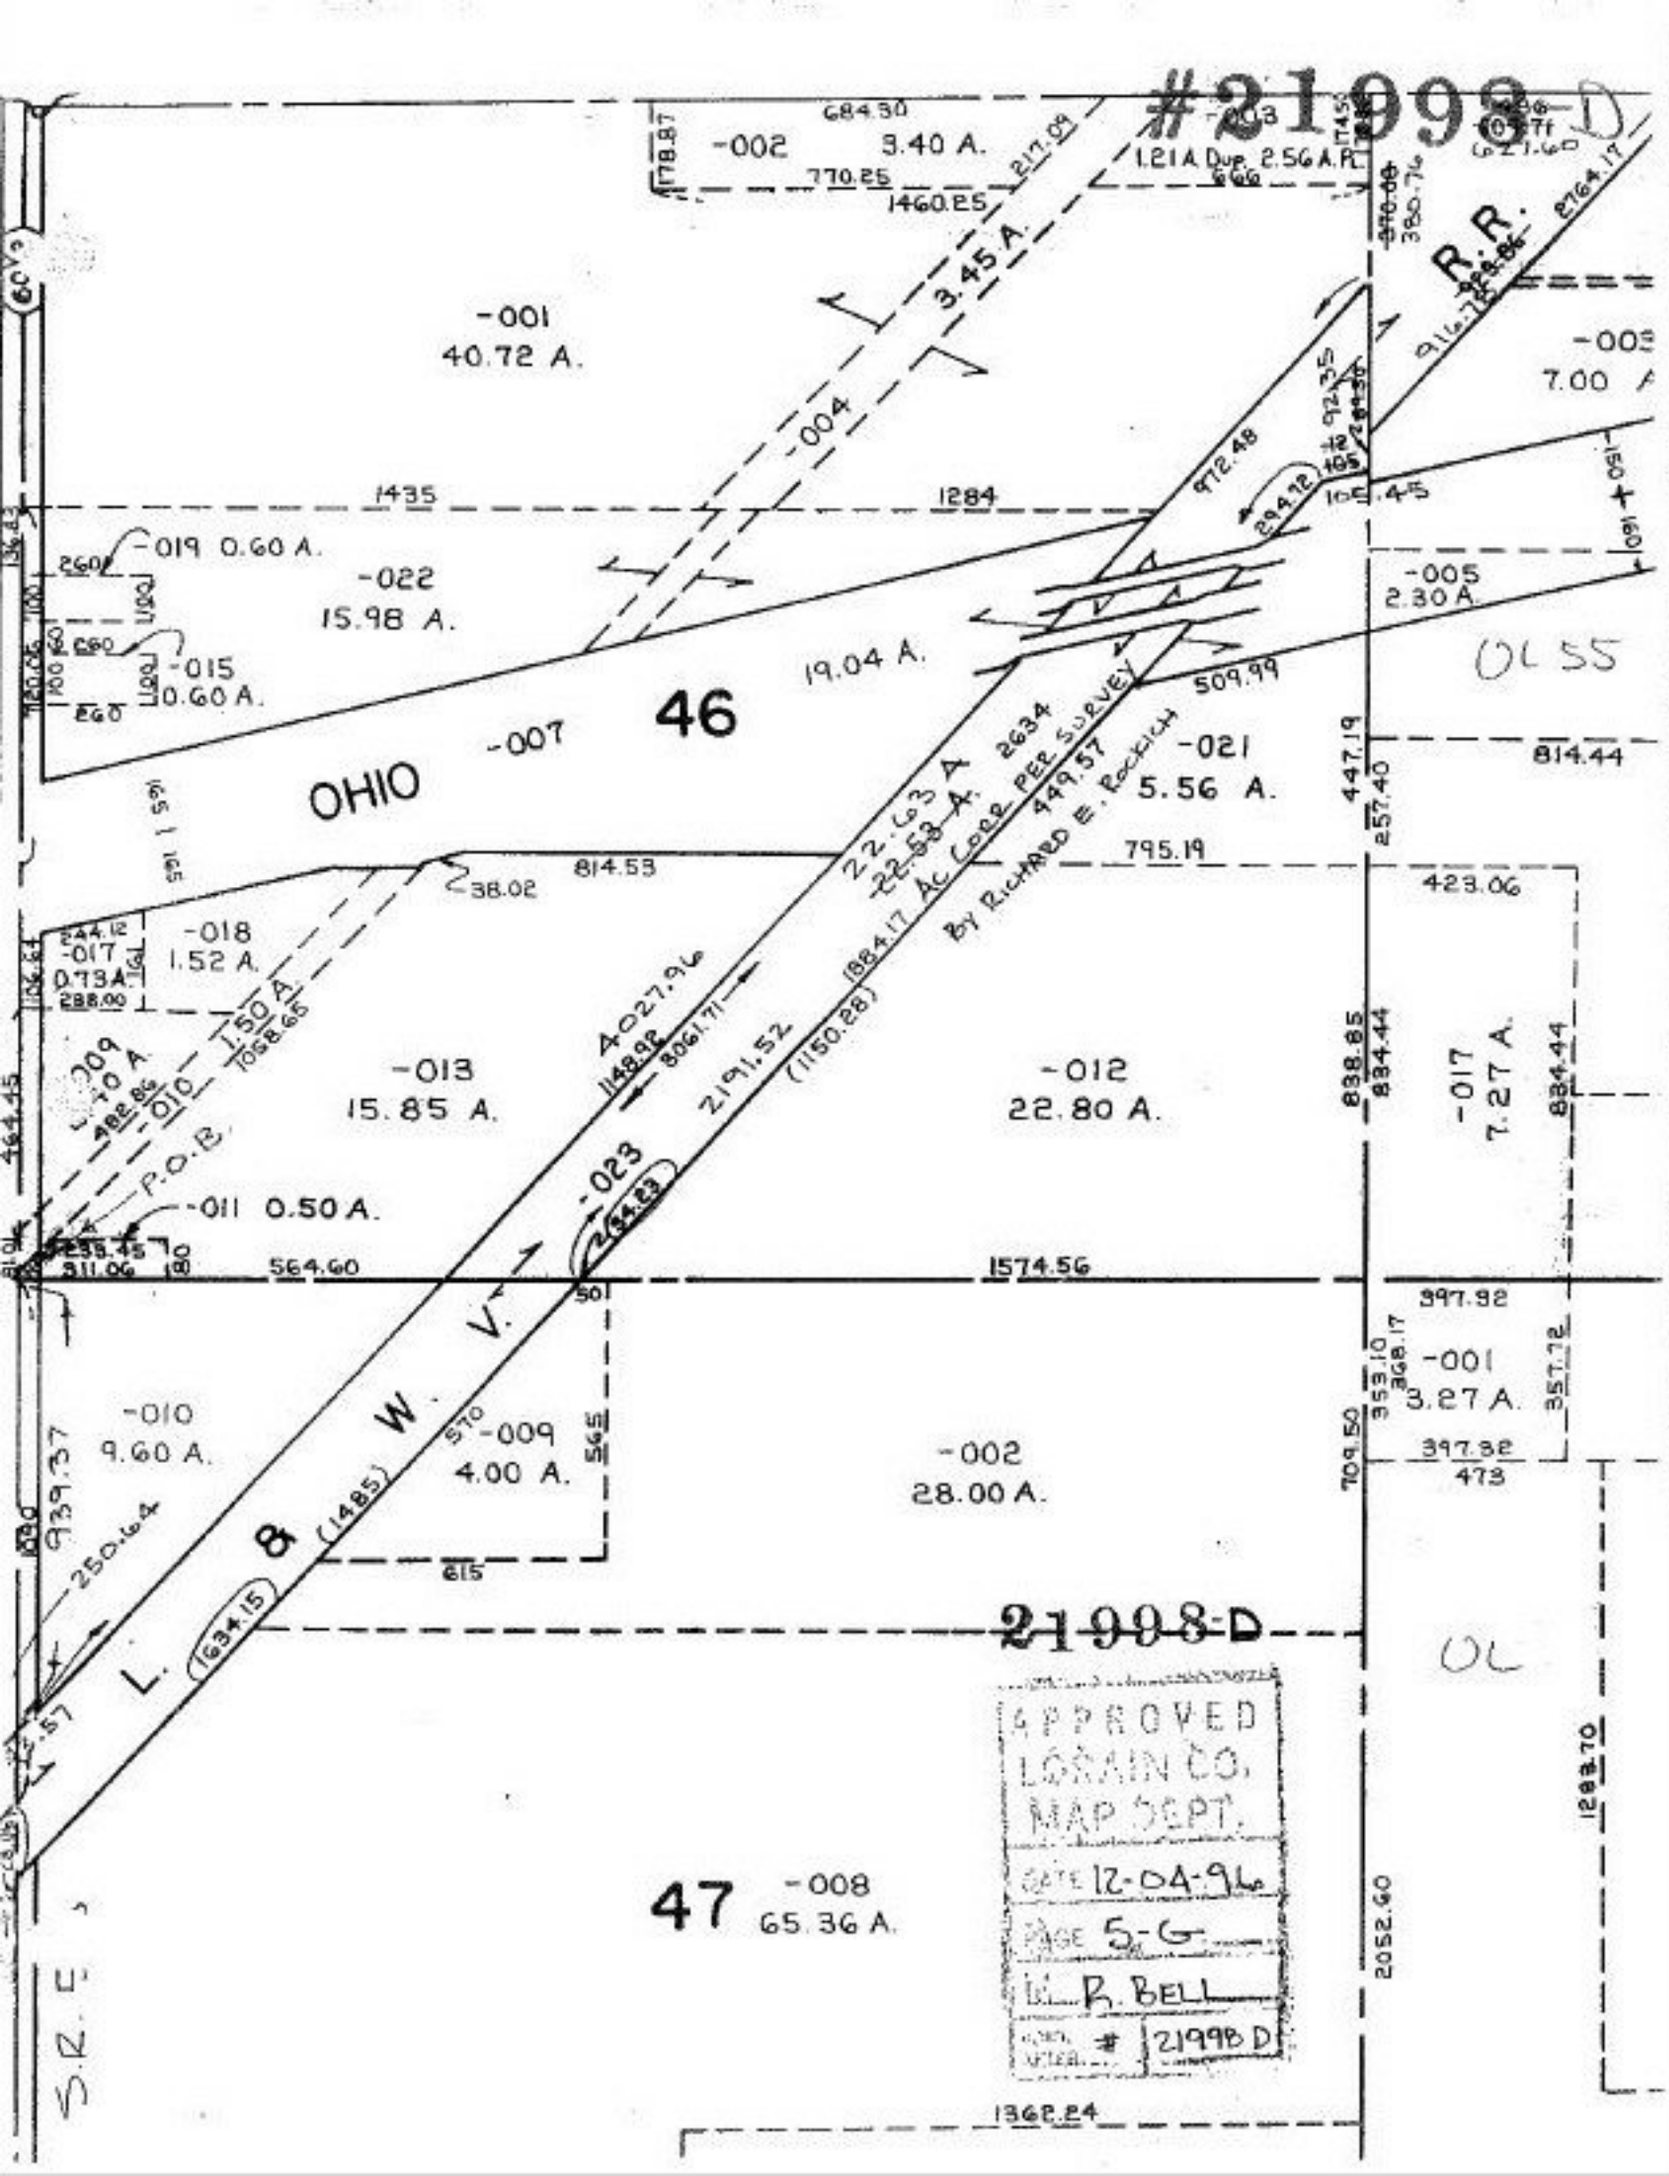
#21998-D
-002 3.40 A.
1.21 A. Dup. 2.56 A. Pt.
3.45 A.
-001 40.72 A.
-004
R.R.
-003 7.00 A
-019 0.60 A.
-022 15.98 A.
-015 0.60 A.
19.04 A.
46
OHIO
-007
-021 5.56 A.
-005 2.30 A.
OLSS
22.63 A.
22.53 A.
2634 Ac Coor. PEE SURVEY
By RICHARD E. ROCICH
-018 1.52 A.
-017 0.73 A.
-009 1.50 A.
-010
-013 15.85 A.
-012 22.80 A.
-017 7.27 A.
P.O.B.
-011 0.50 A.
-023
W. V. & L. (1485)
-010 9.60 A.
-009 4.00 A.
-002 28.00 A.
-001 3.27 A.
47
-008 65.36 A.
21998-D
APPROVED
LORAIN CO.
MAP DEPT.
DATE 12-04-96
PAGE 5-G
L. R. BELL
ORIG. APPLN. # 21998 D