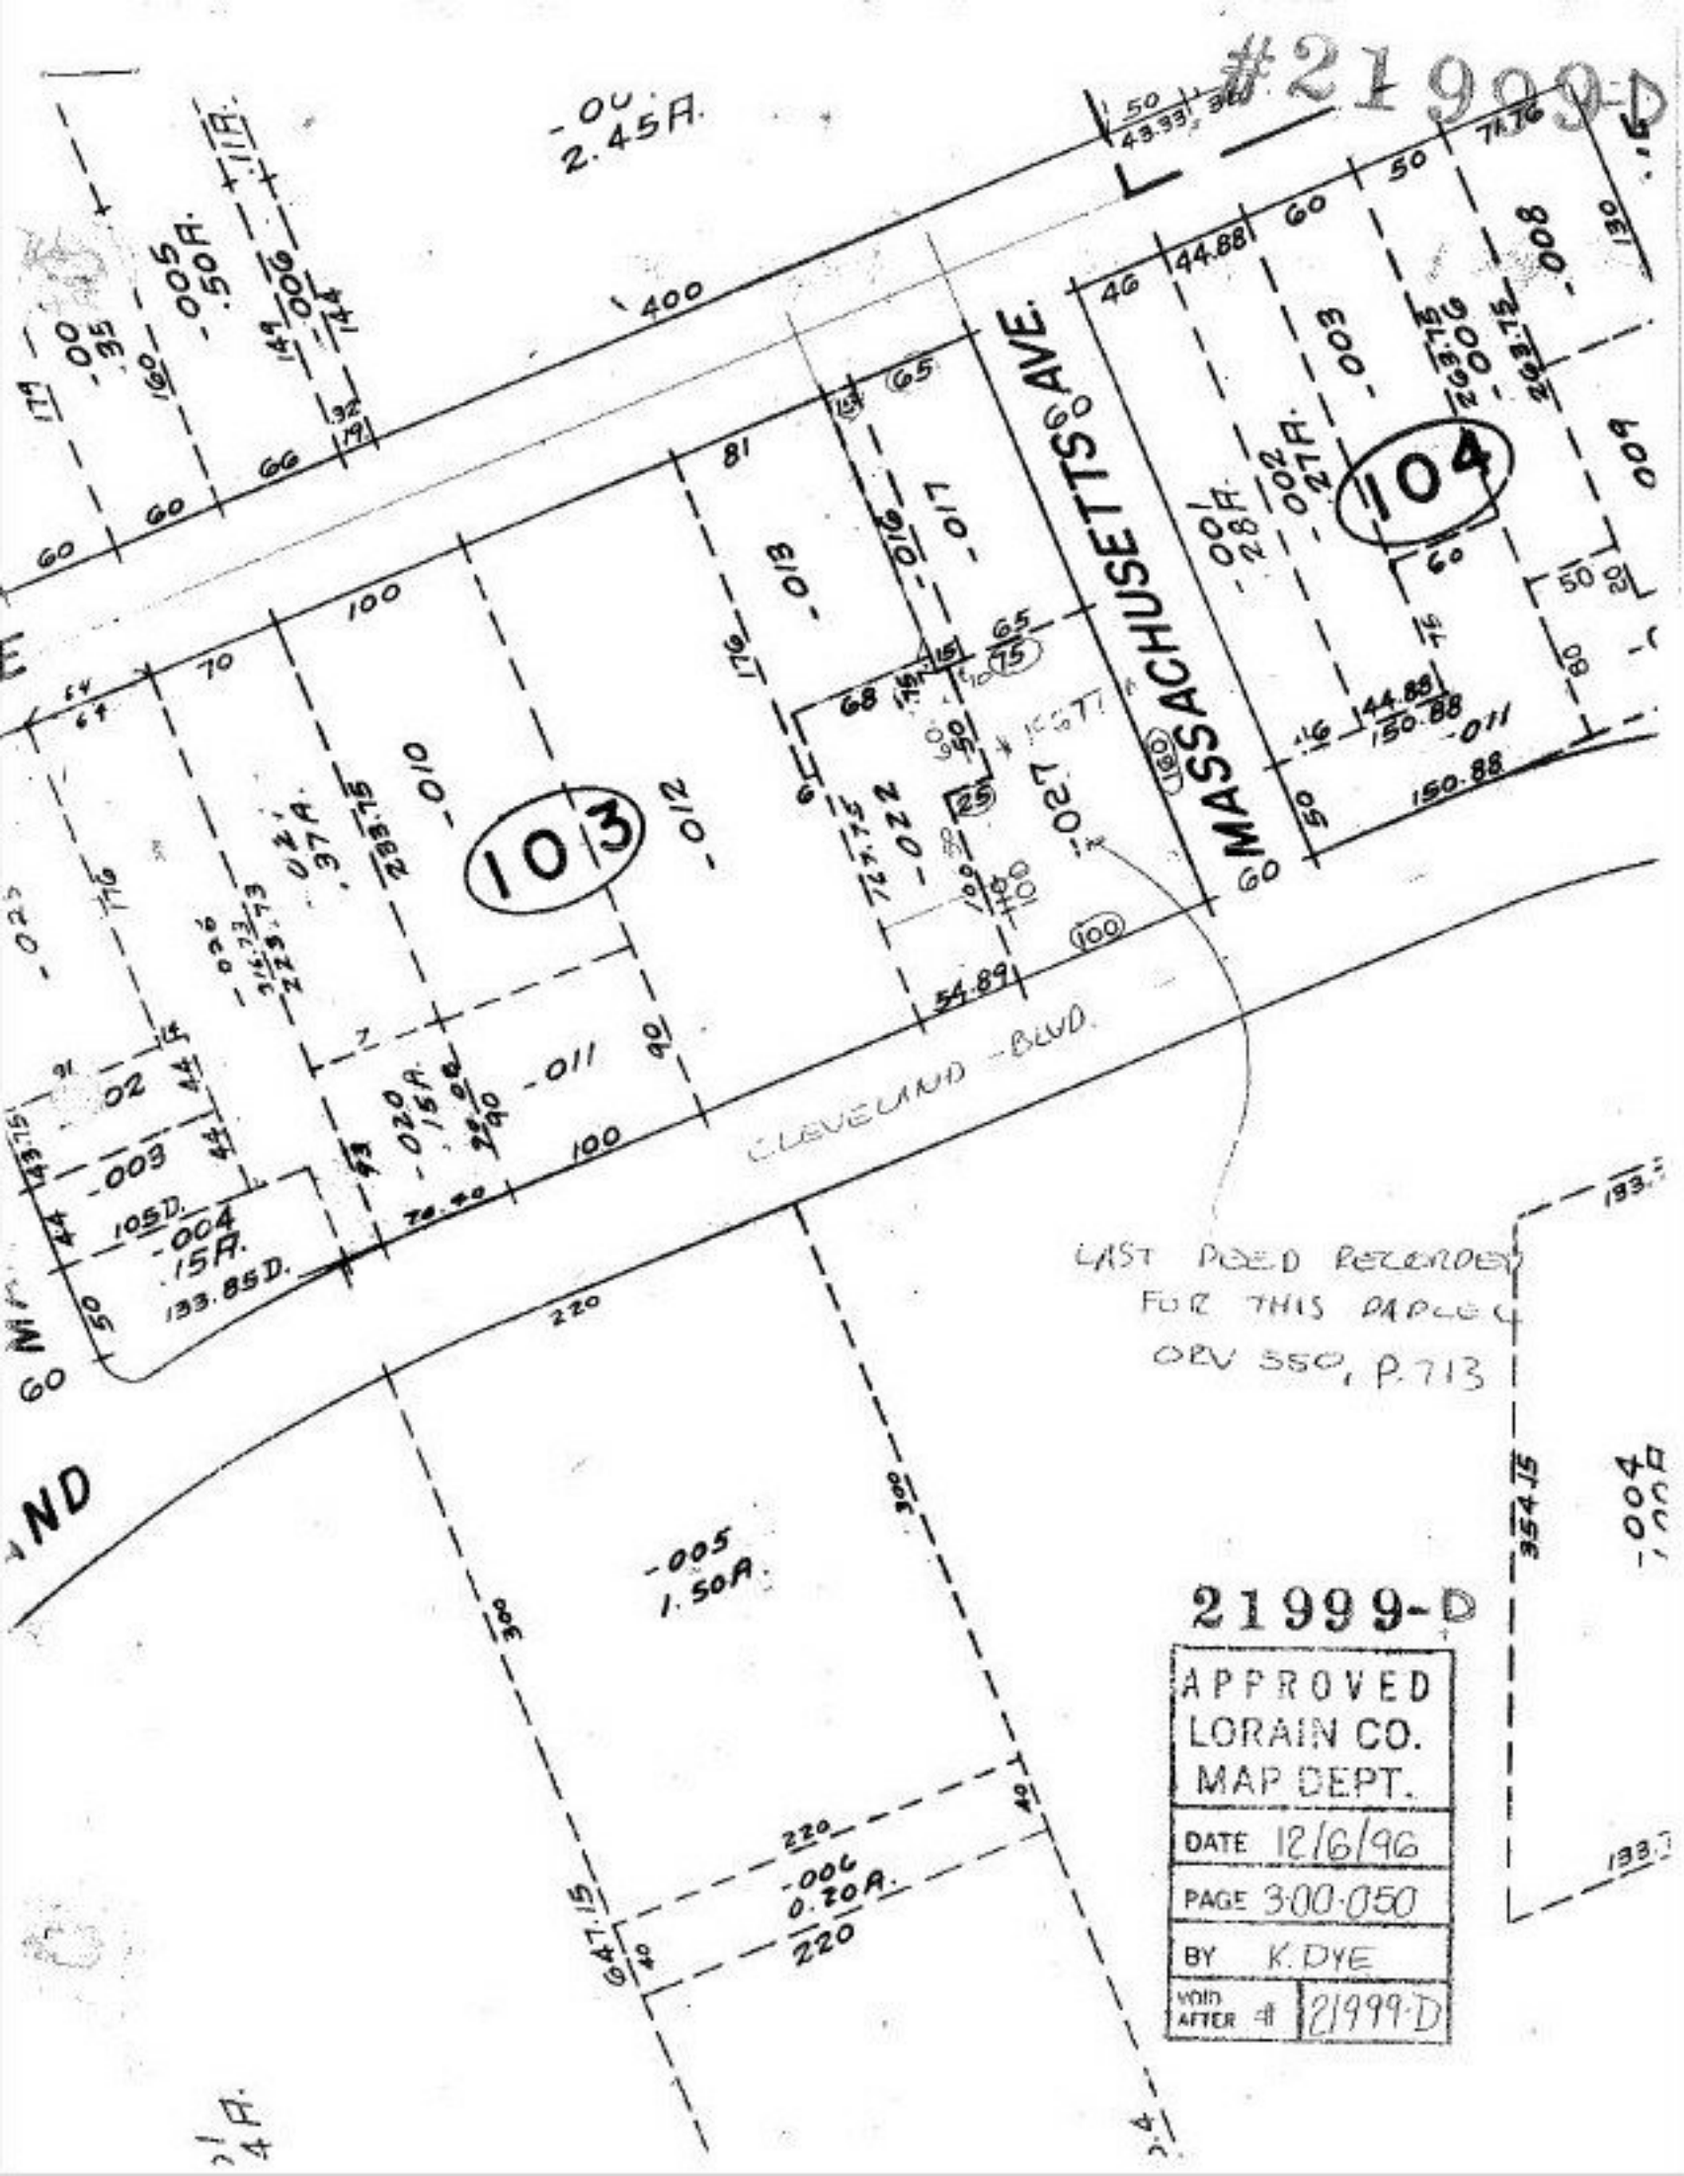
#21999-D
2.45A.
400
MASSACHUSETTS AVE.
103
104
CLEVELAND BLVD.
LAST DEED RECORDED FOR THIS PARCEL OR V 550, P. 713
1.50A.
0.20A.
21999-D
APPROVED
LORAIN CO.
MAP DEPT.
DATE 12/6/96
PAGE 300-050
BY K. DYE
