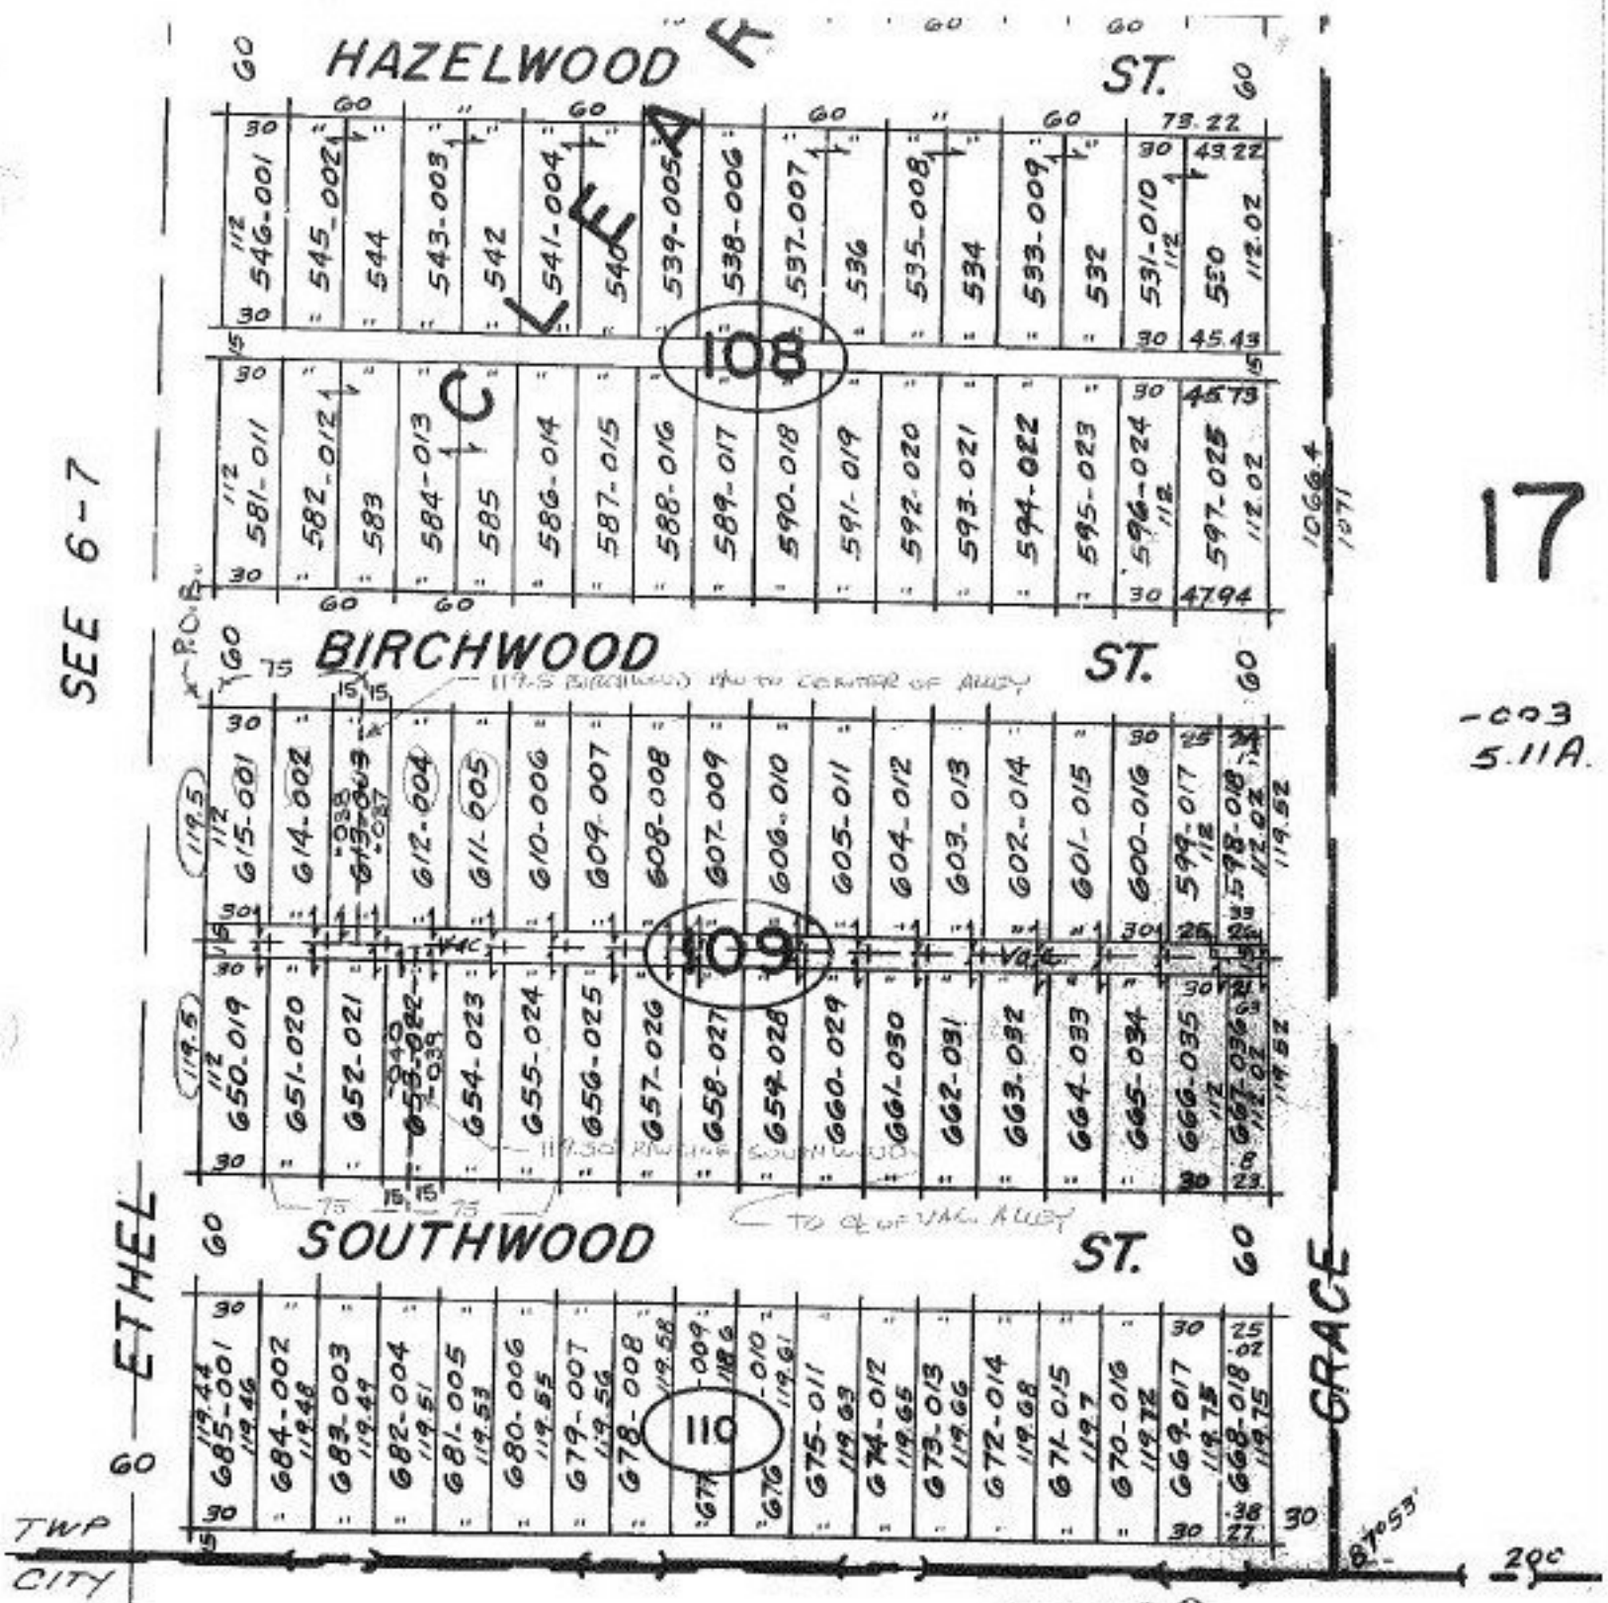

17

-003
5.11A.

PRIOR INSTRUMENT 893-404
CLOSURE 0.02 PER 10,000
SURVEYED BY DANE A. HAPONEK

21999
PP 9-23-97

APPROVED
LORAIN CO.
MAP DEPT.
DATE 12-04-96
PAGE 6-B
BY B. BELL
WORK SHEET # 21999

EFFECTIVE 5/9/97

Pt.-003
Pt 20.90A