# #22001

PT. - 181
PT. 24.56 A.

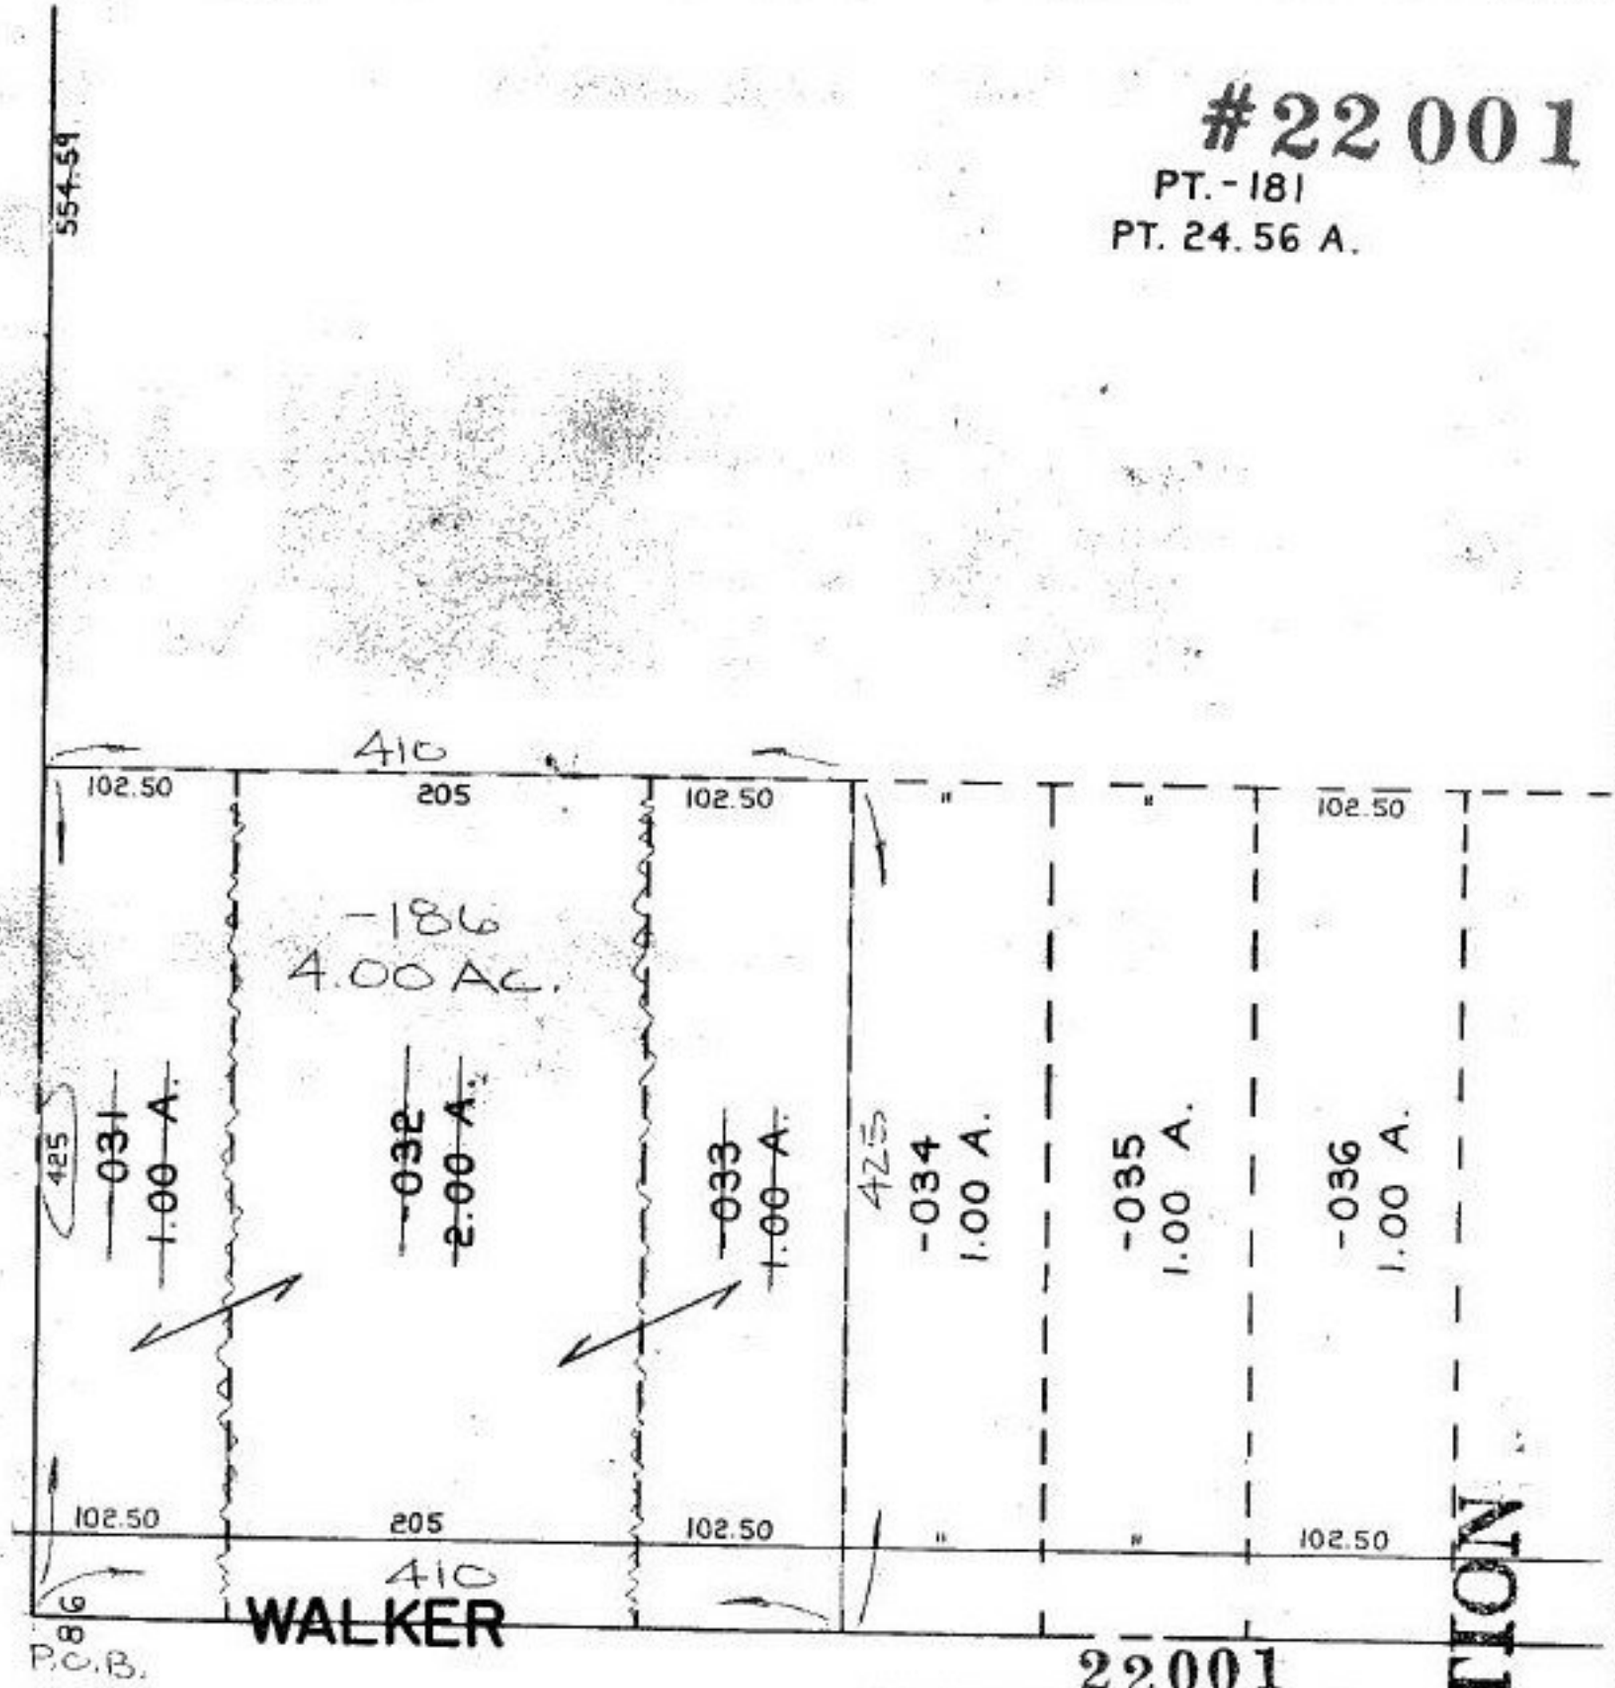


22001

SEE 4-00-017-A

APPROVED
LORAIN CO.
MAP DEPT.
DATE 12-04-96
PAGE 4-00-016I
BY R. BELL
WORK ORDER # 122001

COMBINATION