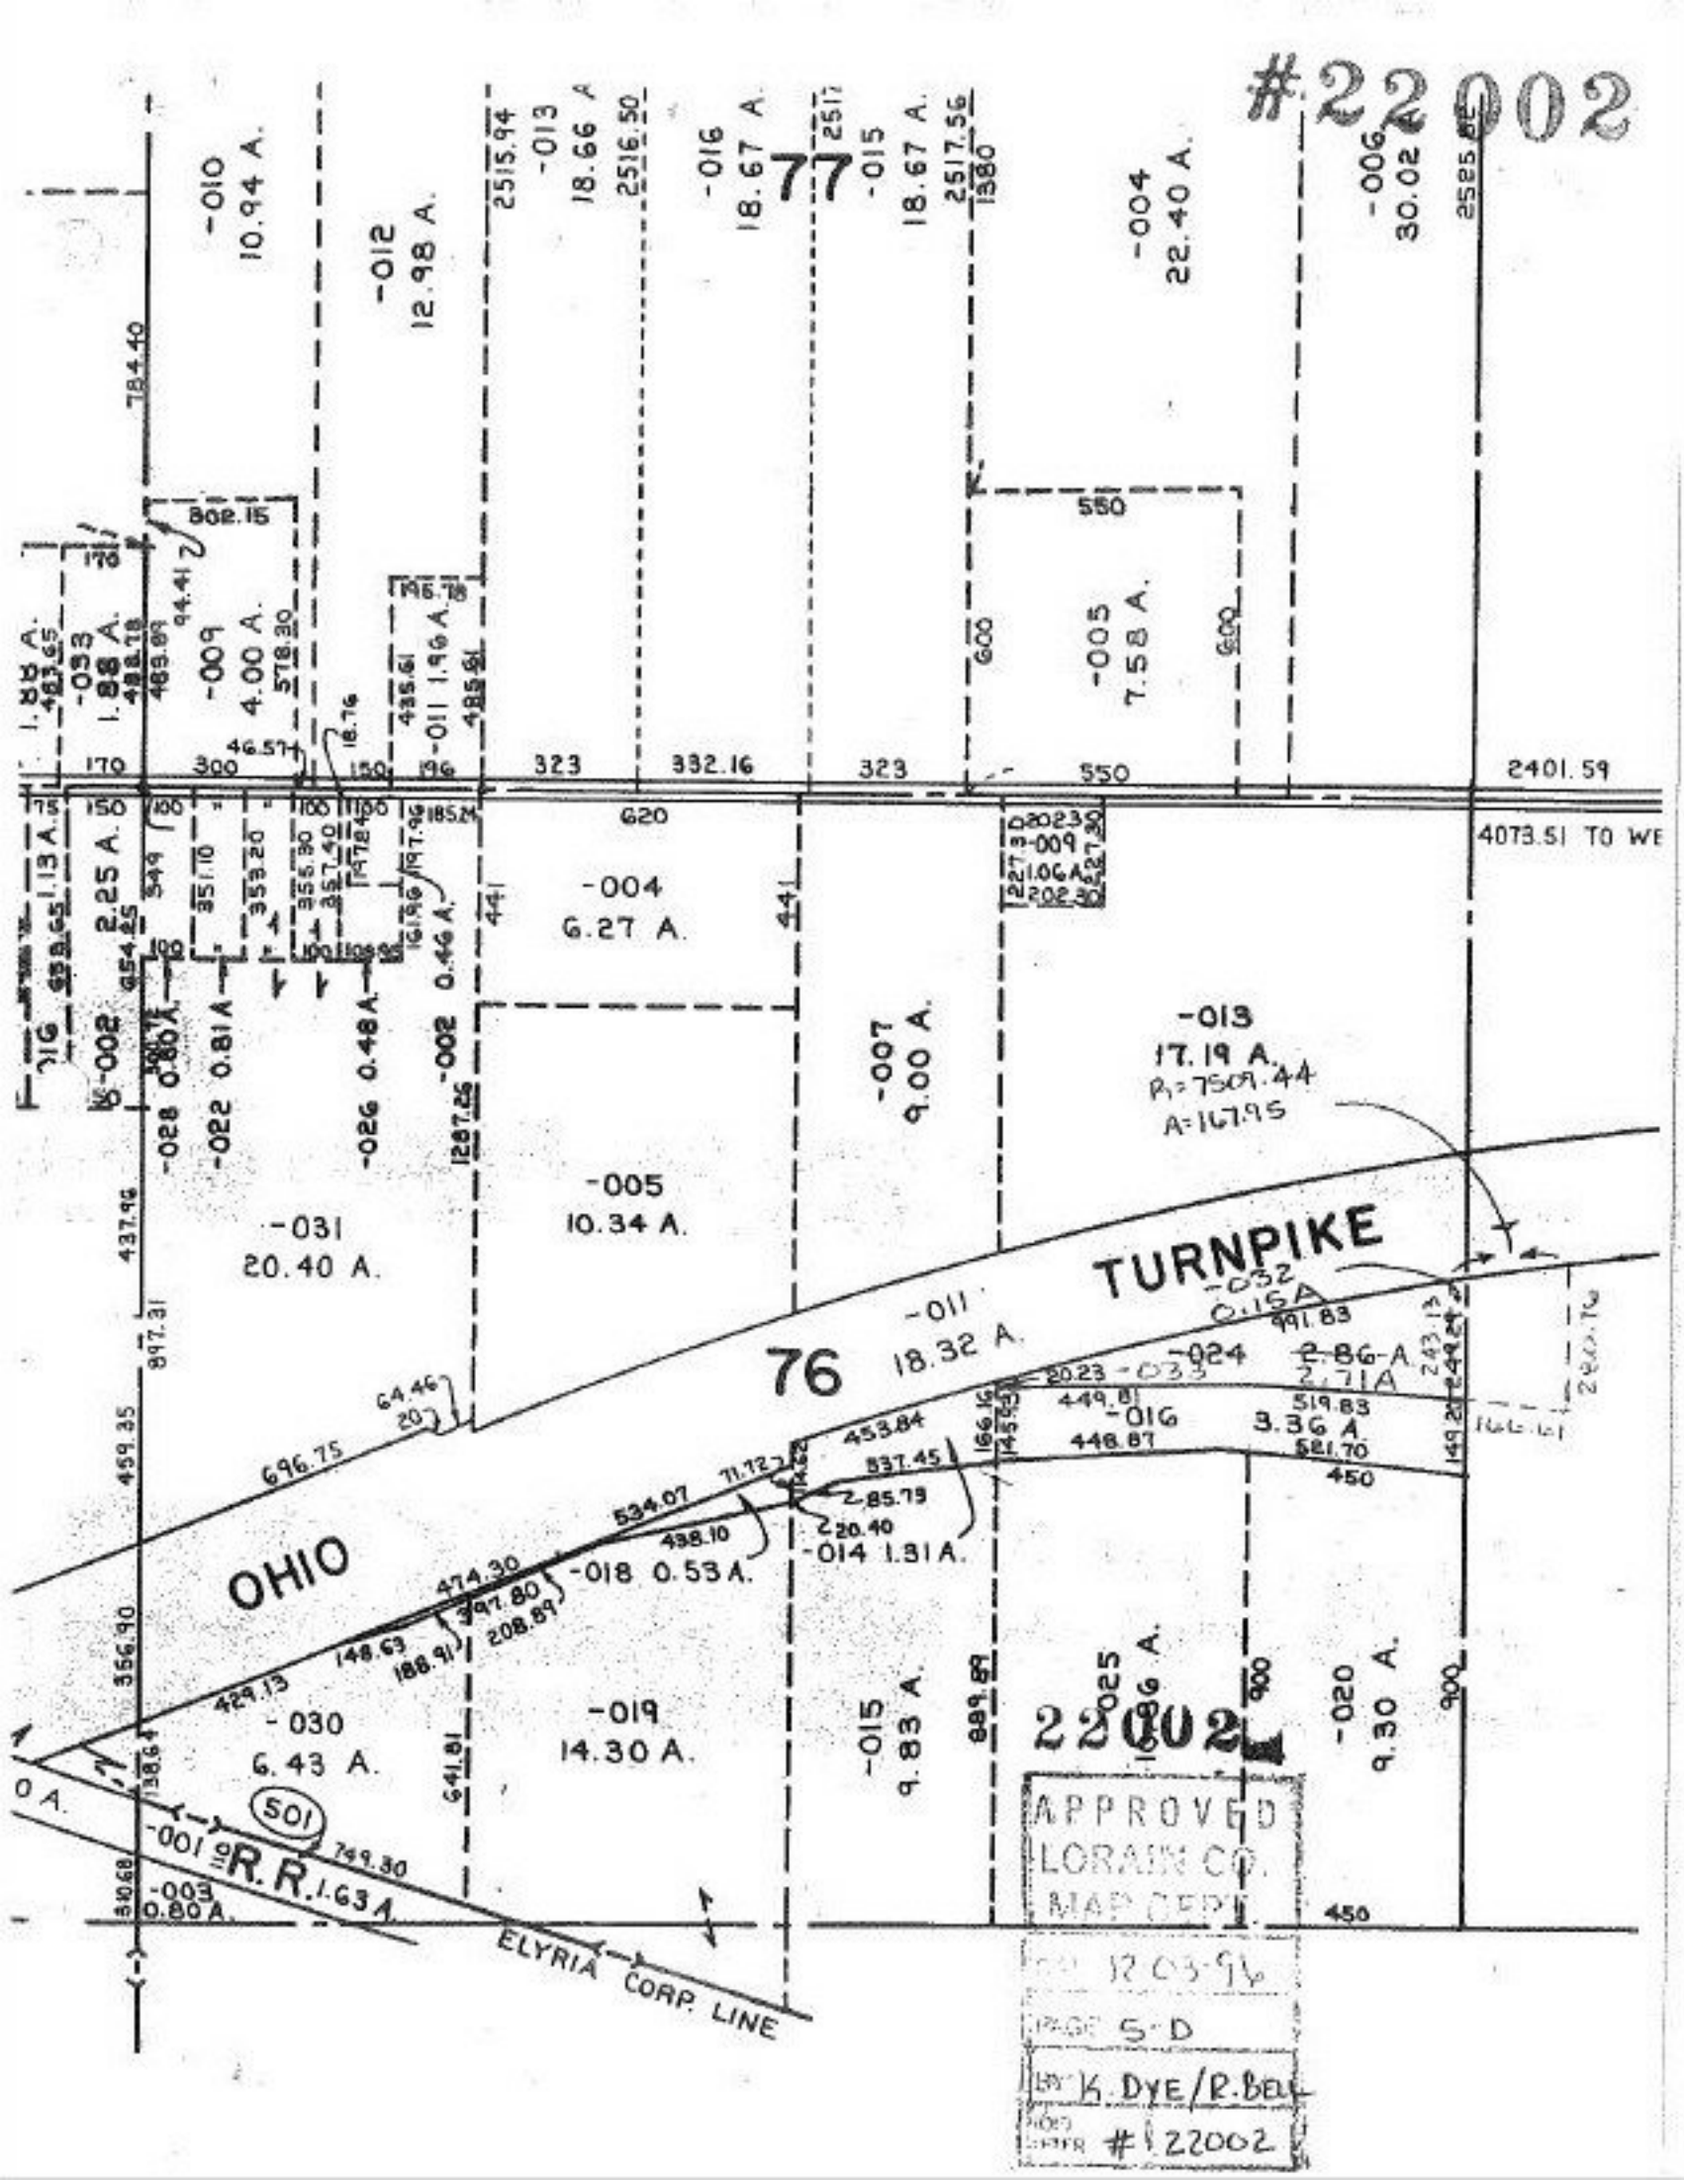
#22002
-010 10.94 A.
-012 12.98 A.
-013 18.66 A.
-016 18.67 A.
77
-015 18.67 A.
-004 22.40 A.
-006 30.02 A.
-033 1.88 A.
-009 4.00 A.
-011 1.96 A.
-005 7.58 A.
-004 6.27 A.
-002 0.80 A.
-028 0.80 A.
-022 0.81 A.
-026 0.48 A.
-002 0.46 A.
-007 9.00 A.
-013 17.19 A.
R=7509.44
A=167.95
-031 20.40 A.
-005 10.34 A.
TURNPIKE
-011 18.32 A.
76
-032 0.15 A.
-024 2.86 A.
2.71 A.
-016 3.36 A.
OHIO
-018 0.53 A.
-014 1.31 A.
-030 6.43 A.
-019 14.30 A.
-015 9.83 A.
-025 1.86 A.
-020 9.30 A.
501
-001 R.R. 1.63 A.
-003 0.80 A.
ELYRIA CORP. LINE
APPROVED
LORAIN CO.
MAP DEPT.
12-03-96
PAGE 5-D
BY K. DYE/R. BELL
#122002