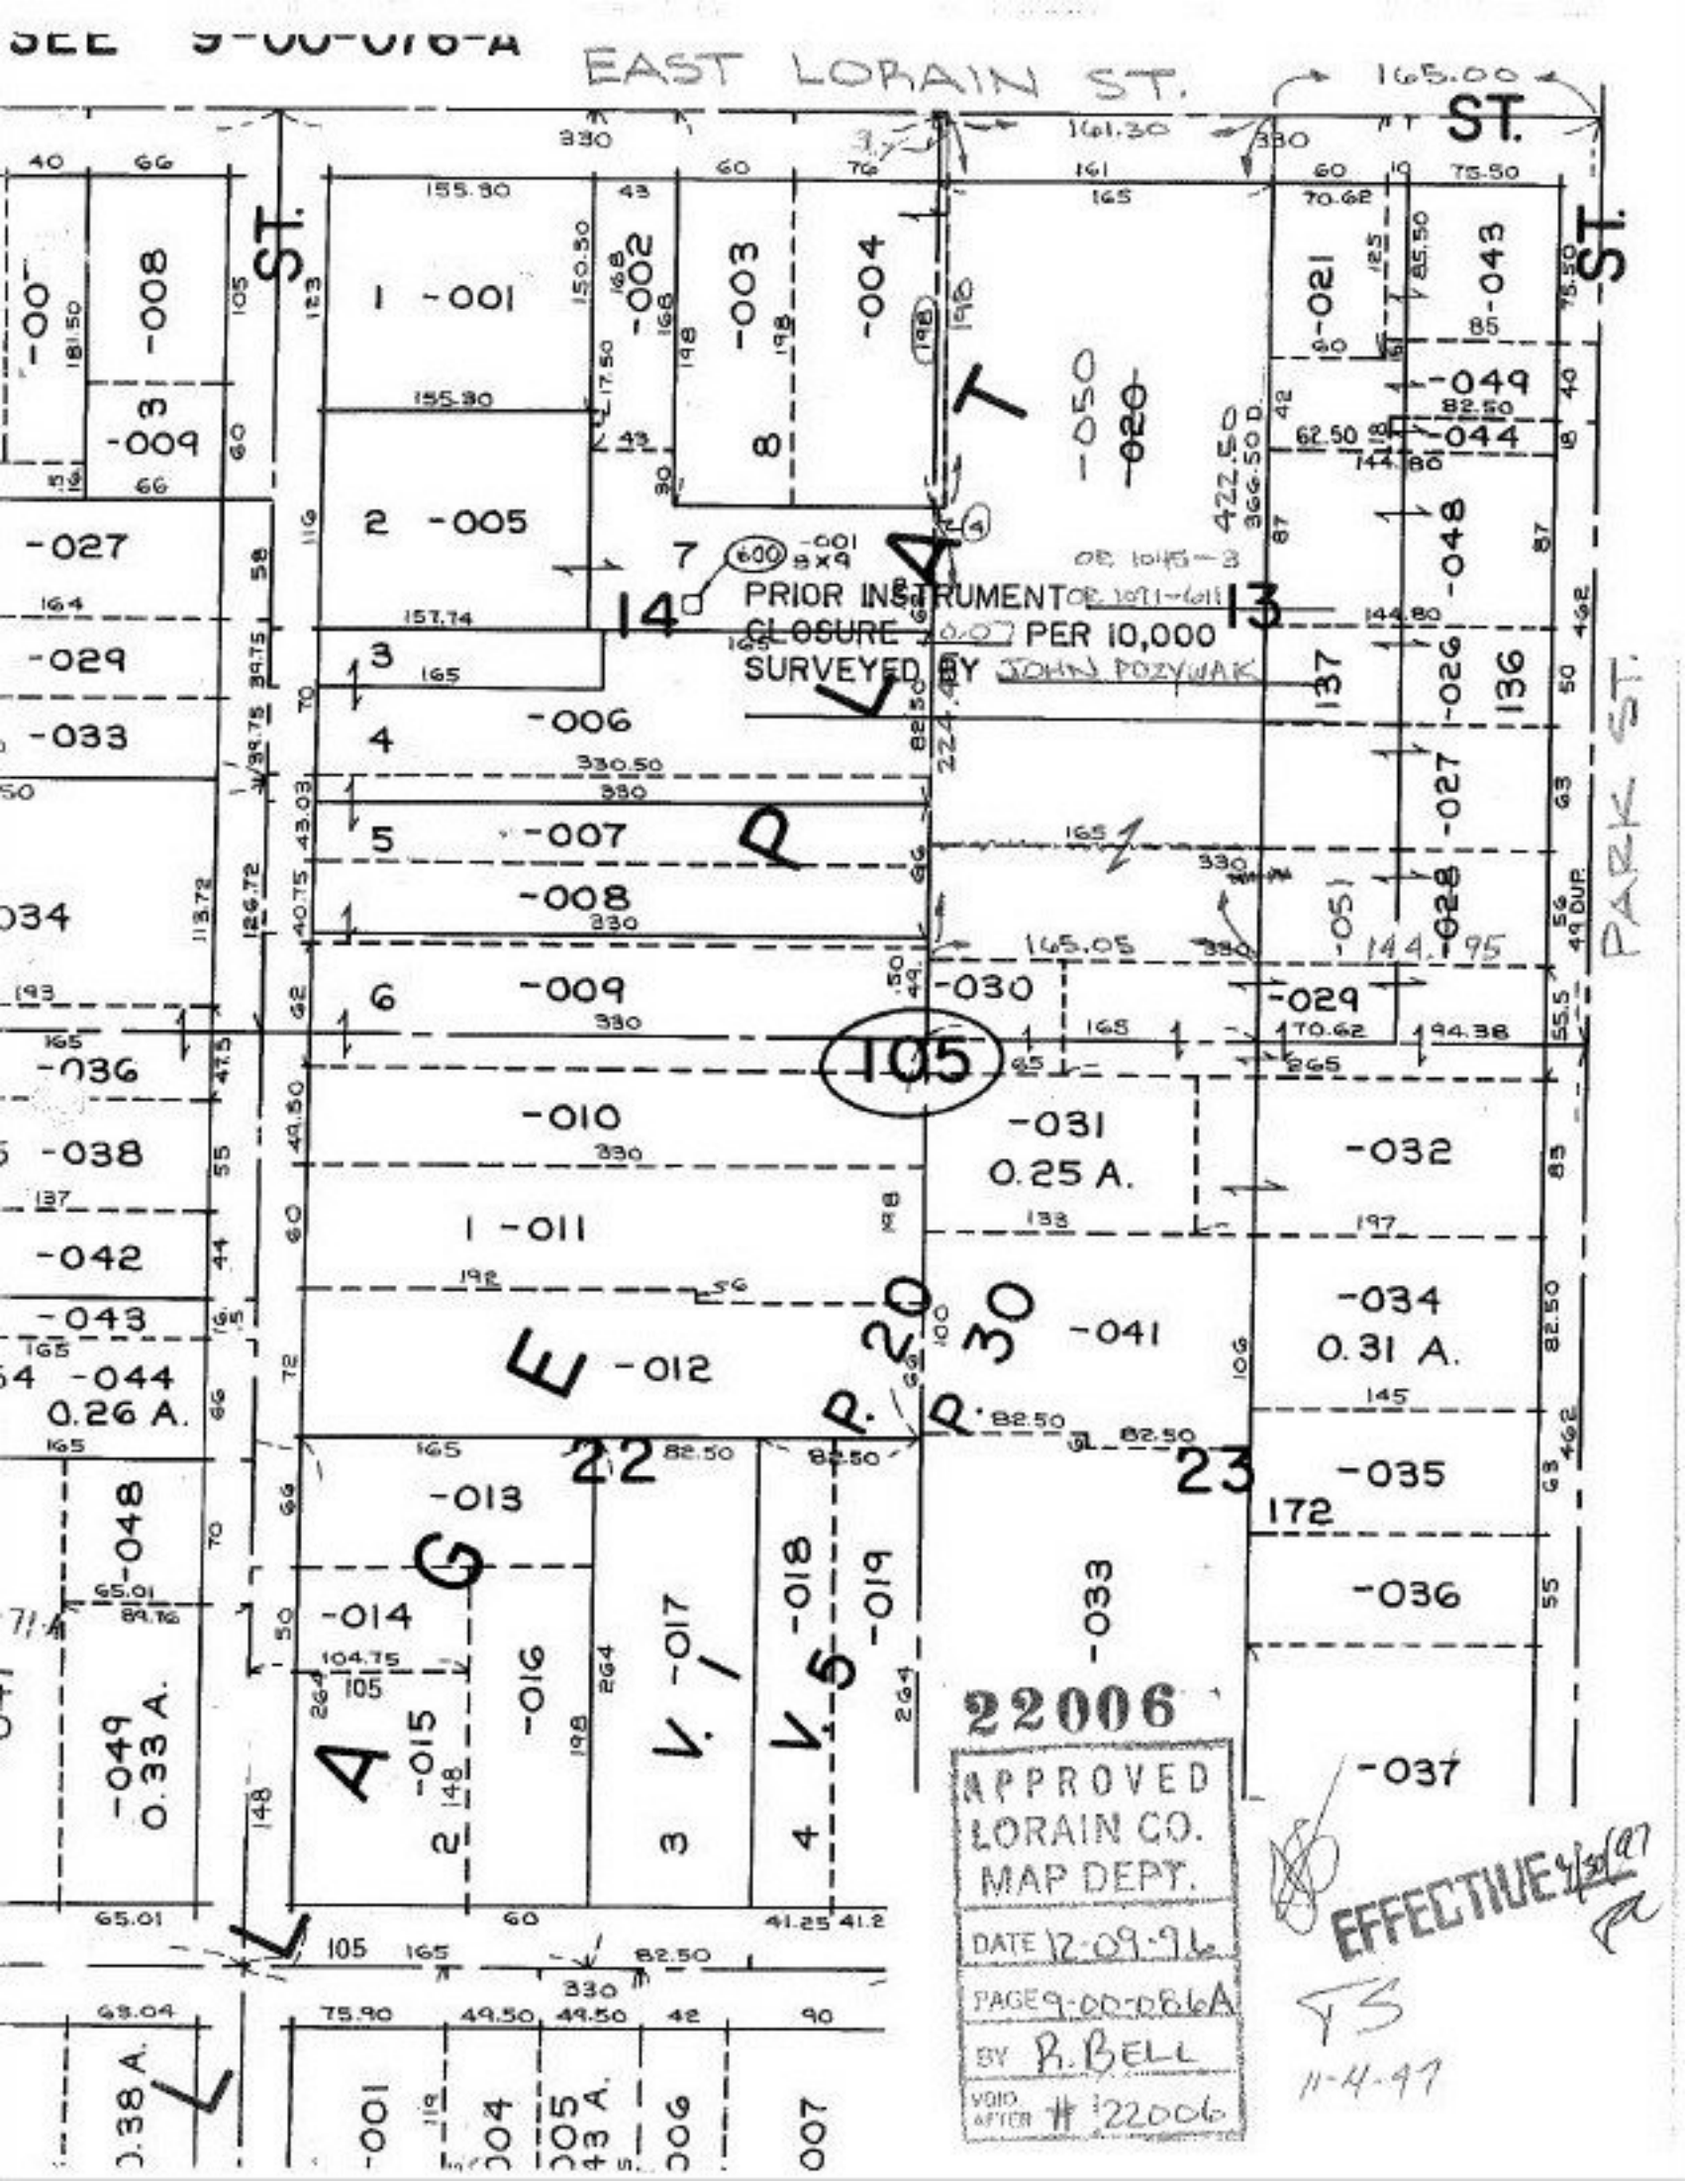
SEE 9-00-076-A
EAST LORAIN ST.
165.00
ST.
PARK ST.
PRIOR INSTRUMENT OR 1071-611
CLOSURE 1.0 PER 10,000
SURVEYED BY JOHN POZYWAK
105
22006
APPROVED
LORAIN CO.
MAP DEPT.
DATE 12-09-96
BY R. BELL
VOID AFTER # 22006
EFFECTIVE 1/1/97
11-4-97