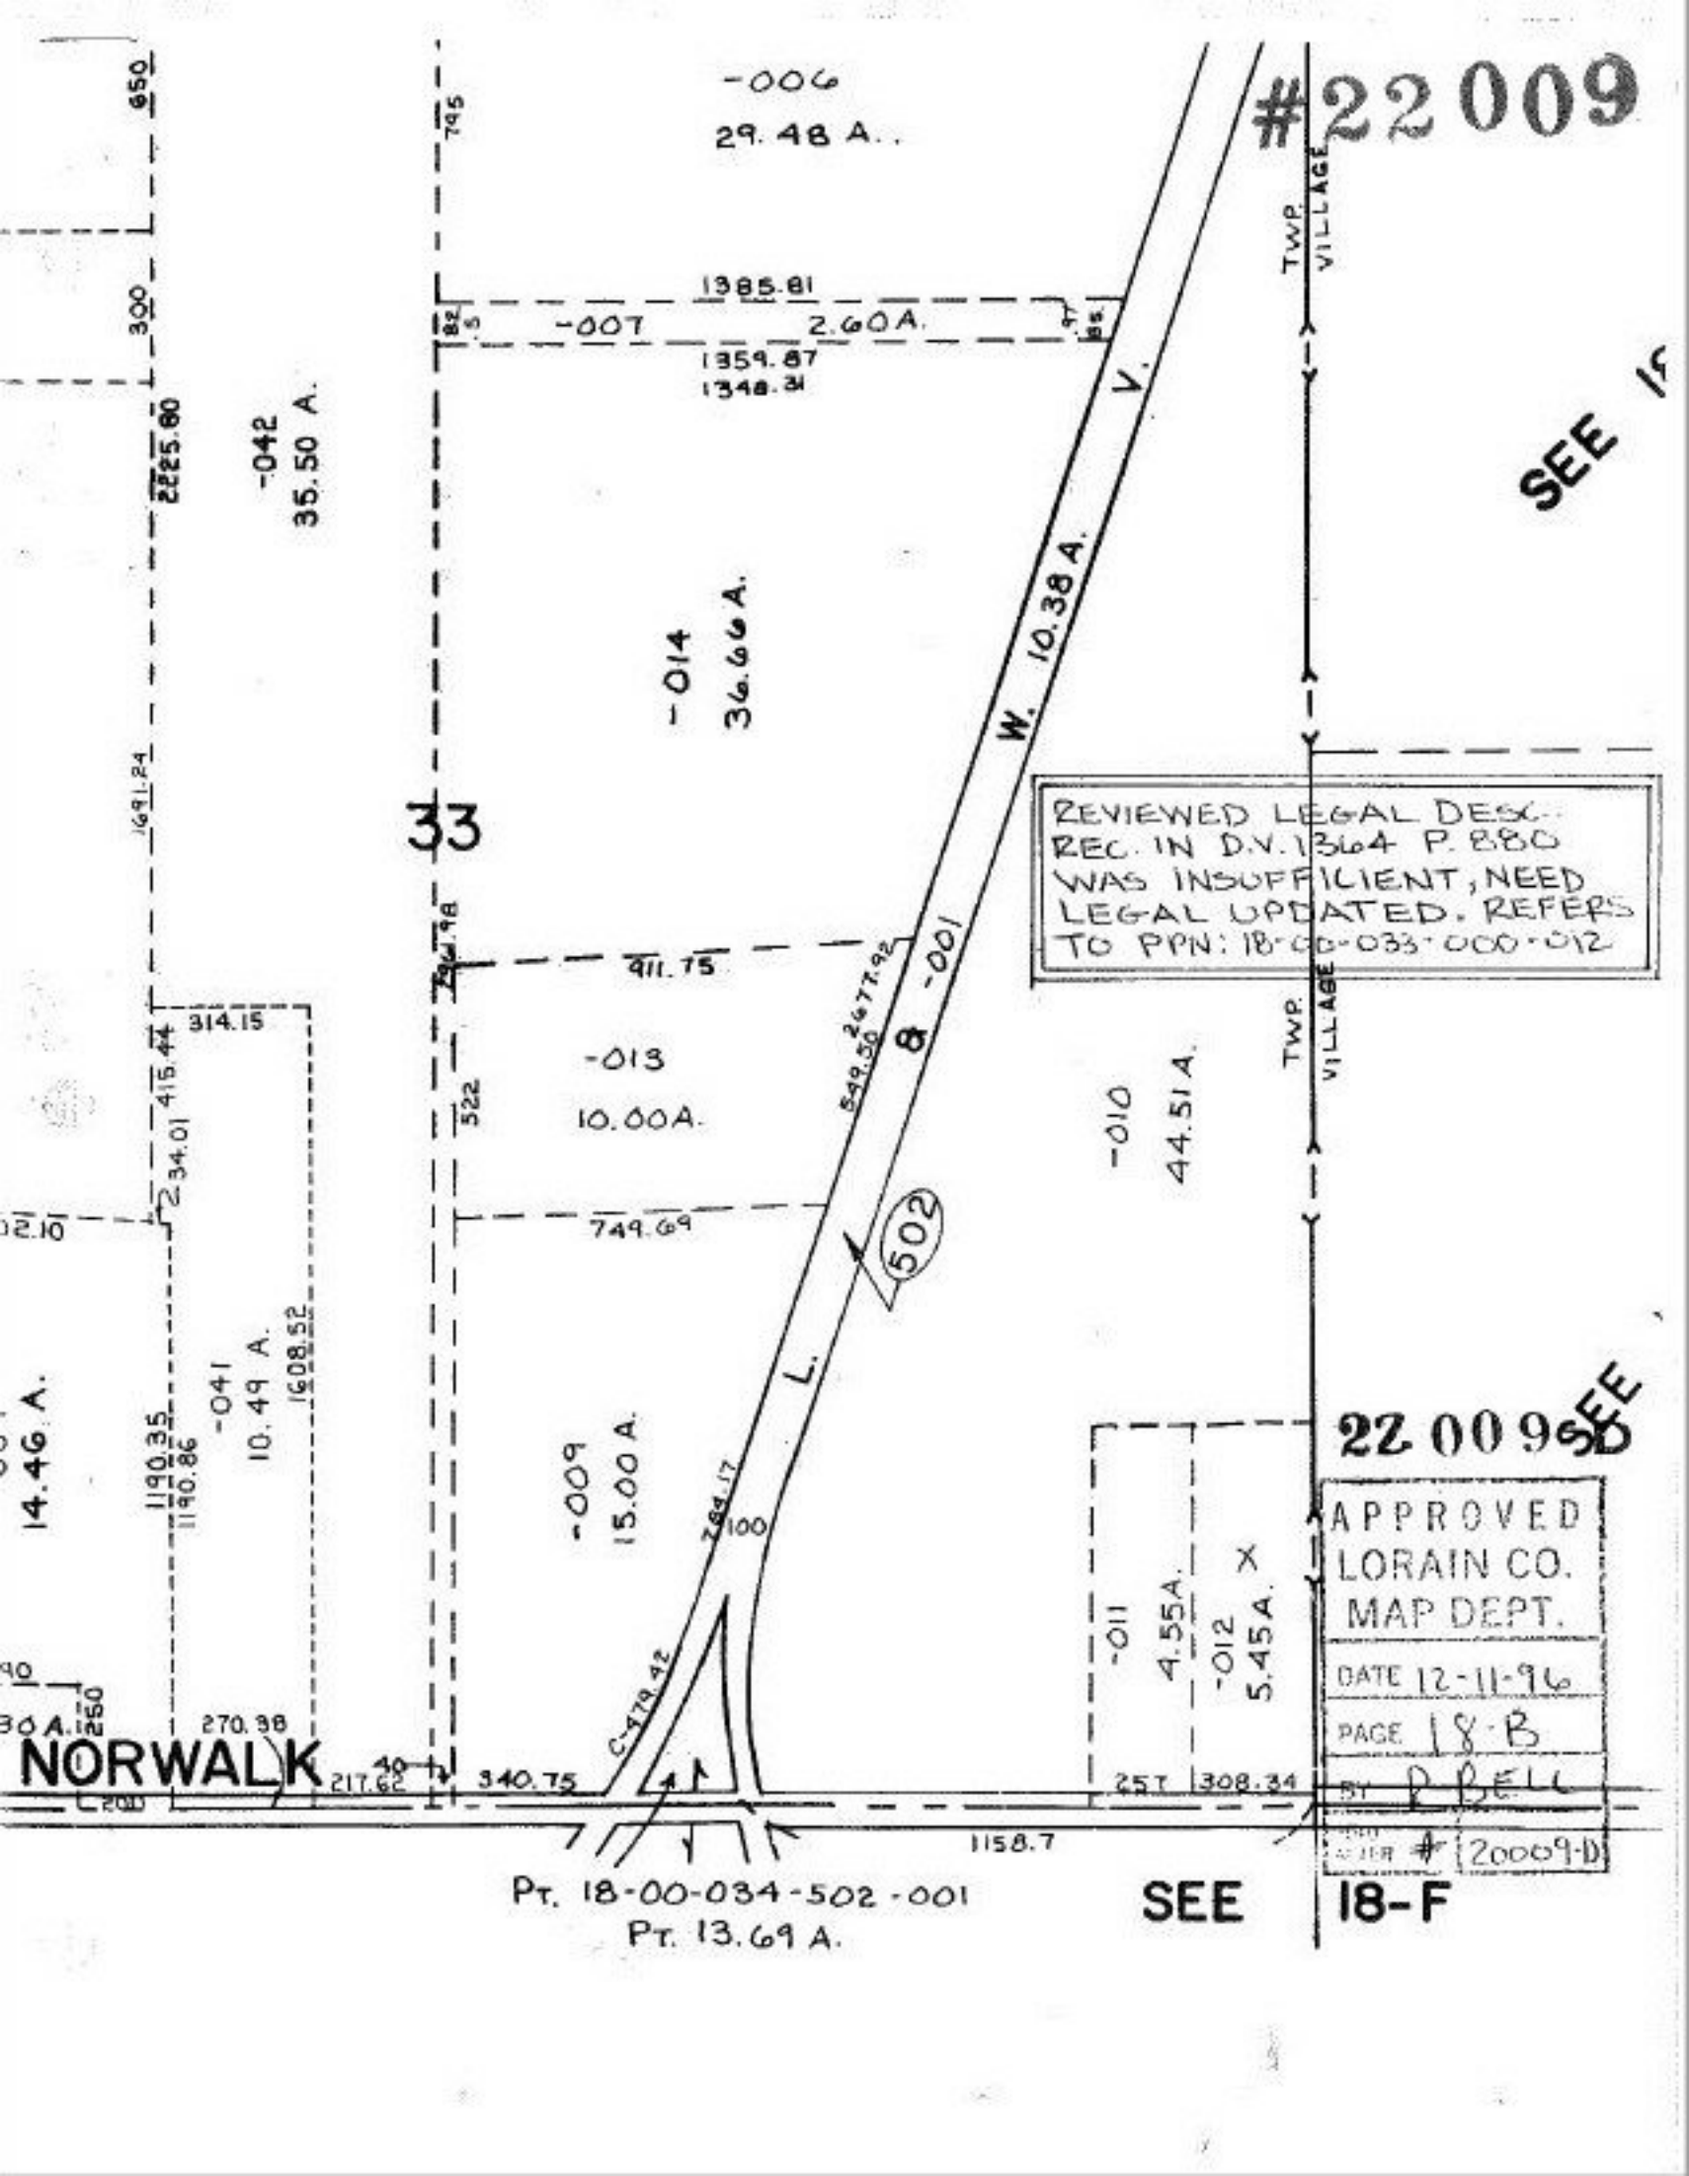
#22009
-006
29.48 A.
1385.81
-007
2.60A.
1359.87
1348.31
-042
35.50 A.
2225.60
-014
36.66 A.
33
W. 10.38 A.
V.
TWP. VILLAGE
SEE
REVIEWED LEGAL DESC.
REC. IN D.V. 1364 P. 880
WAS INSUFFICIENT, NEED
LEGAL UPDATED. REFERS
TO PPN: 18-00-033-000-012
911.75
-013
10.00A.
-010
44.51 A.
-001
8
L.
502
-041
10.49 A.
-009
15.00 A.
-011
4.55A.
-012
5.45A.
X
22009
SEE
APPROVED
LORAIN CO.
MAP DEPT.
DATE 12-11-96
PAGE 18-B
BY D BELL
ADJR # 20009-D
NORWALK
270.98
340.75
308.34
1158.7
Pt. 18-00-034-502-001
Pt. 13.69 A.
SEE 18-F