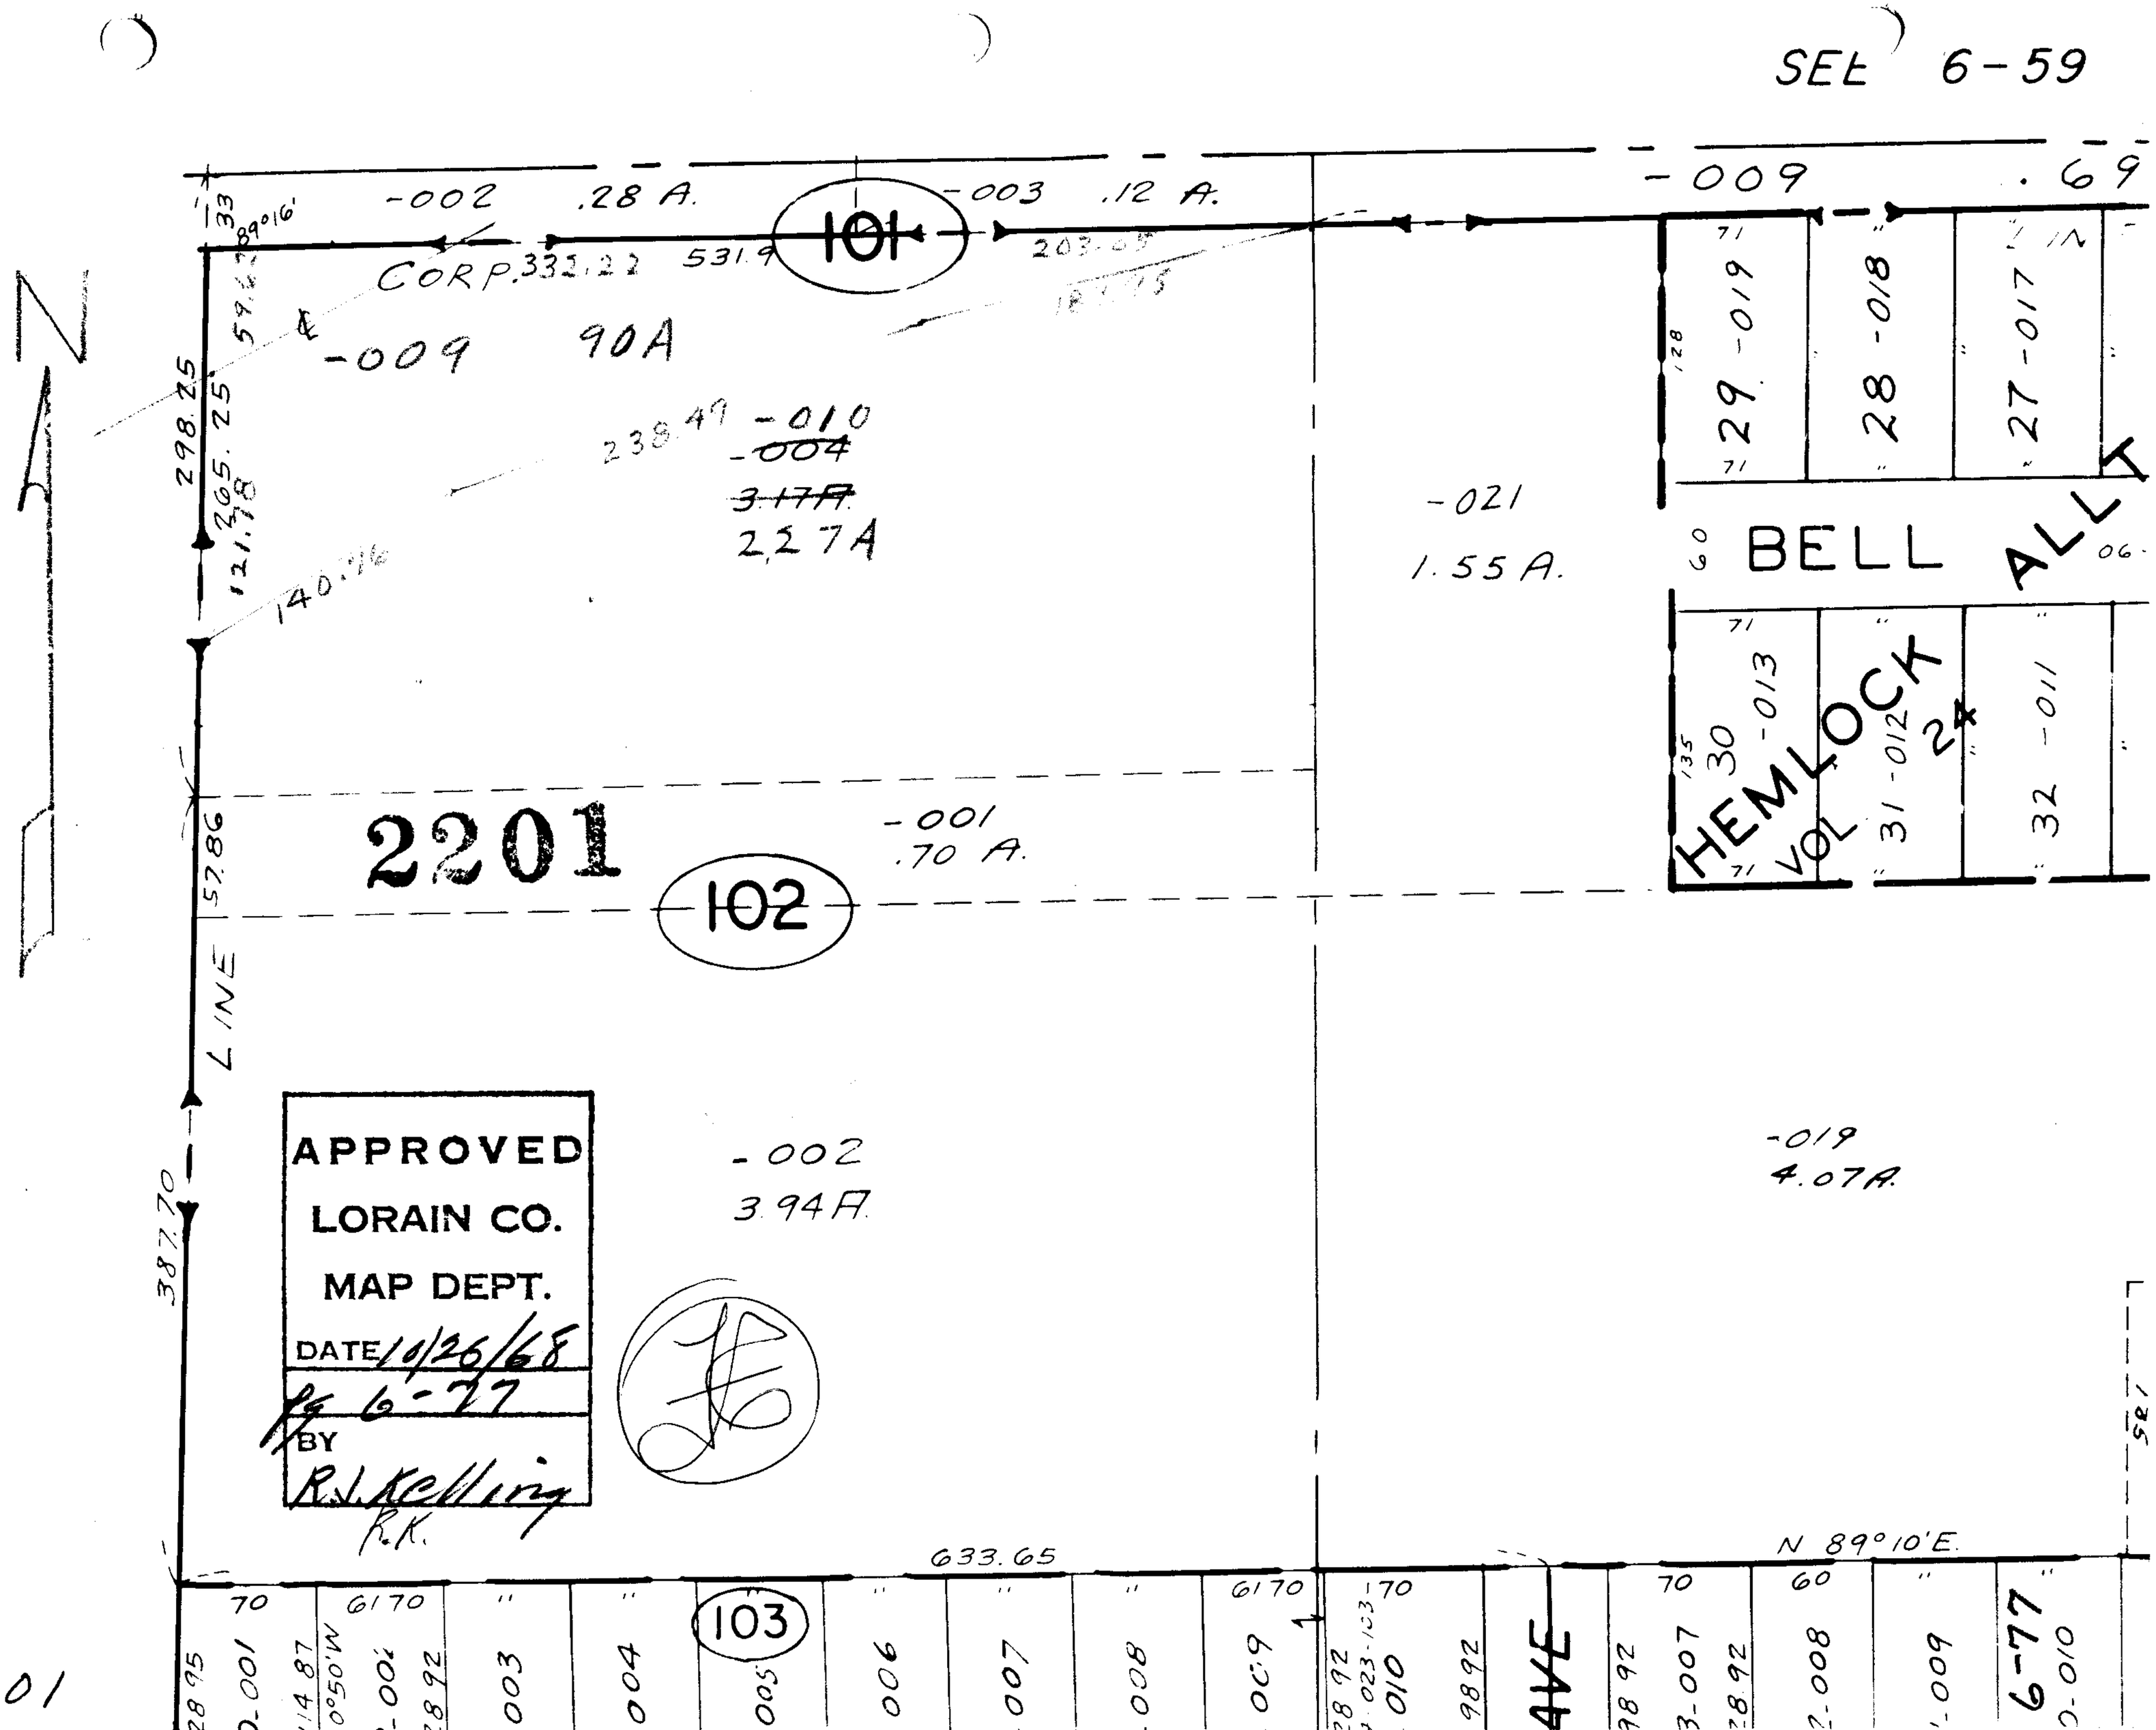
SEE 6-59
-002 .28 A.
-003 .12 A.
-009 .69
101
CORP. 332.22 531.9
-009 90A
-010
~~-004~~
~~3.17A~~
2.27A
238.49
298.25
265.25
121.78
140.76
-021
1.55 A.
29 -019
28 -018
27 -017
BELL ALLT
HEMLOCK VOL 24
30 -013
31 -012
32 -011
2201
-001
.70 A.
102
57.86
LINE
387.70
-002
3.94A
-019
4.07A
APPROVED
LORAIN CO.
MAP DEPT.
DATE 10/26/68
Pg 6-77
BY
R.J. Kelling
R.K.
633.65
N 89°10'E.
103
6-77
AVE
2201