#22010

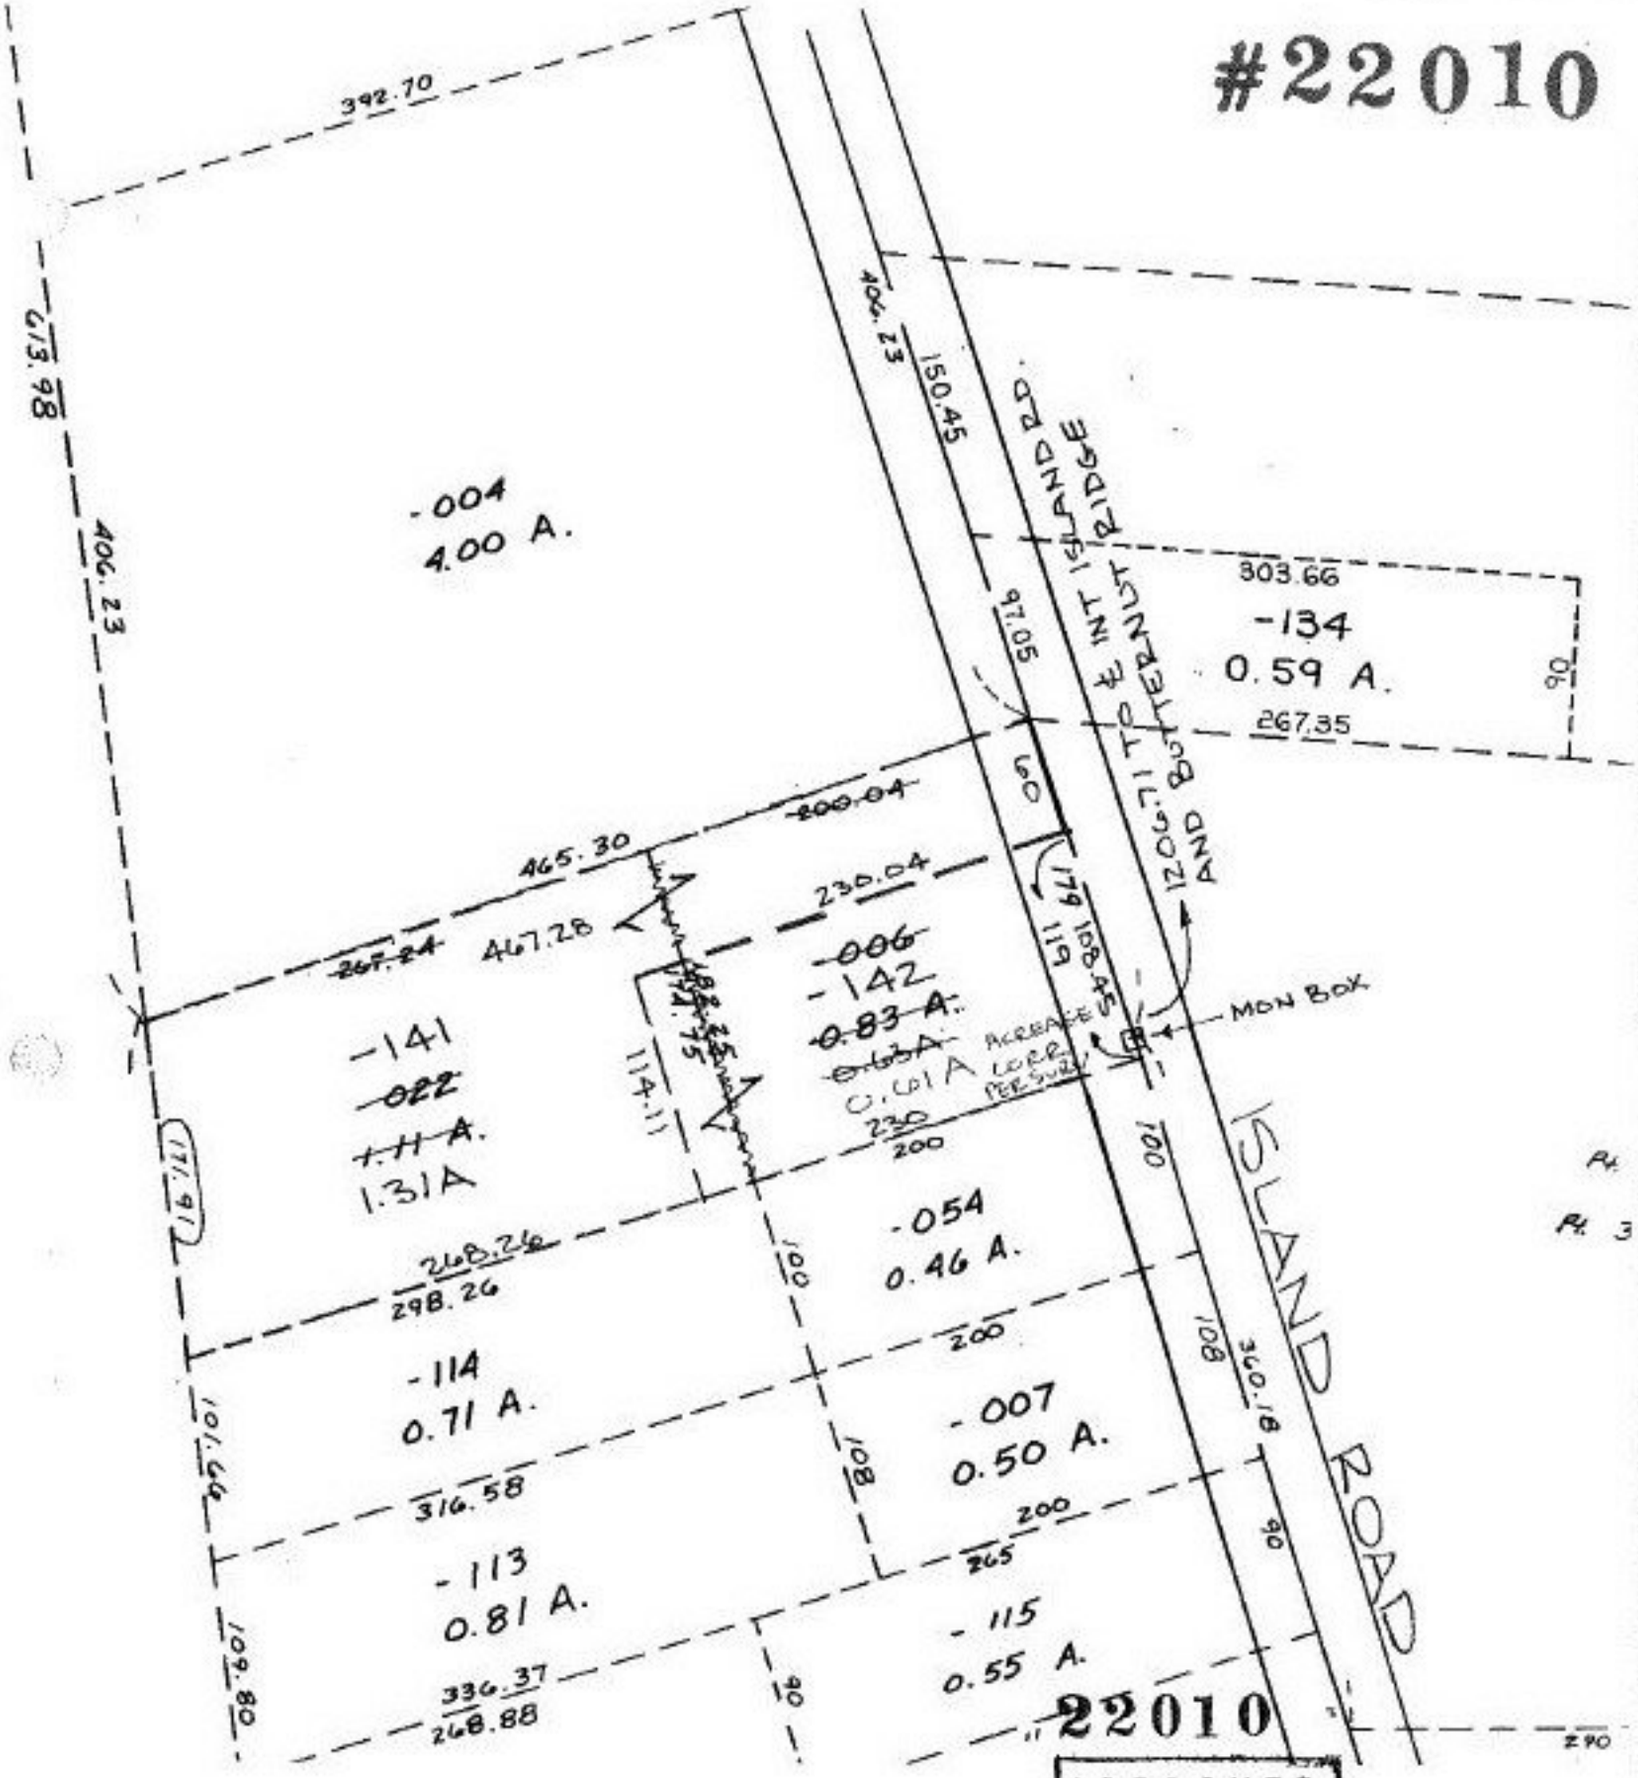

PRIOR INSTRUMENT OR 206-15, 17
CLOSURE 0.09 PER 10,000
SURVEYED BY JOHN PODZYWAK

APPROVED LORAIN CO. MAP DEPT.
DATE 12-09-96
PAGE 7-00-013A
BY R. BELL
MAP NO. #22010