#22011

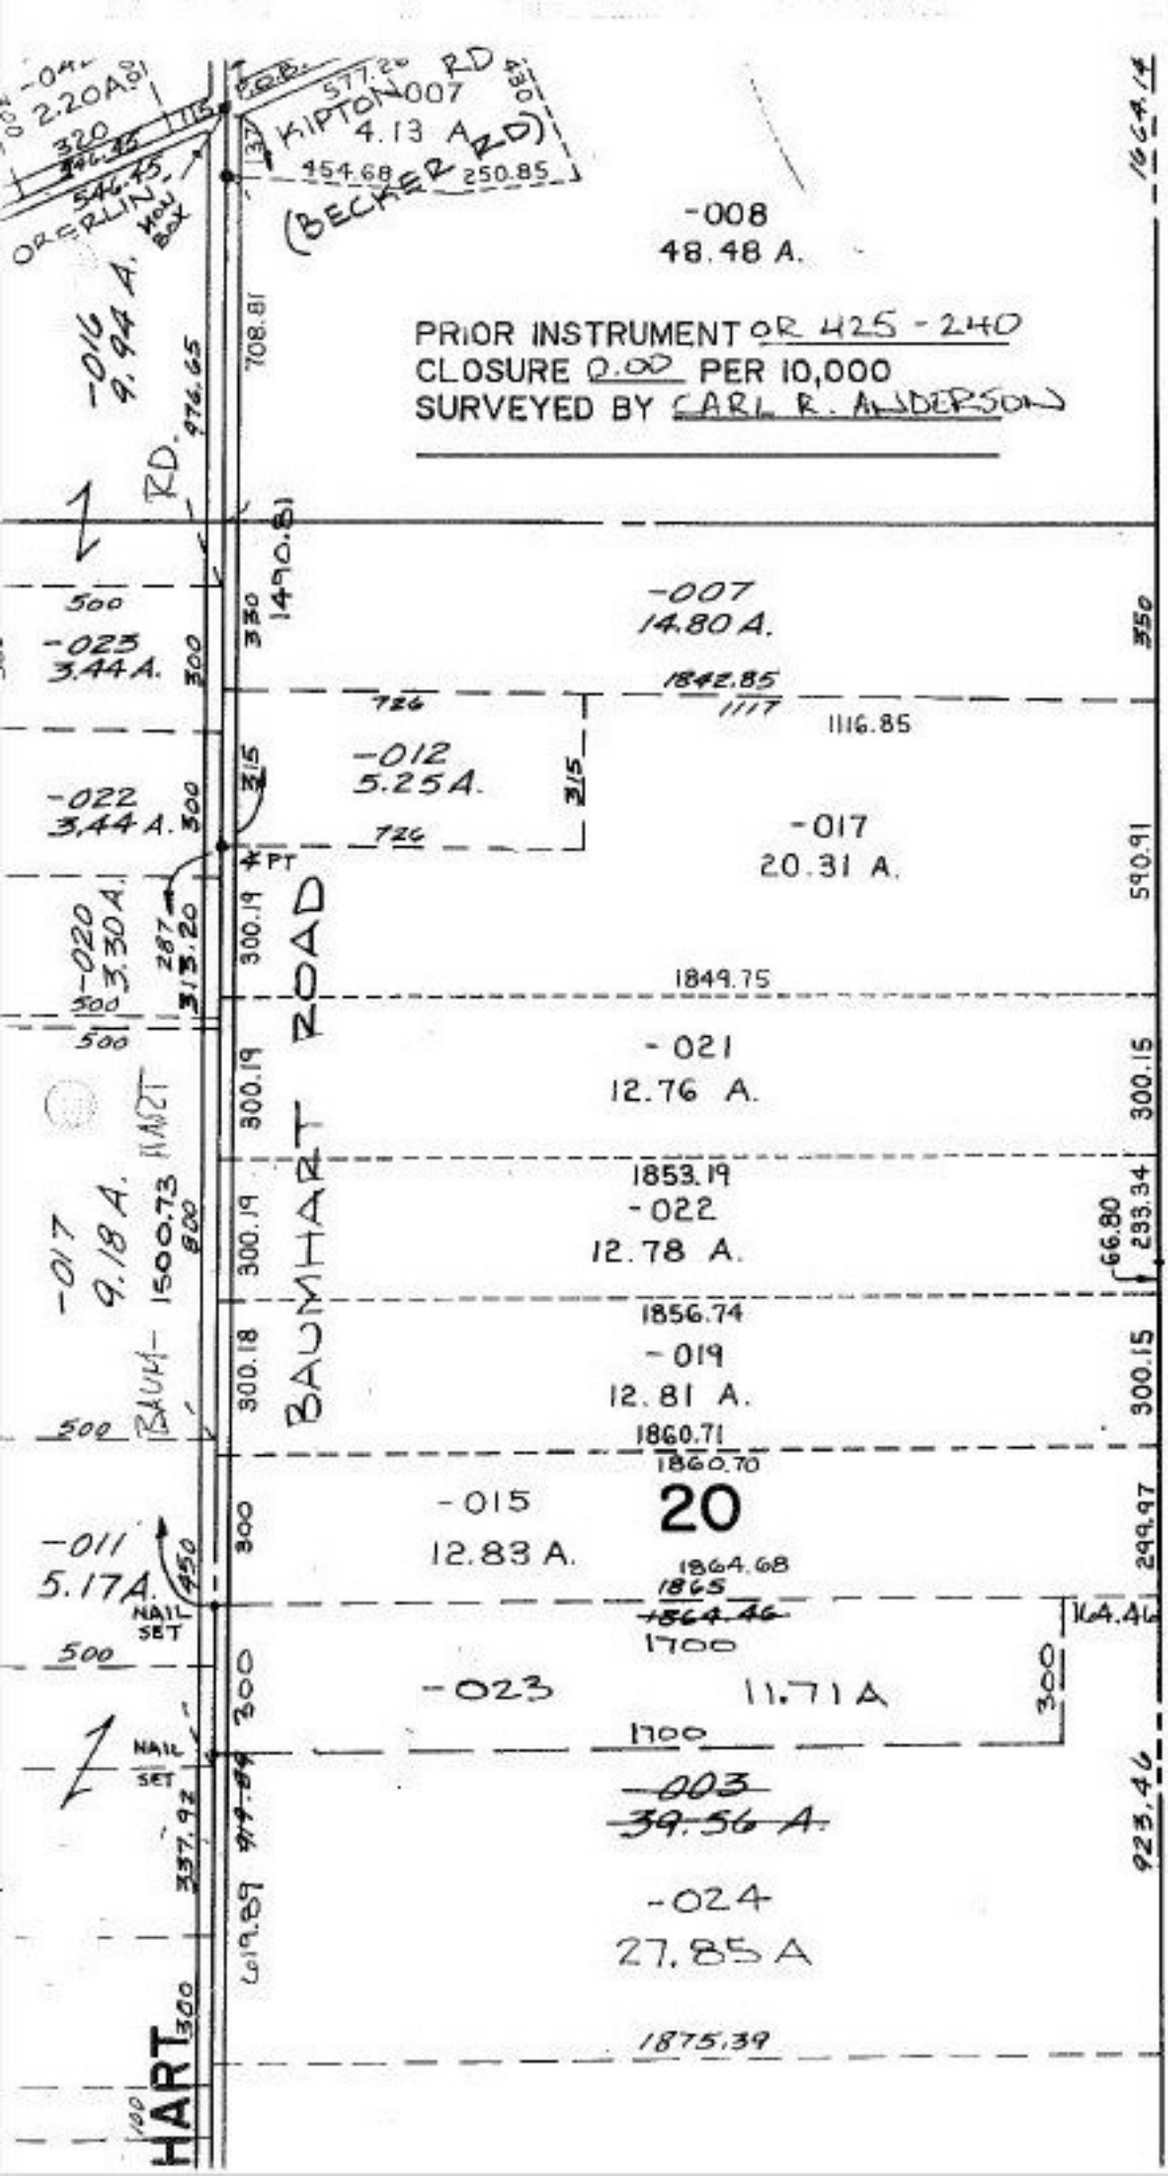

22011

APPROVED
LORAIN CO.
MAP DEPT.
DATE 12-10-96
PAGE B-14
BY R. BELL
VOID TITLE # 22011