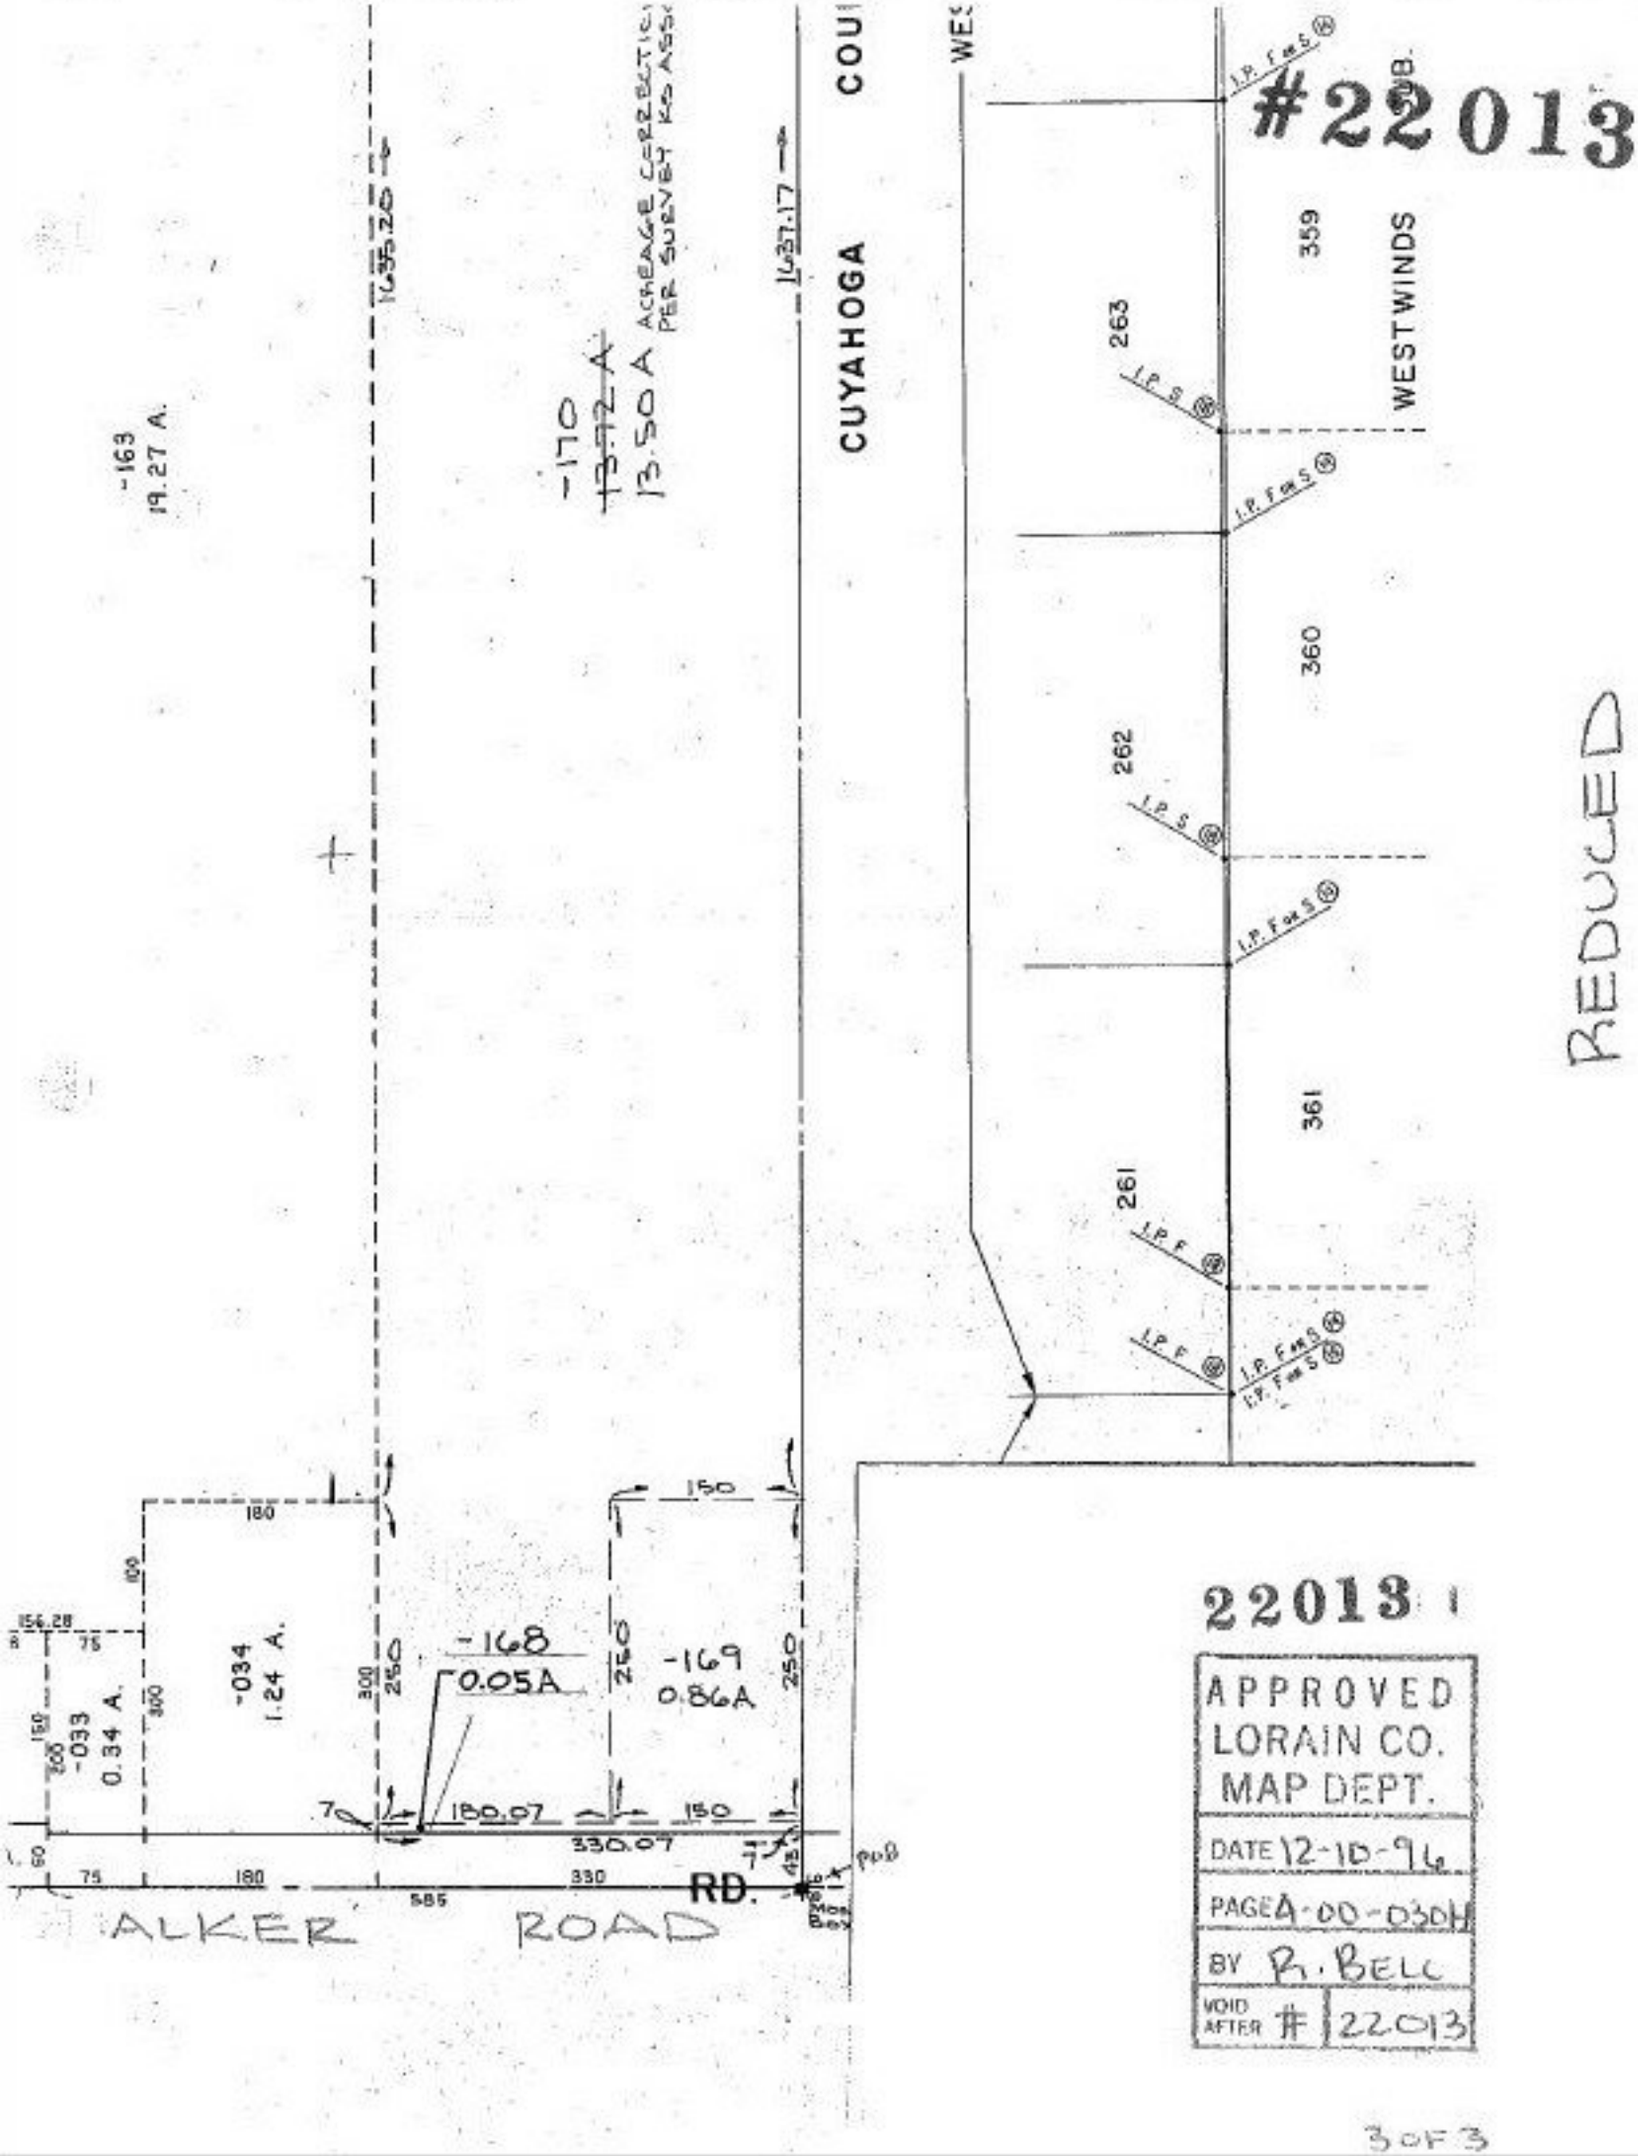
#22013
CUYAHOGA
COU
WES
WESTWINDS
359
360
361
263
262
261
I.P. F or S
I.P. S
I.P. F
-163
19.27 A.
-170
13.50 A
ACREAGE CORRECTION PER SURVEY KS ASSO
1635.20
1637.17
-168
0.05A
-169
0.86A
-034
1.24 A.
-033
0.34 A.
180.07
330.07
150
180
330
585
RD.
ALKER ROAD
REDUCED
22013
APPROVED
LORAIN CO.
MAP DEPT.
DATE 12-10-96
PAGE 4-00-030H
BY R. BELL
VOID AFTER # 22013
3 OF 3