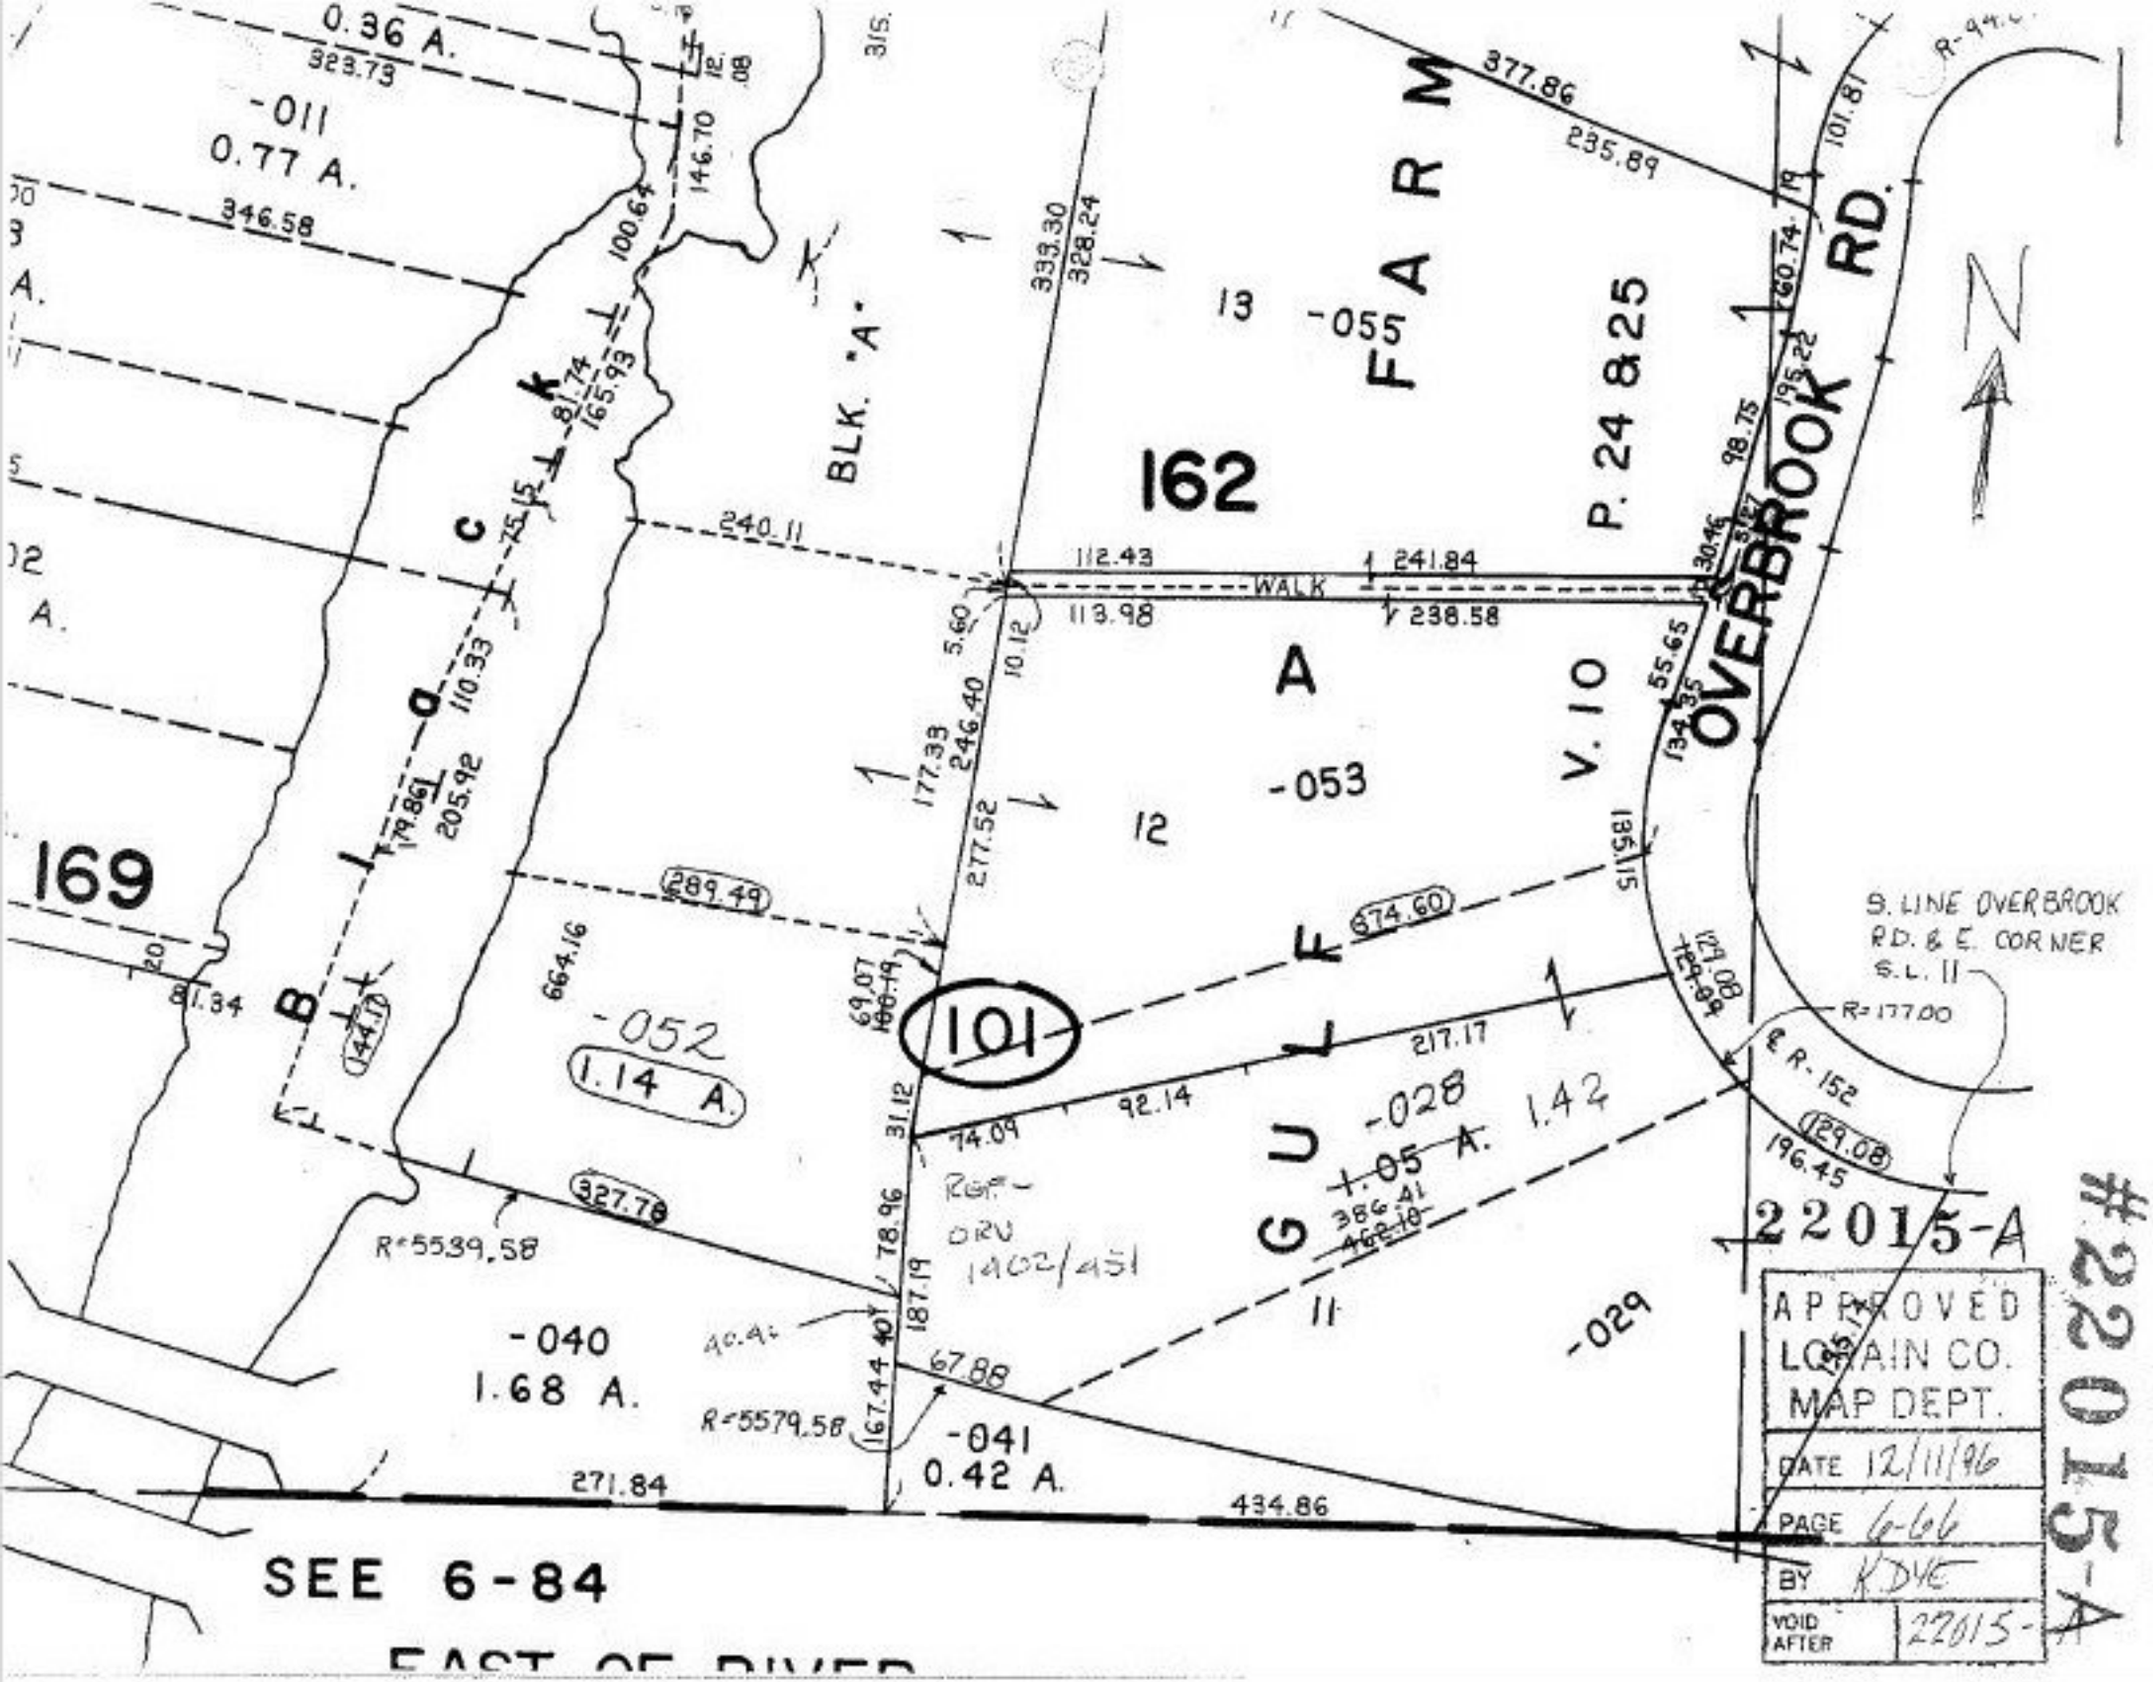

0.36 A.
323.73
-011
0.77 A.
346.58
146.70
100.64
81.74
165.93
75.15
110.33
205.92
79.86
144.17
81.34
169
BLK. "A"
333.30
328.24
13
-055
FARM
162
P. 24 & 25
377.86
235.89
101.81
60.74
195.22
98.75
30.46
OVERBROOK RD.
240.11
112.43
241.84
WALK
113.98
238.58
5.60
10.12
246.40
177.33
277.52
A
-053
12
V. 10
55.65
134.35
135.15
289.49
374.60
664.16
69.07
100.19
101
-052
1.14 A.
31.12
74.09
92.14
217.17
GULF
-028
1.05 A.
1.42
386.41
462.10
129.08
129.09
S. LINE OVERBROOK RD. & E. CORNER S.L. 11
R=177.00
℄ R-152
129.08
196.45
327.78
R=5539.58
78.96
187.19
167.44
40.41
67.88
R=5579.58
-040
1.68 A.
-041
0.42 A.
11
-029
271.84
434.86
SEE 6-84
EAST OF RIVER
22015-A
APPROVED
LORAIN CO.
MAP DEPT.
DATE 12/11/96
PAGE 6-66
BY KDVE
VOID AFTER 22015-A
#22015-A