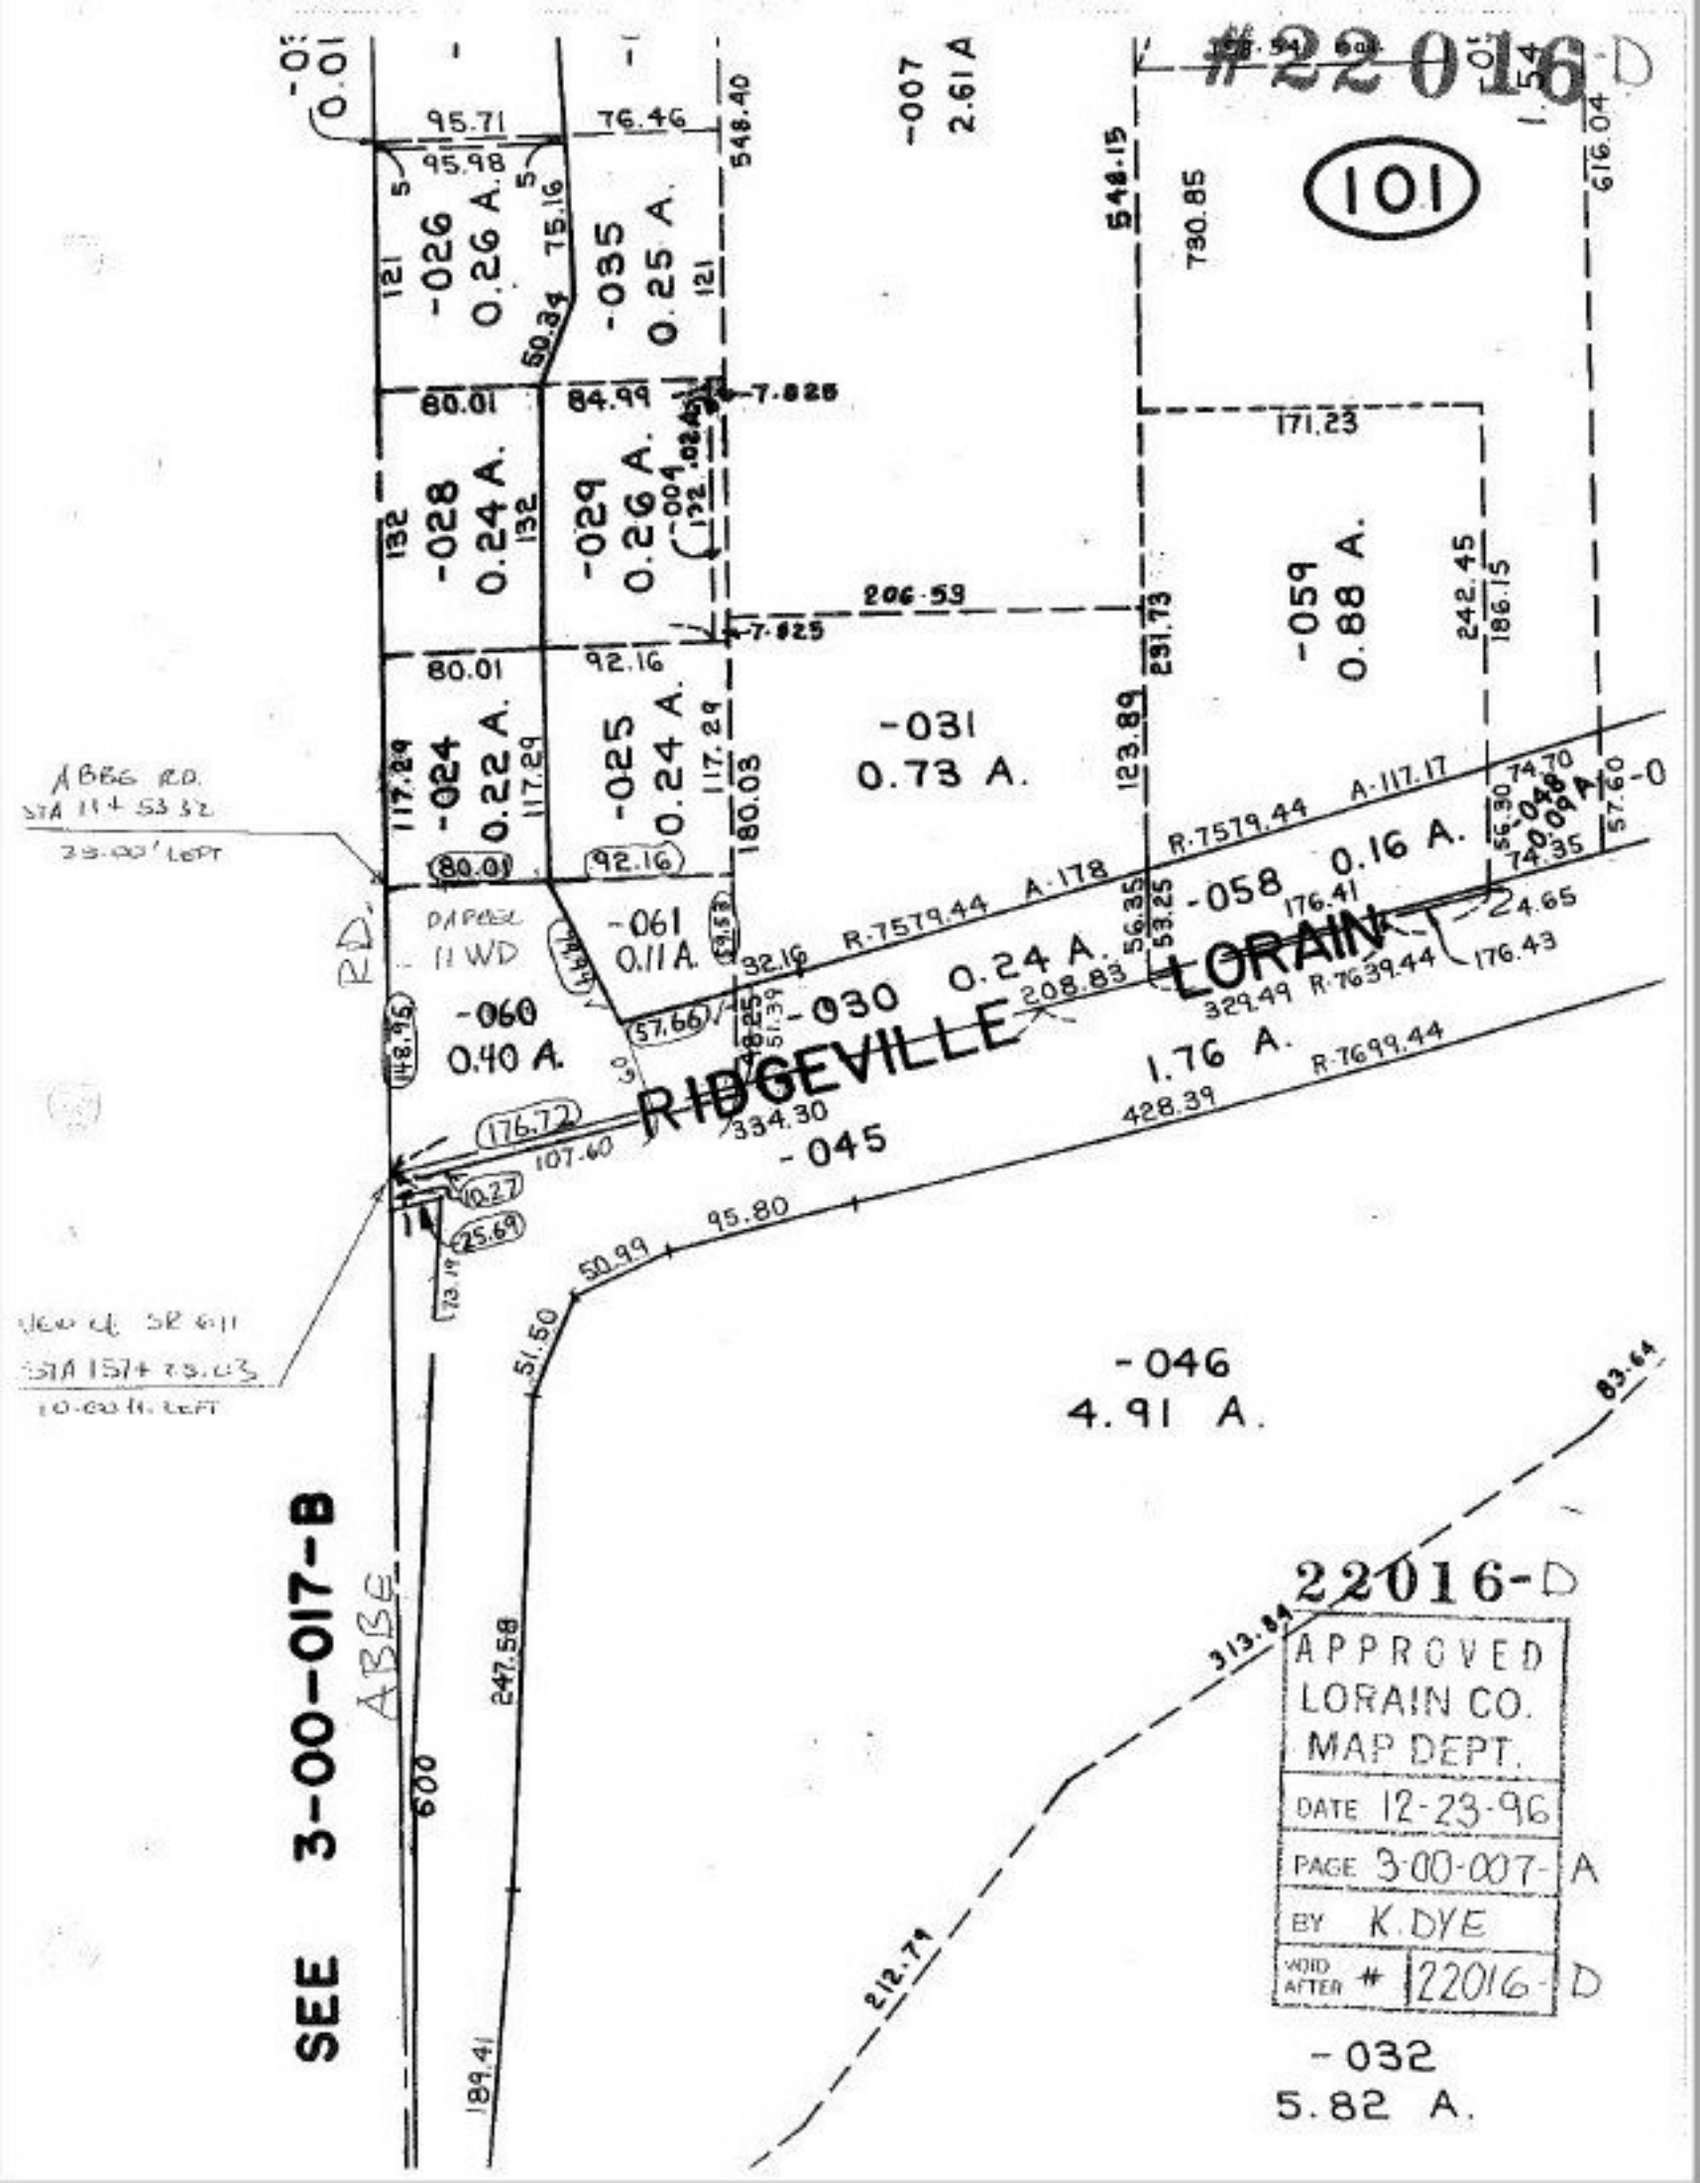
#22016-D
101
-007
2.61 A
-026
0.26 A.
-035
0.25 A.
-028
0.24 A.
-029
0.26 A.
-059
0.88 A.
-024
0.22 A.
-025
0.24 A.
-031
0.73 A.
-061
0.11 A.
-060
0.40 A.
-030
0.24 A.
-058
0.16 A.
-048
0.09 A.
-045
1.76 A.
-046
4.91 A.
-032
5.82 A.
RIDGEVILLE
LORAIN
ABBE RD.
STA 114+53.32
29.00' LEFT
RD.
PAPPEL
11 WD
ABBE
600
SEE 3-00-017-B
22016-D
APPROVED
LORAIN CO.
MAP DEPT.
DATE 12-23-96
PAGE 3-00-007- A
BY K.DYE
VOID AFTER # 22016- D