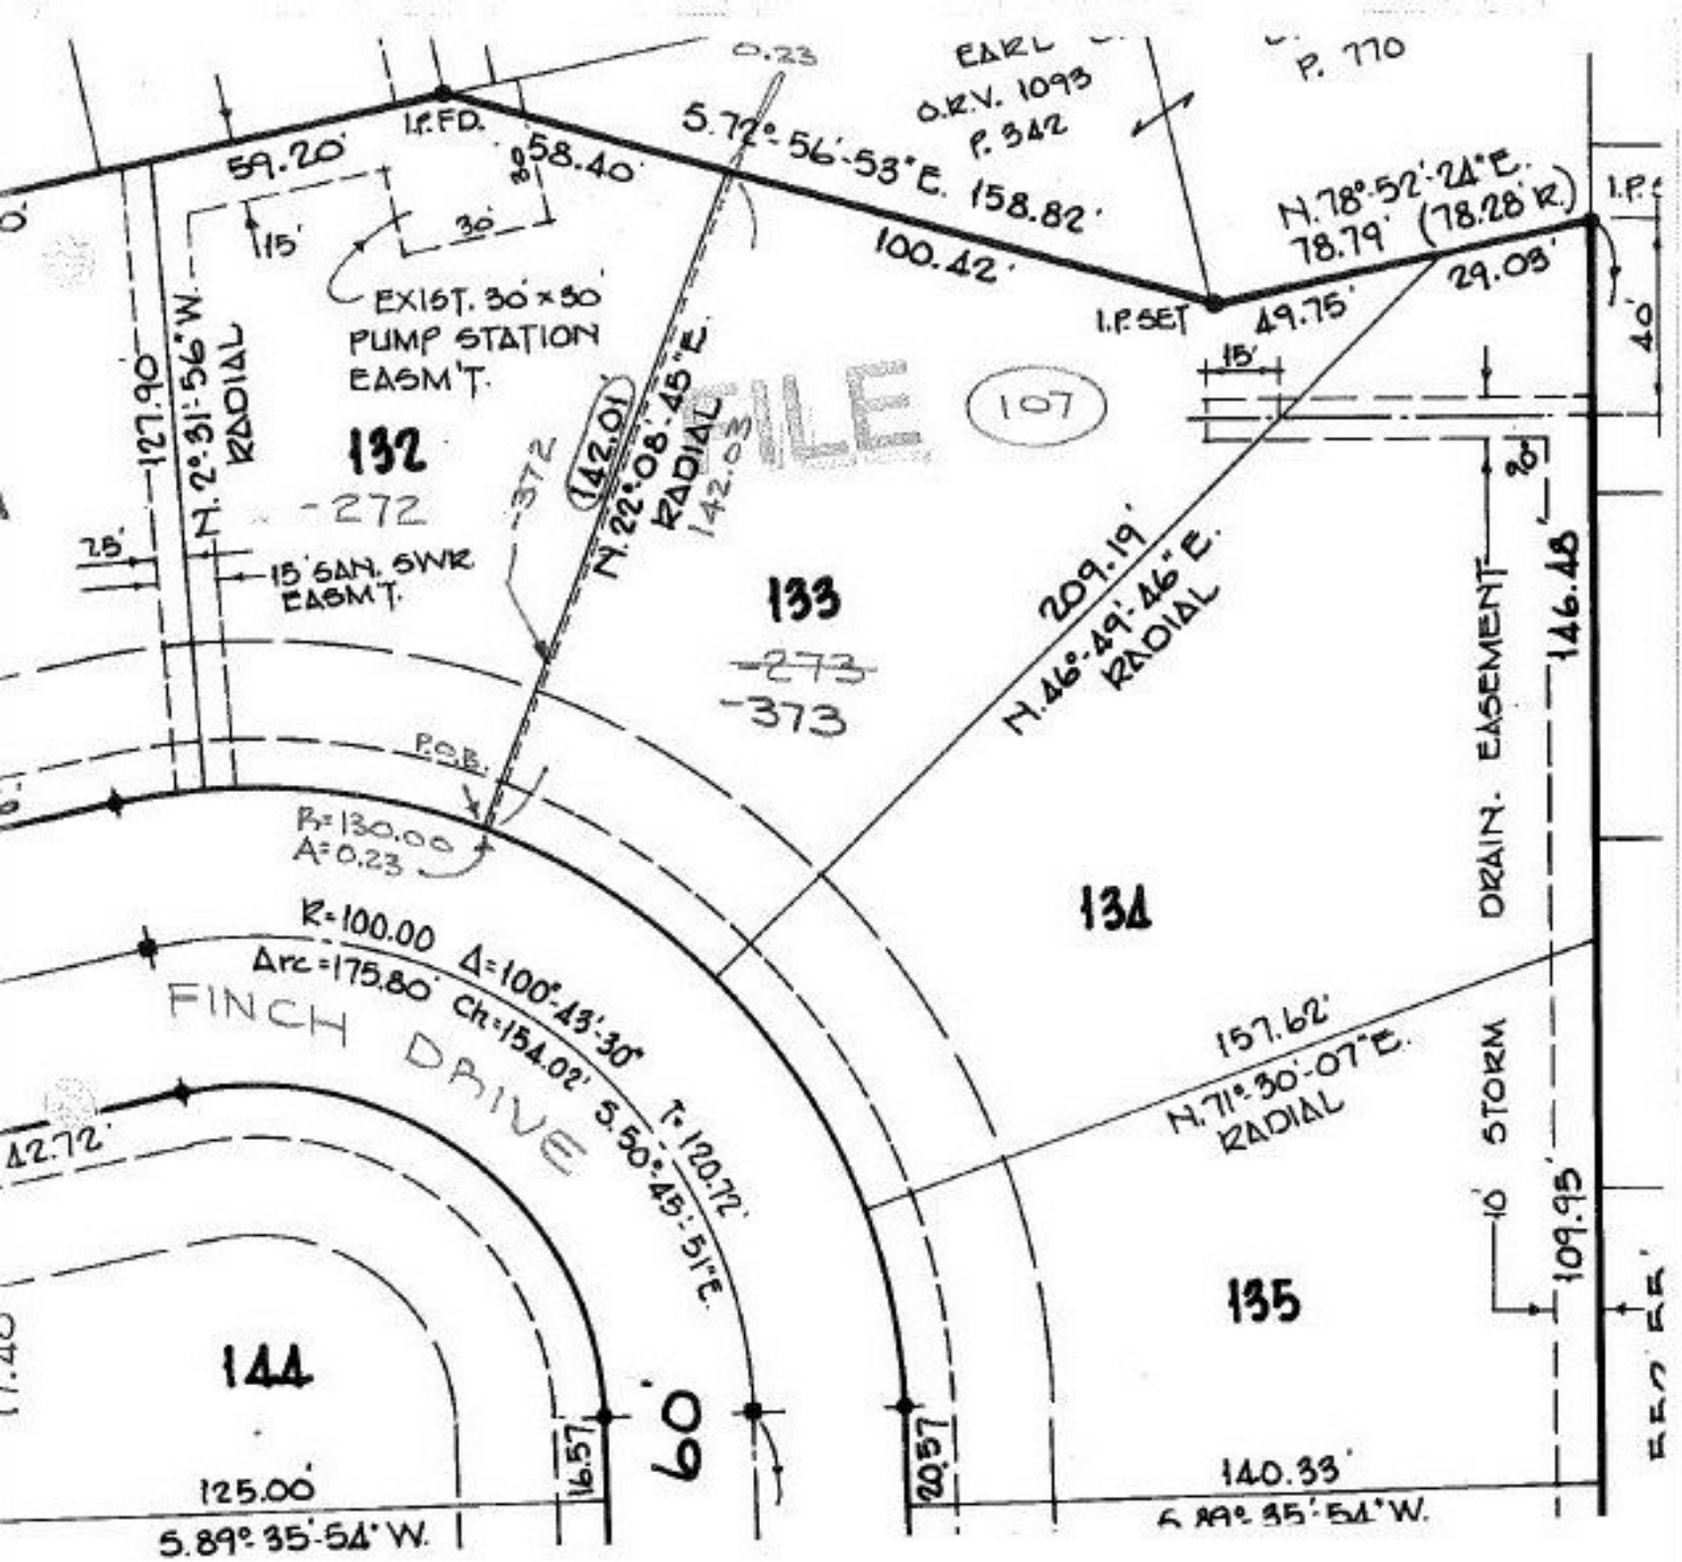

75.00'

75.00'

PRIOR INSTRUMENT PV 55, P. 63
CLOSURE 1.76 PER 10,000
SURVEYED BY Rodger G. Simon

22016

APPROVED
LORAIN CO.
MAP DEPT.
DATE 12-23-96
PAGE 10-60-DOSH
BY B. BELL
VOID AFTER # 22016