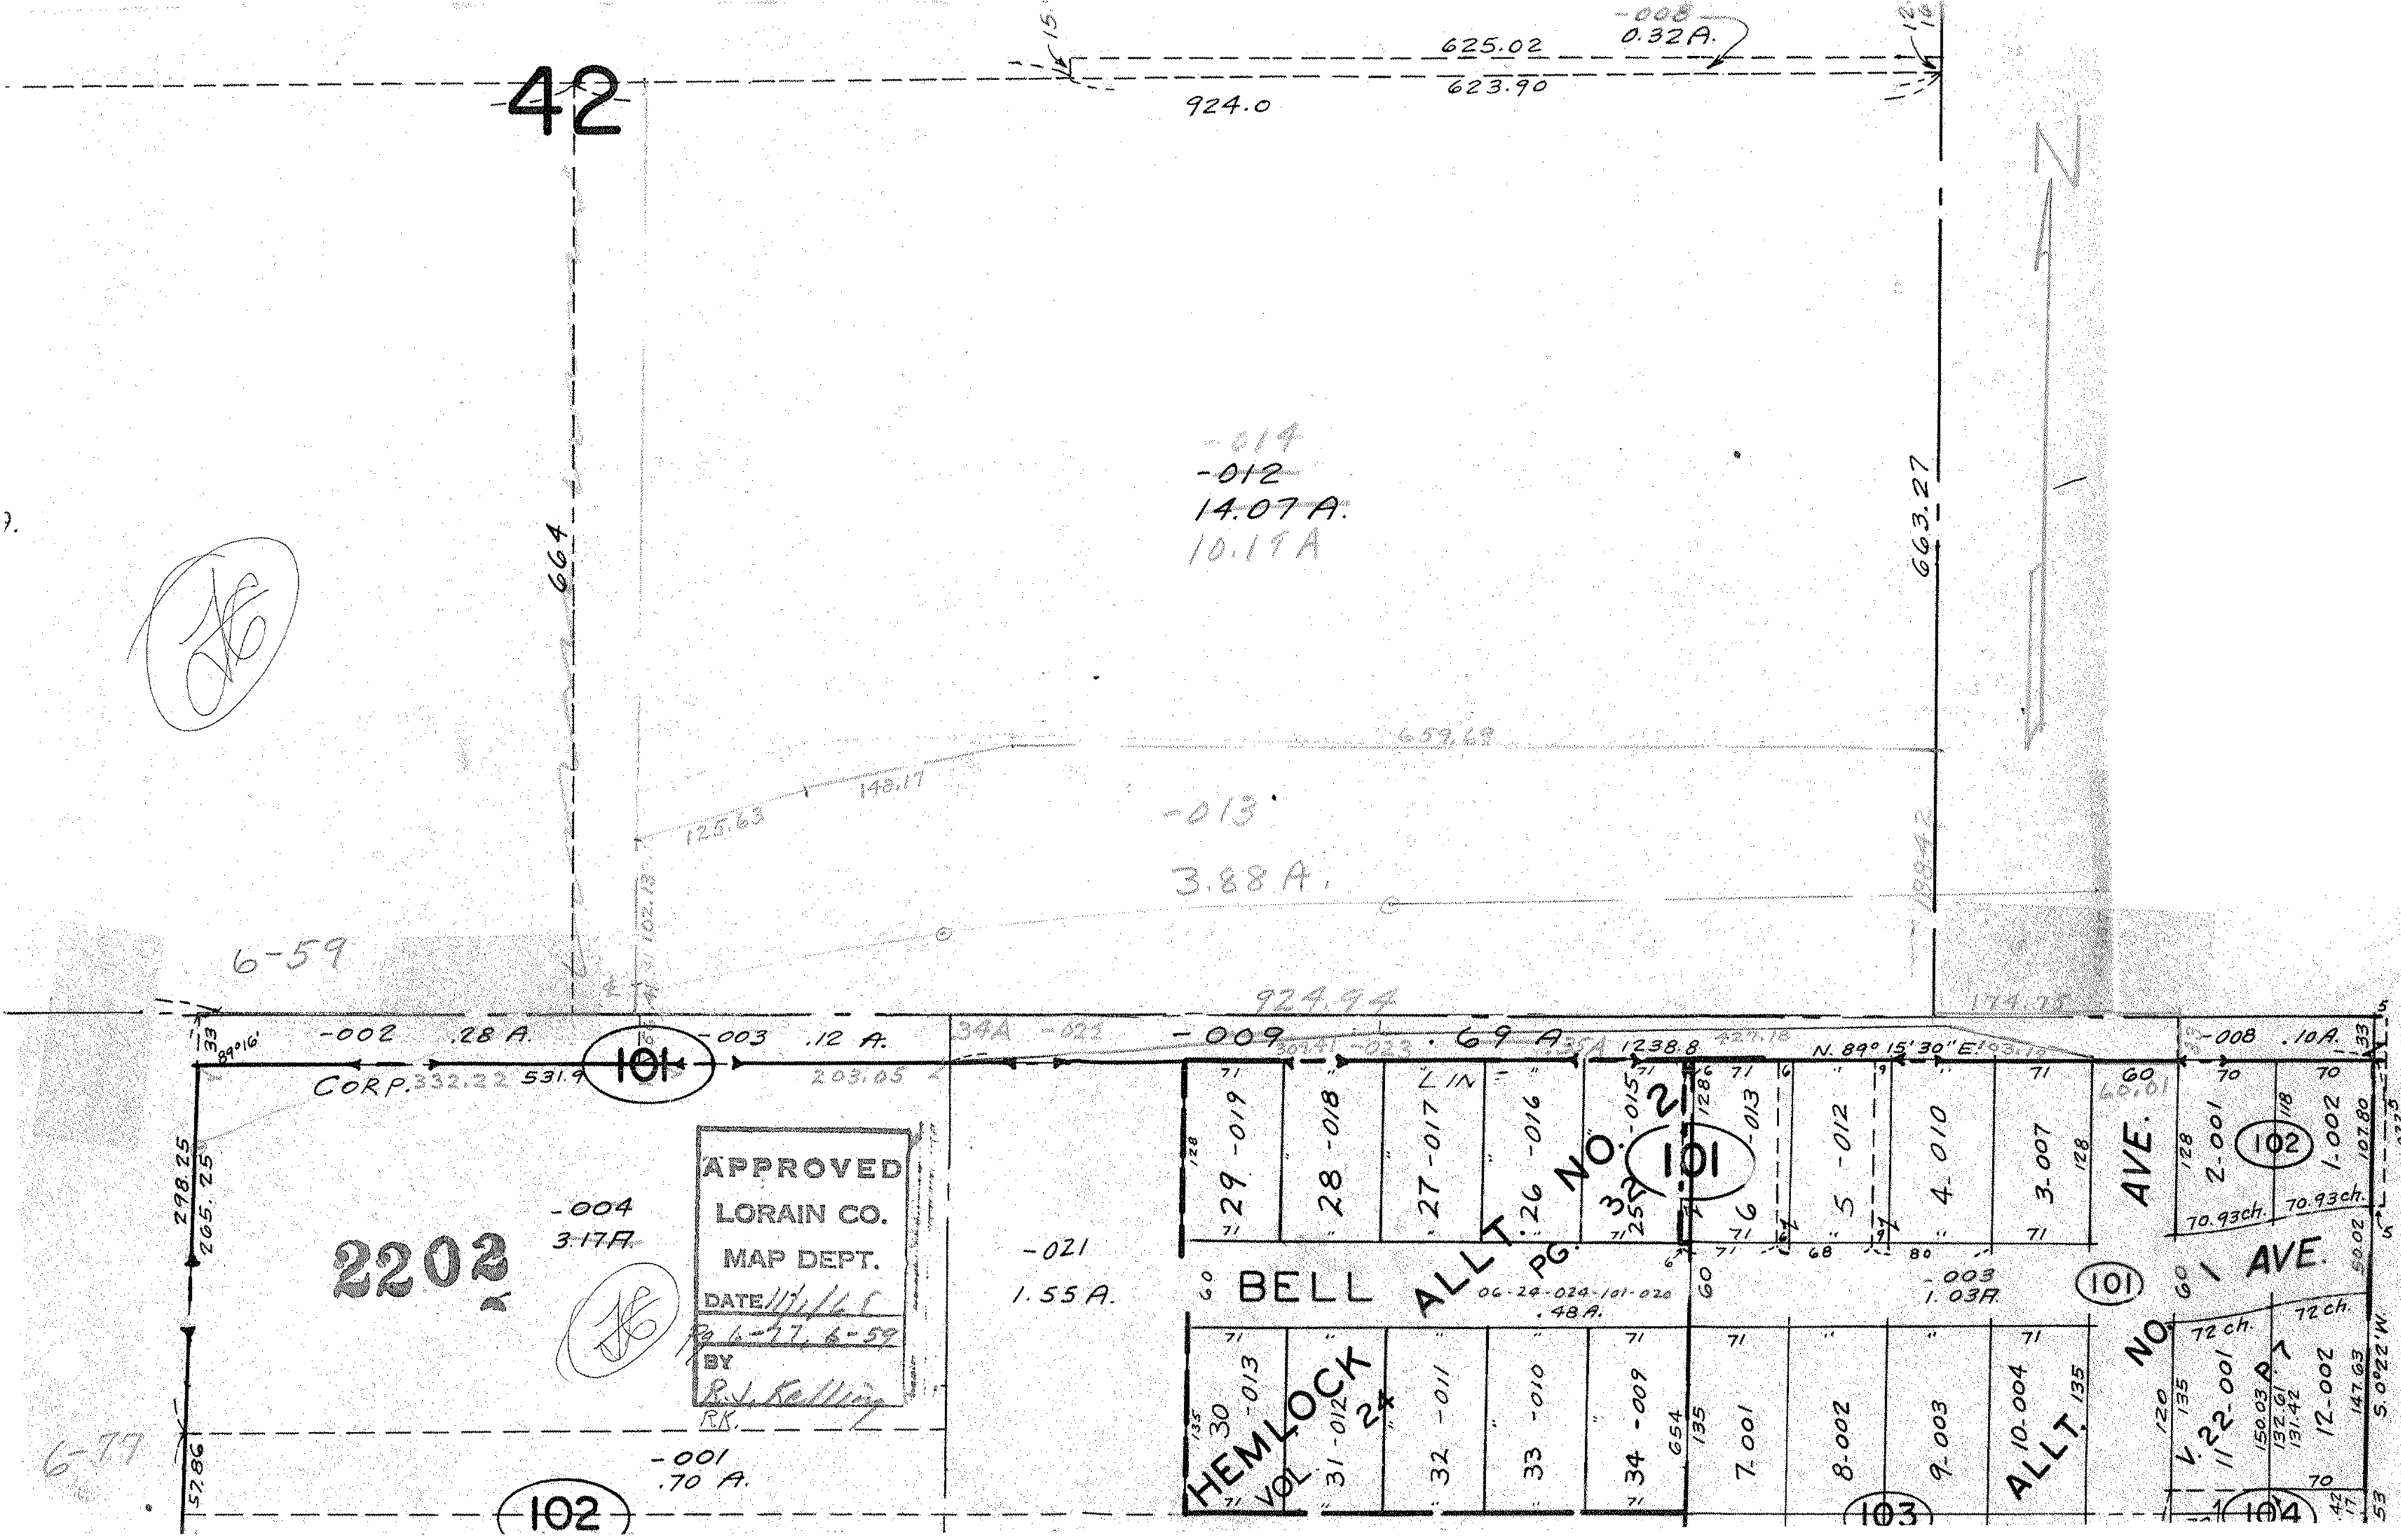
42
625.02
623.90
924.0
-008
0.32A.
-014
-012
14.07 A.
10.19A
664
663.27
659.69
148.17
125.63
-013
3.88 A.
6-59
924.94
-002
.28 A.
-003
.12 A.
-009
.69 A.
1238.8
N. 89° 15' 30" E.
-008
.10A.
CORP.
101
102
103
104
-004
3.17A
2202
-021
1.55 A.
-001
.70 A.
6-77
APPROVED
LORAIN CO.
MAP DEPT.
DATE
BY
R.J. Kelling
BELL
ALLT. NO. 21
PG. 32
HEMLOCK
VOL. 24
ALLT. NO. 1
AVE.
V. 22 P. 7
06-24-024-101-020
.48A.
-003
1.03A.
70.93ch.
72 ch.
S. 0°22' W.