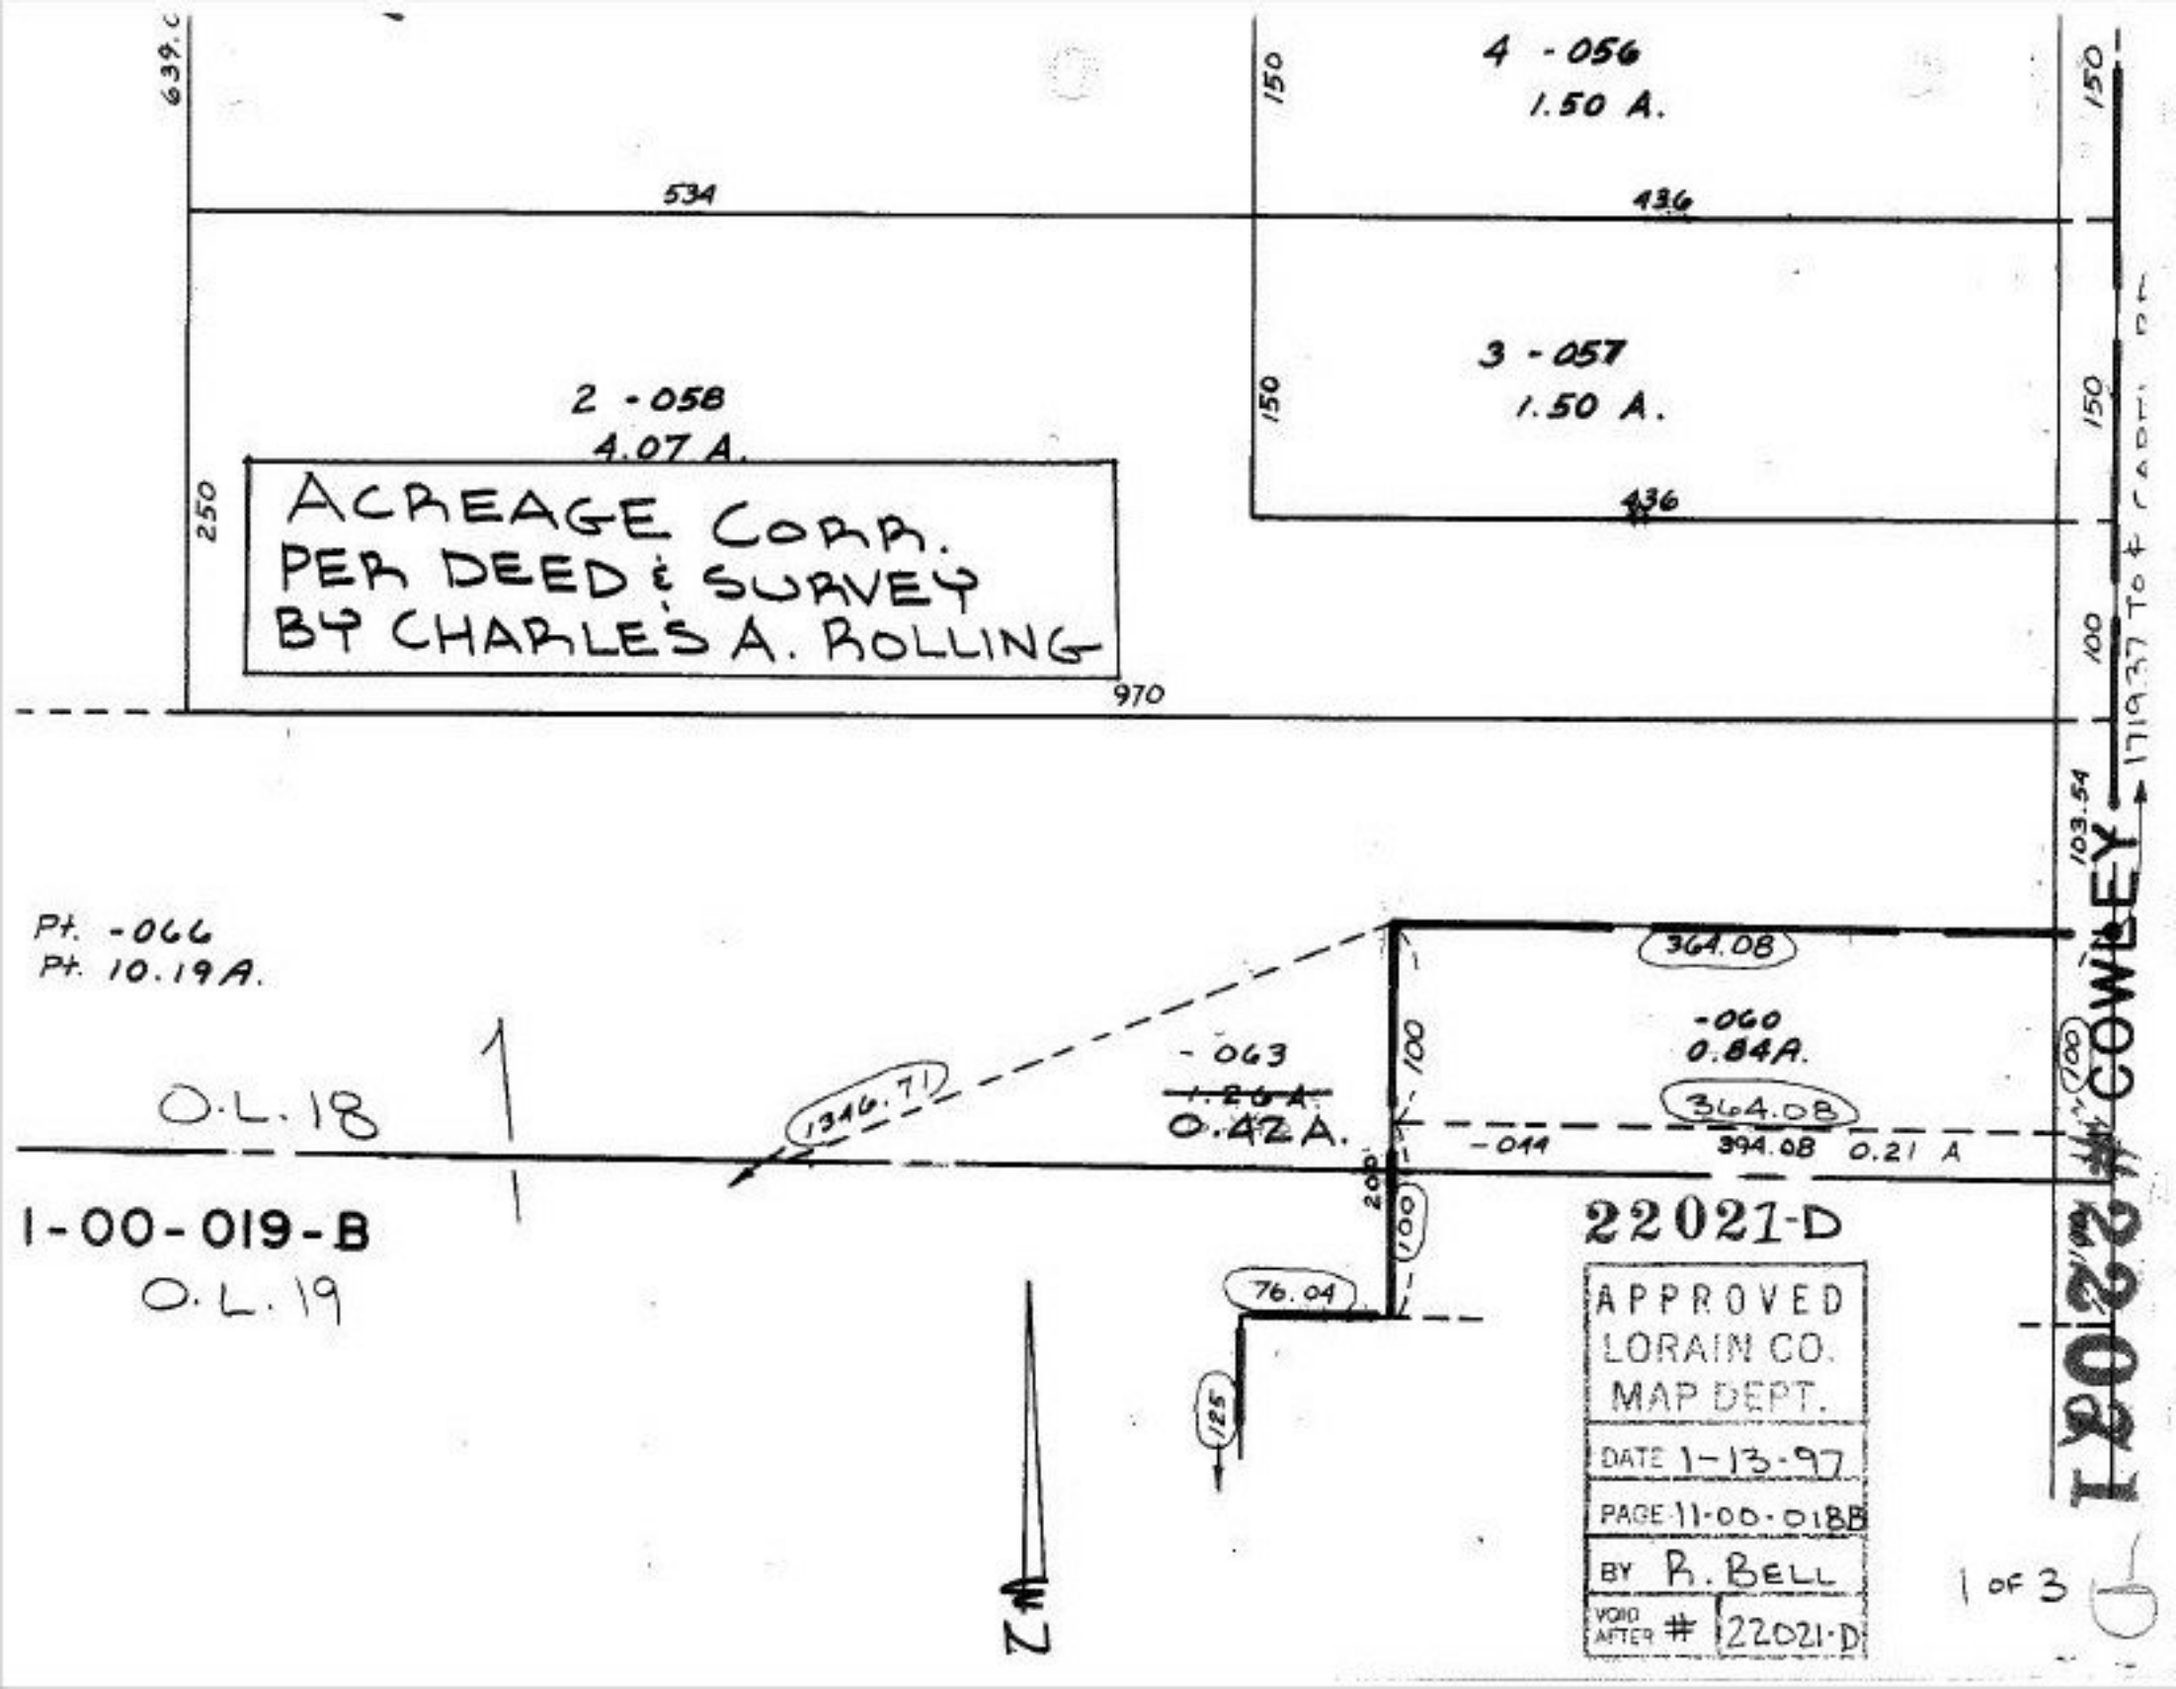

639.0
4 -056
1.50 A.
150
534
436
3 -057
1.50 A.
2 -058
4.07 A.
250
ACREAGE CORR.
PER DEED & SURVEY
BY CHARLES A. ROLLING
970
100
103.54
1719.37 TO ℄ CAPEL RD
COWLEY
Pt. -066
Pt. 10.19A.
364.08
-060
0.84A.
-063
~~1.26A.~~
0.42A.
1346.71
O.L. 18
-044
394.08
0.21 A
200
100
1-00-019-B
O.L. 19
76.04
125
N
22021-D
APPROVED
LORAIN CO.
MAP DEPT.
DATE 1-13-97
PAGE 11-00-018B
BY R. BELL
VOID AFTER # 22021-D
1 OF 3