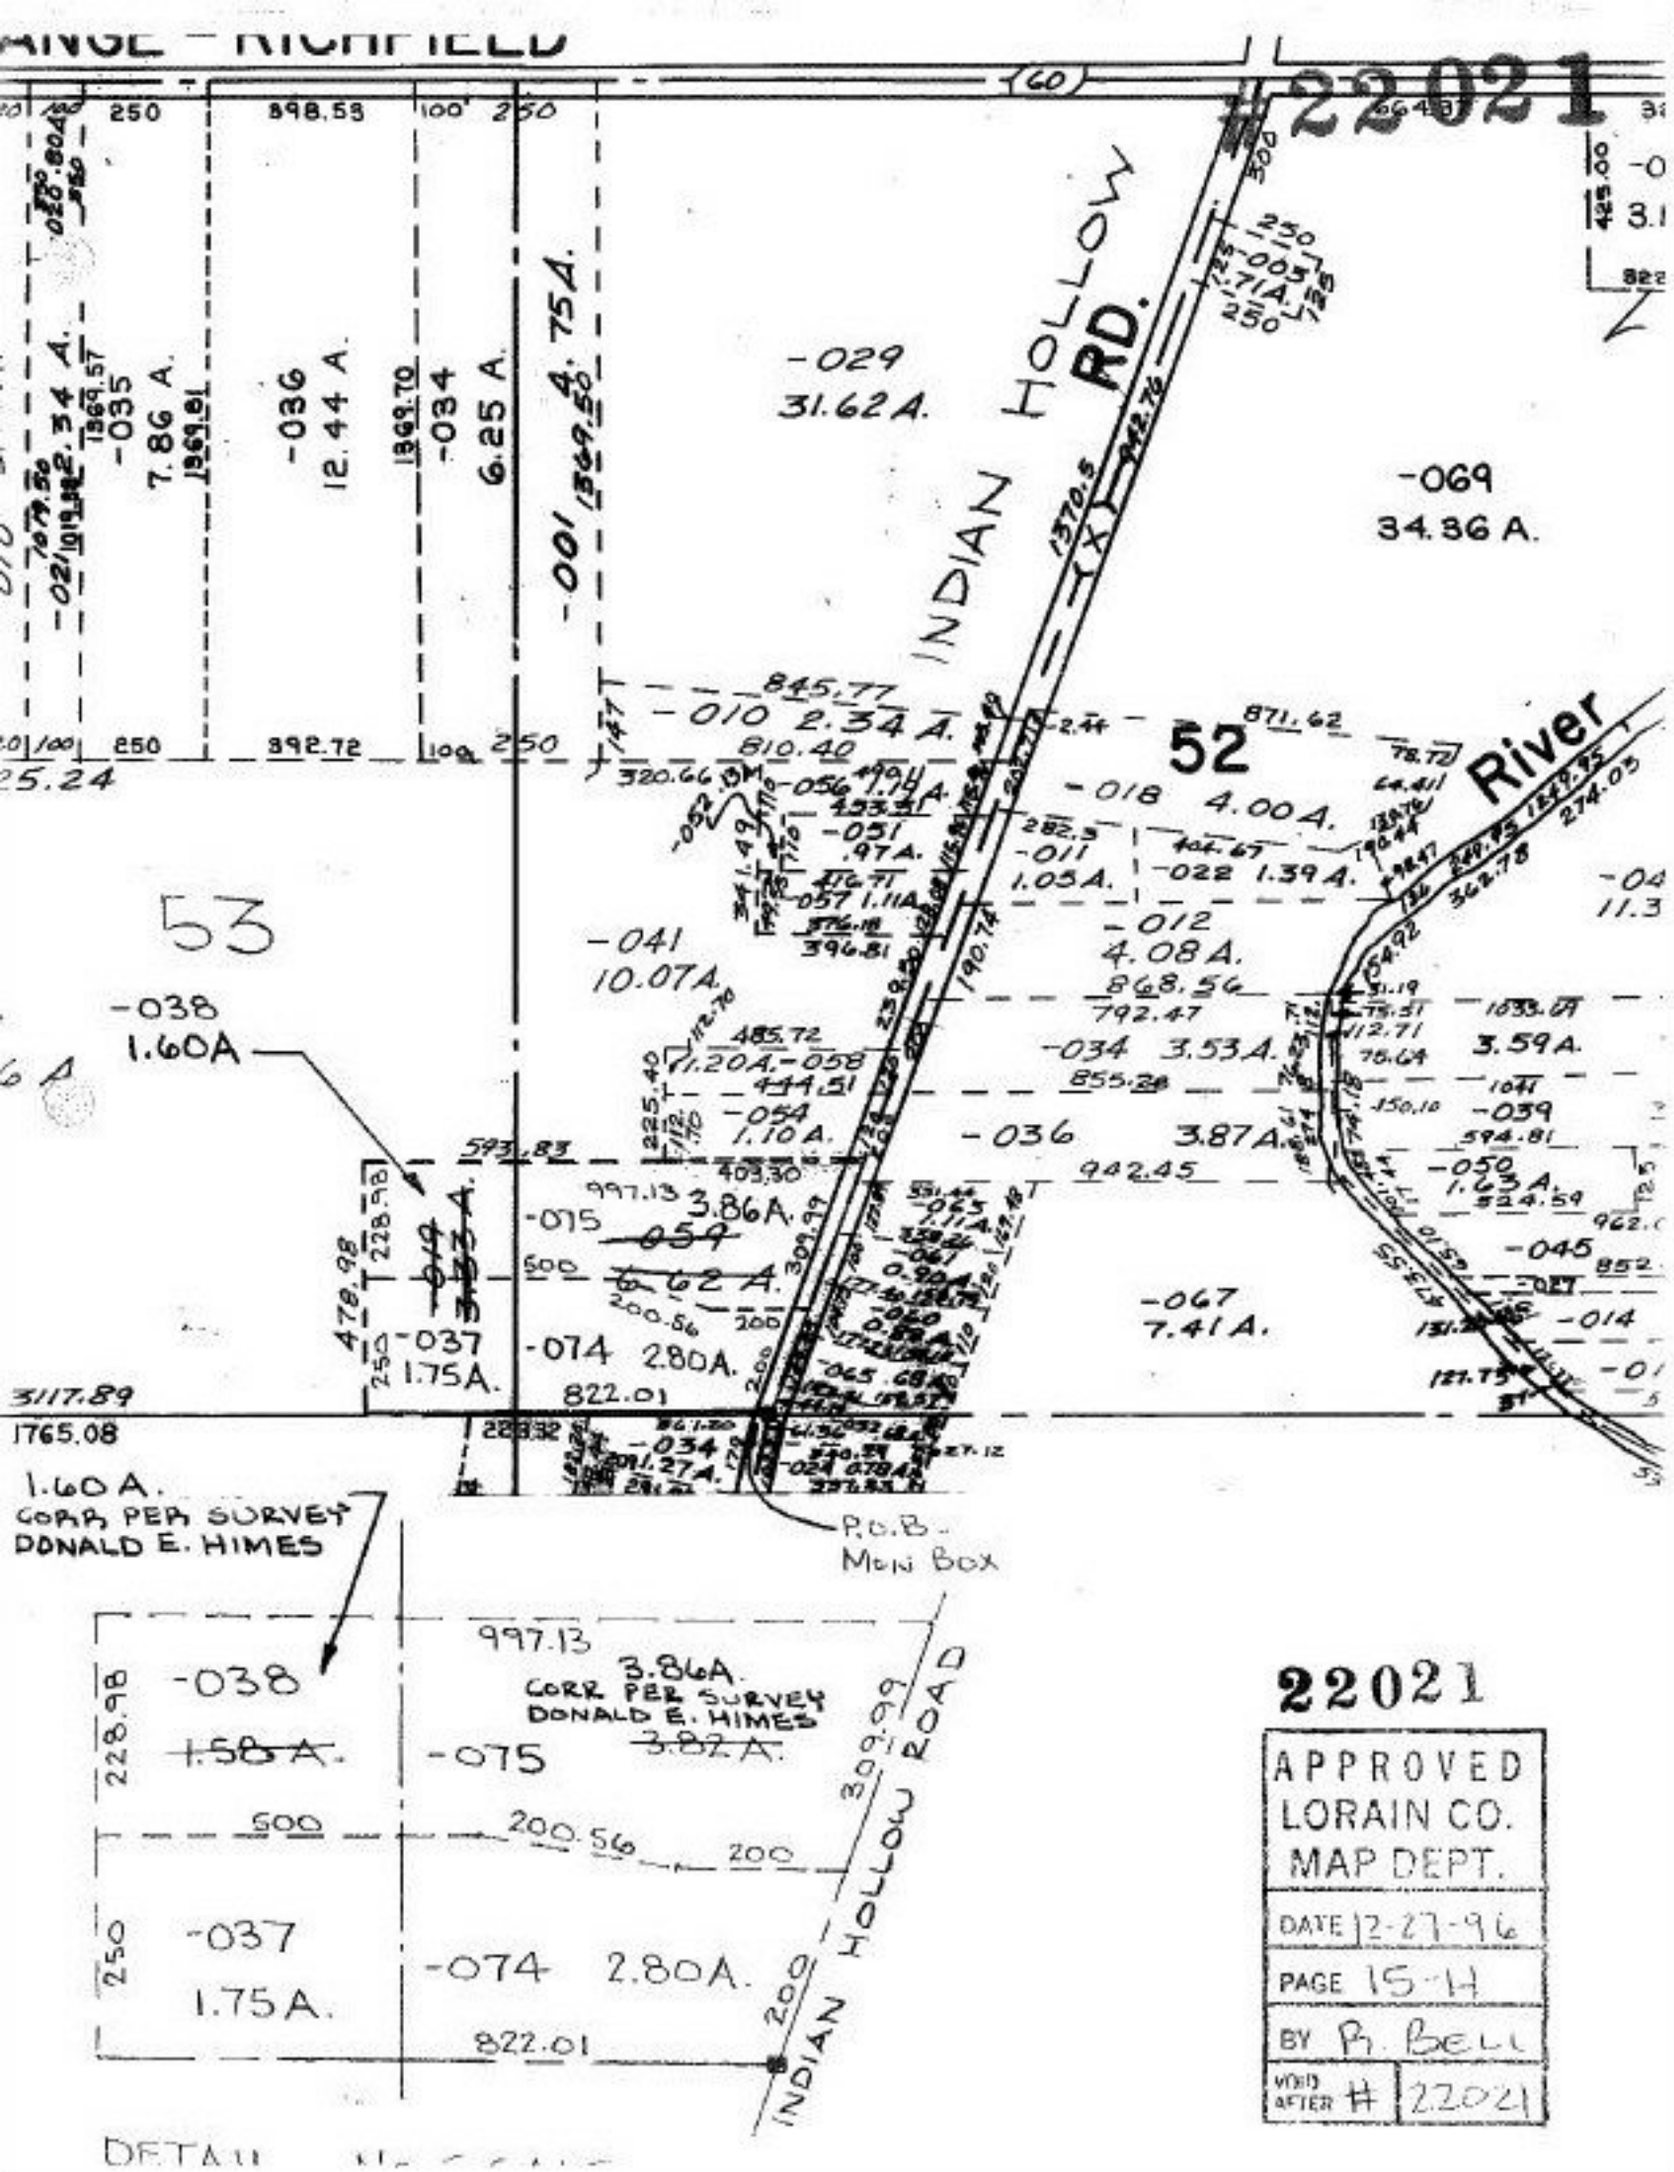
#22021
INDIAN HOLLOW RD.
River
52
53
-029
31.62A.
-069
34.86 A.
-010 2.34 A.
-018 4.00A.
-011
1.05A.
-022 1.39A.
-012
4.08A.
-041
10.07A.
-038
1.60A
-034 3.53A.
3.59A.
-036 3.87A.
-039
-050
1.63A.
-045
-067
7.41A.
-074 2.80A.
-037
1.75A.
-075
3.86A.
-054
1.10A.
-057 1.11A.
-056 1.14A.
-051
.97A.
-035
7.86 A.
-036
12.44 A.
-034
6.25 A.
-001 4.754.
-021 2.34 A.
1.60 A.
CORR PER SURVEY
DONALD E. HIMES
P.O.B.-
Main Box
997.13
3.86A.
CORR PER SURVEY
DONALD E. HIMES
INDIAN HOLLOW ROAD
22021
APPROVED
LORAIN CO.
MAP DEPT.
DATE 12-27-96
PAGE 15-H
BY R. BELL
VOID AFTER # 22021