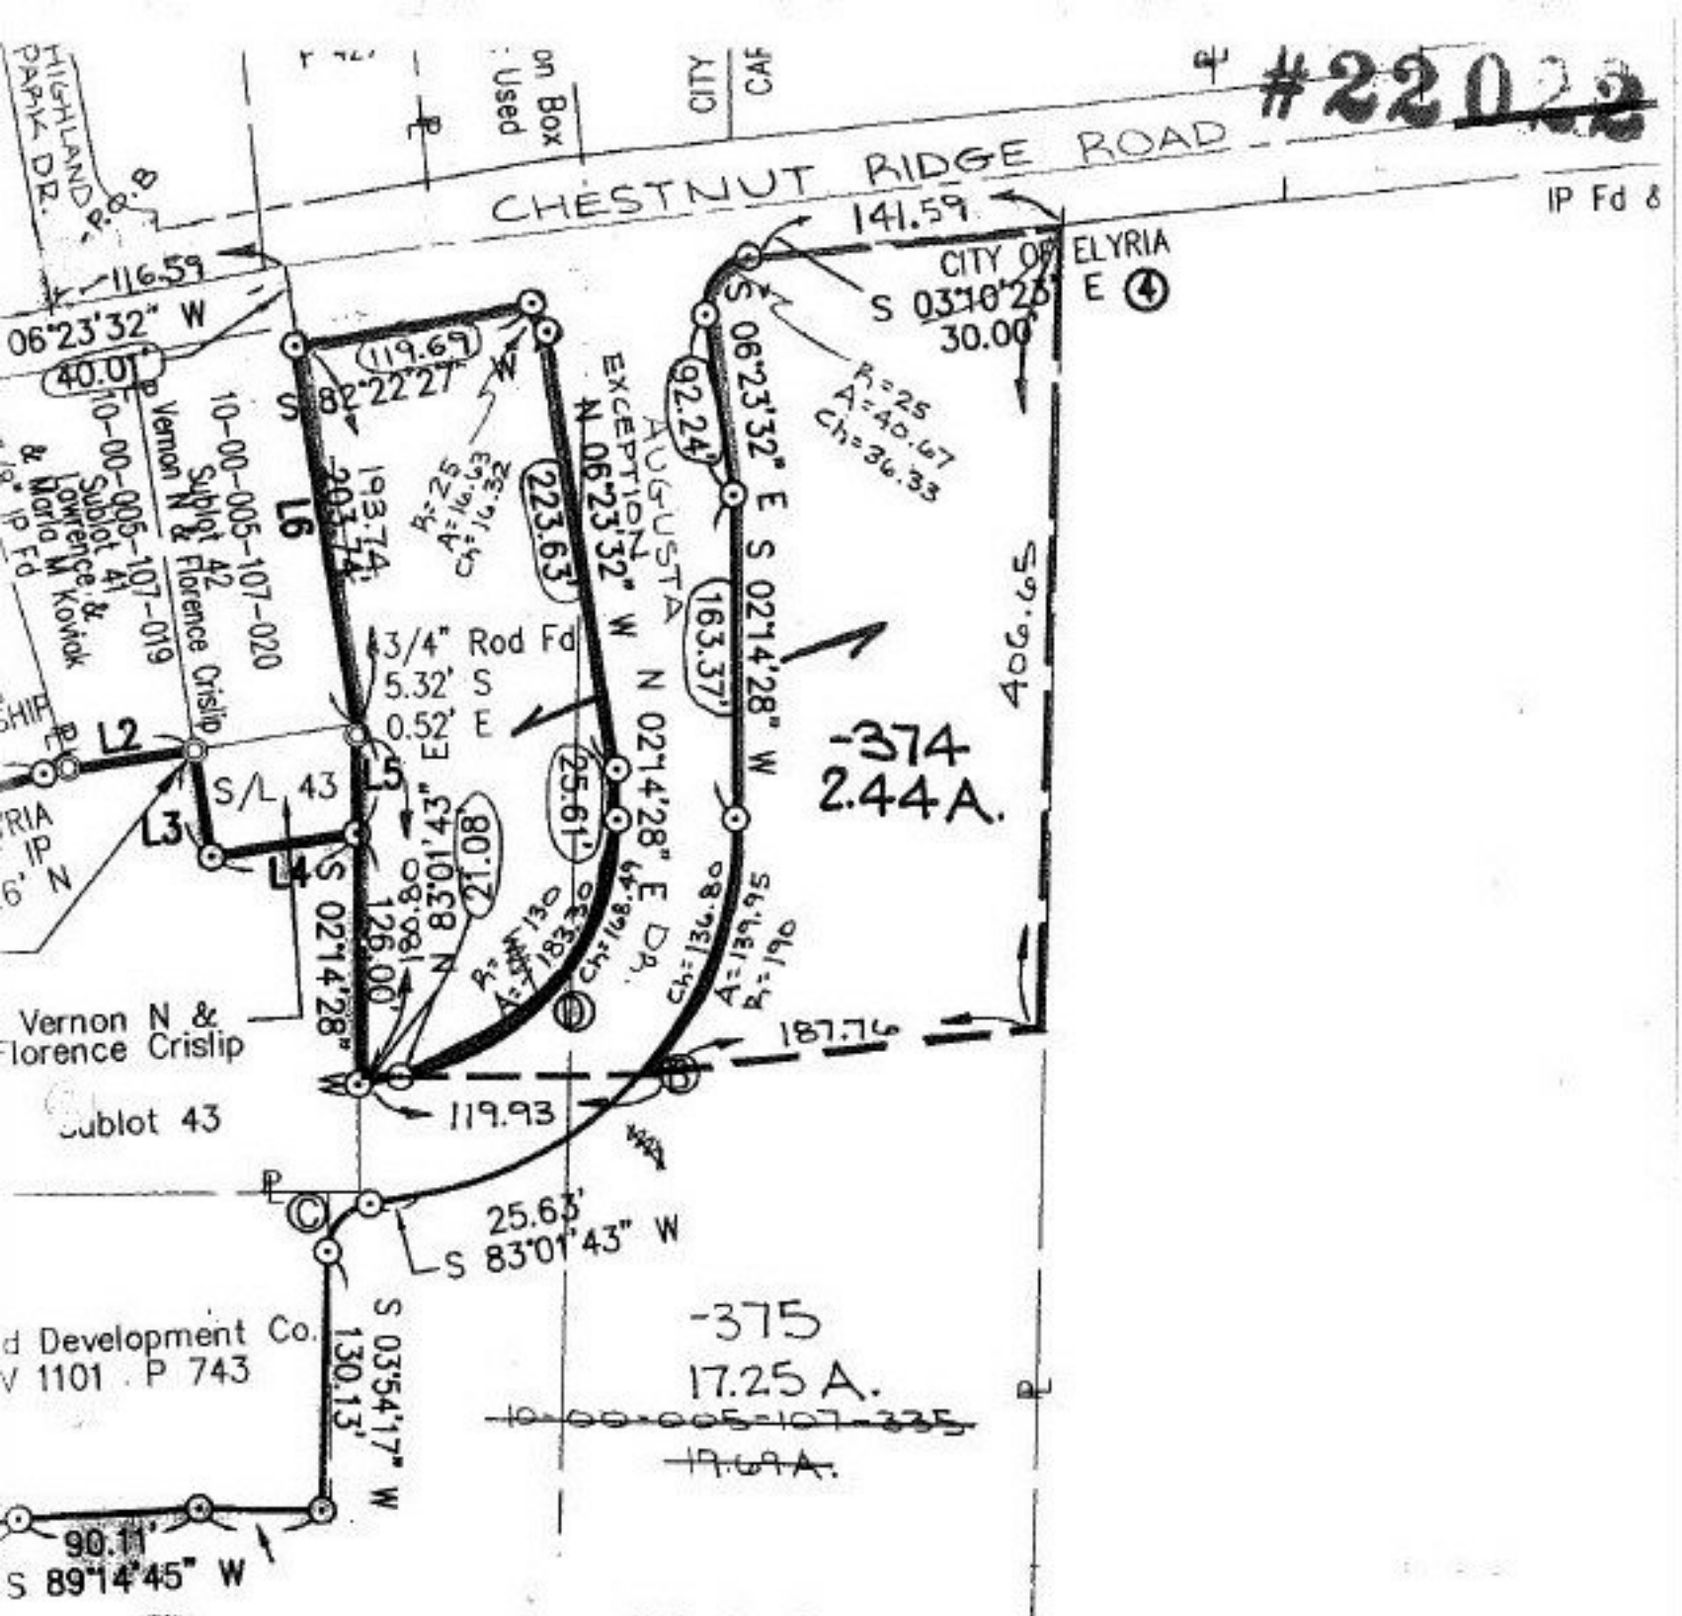

22022

APPROVED LORAIN CO. MAP DEPT.	
DATE 12-27-96	
PAGE 10-00-005E 10-00-005F	
BY R. BELL	
VOID AFTER #	22022