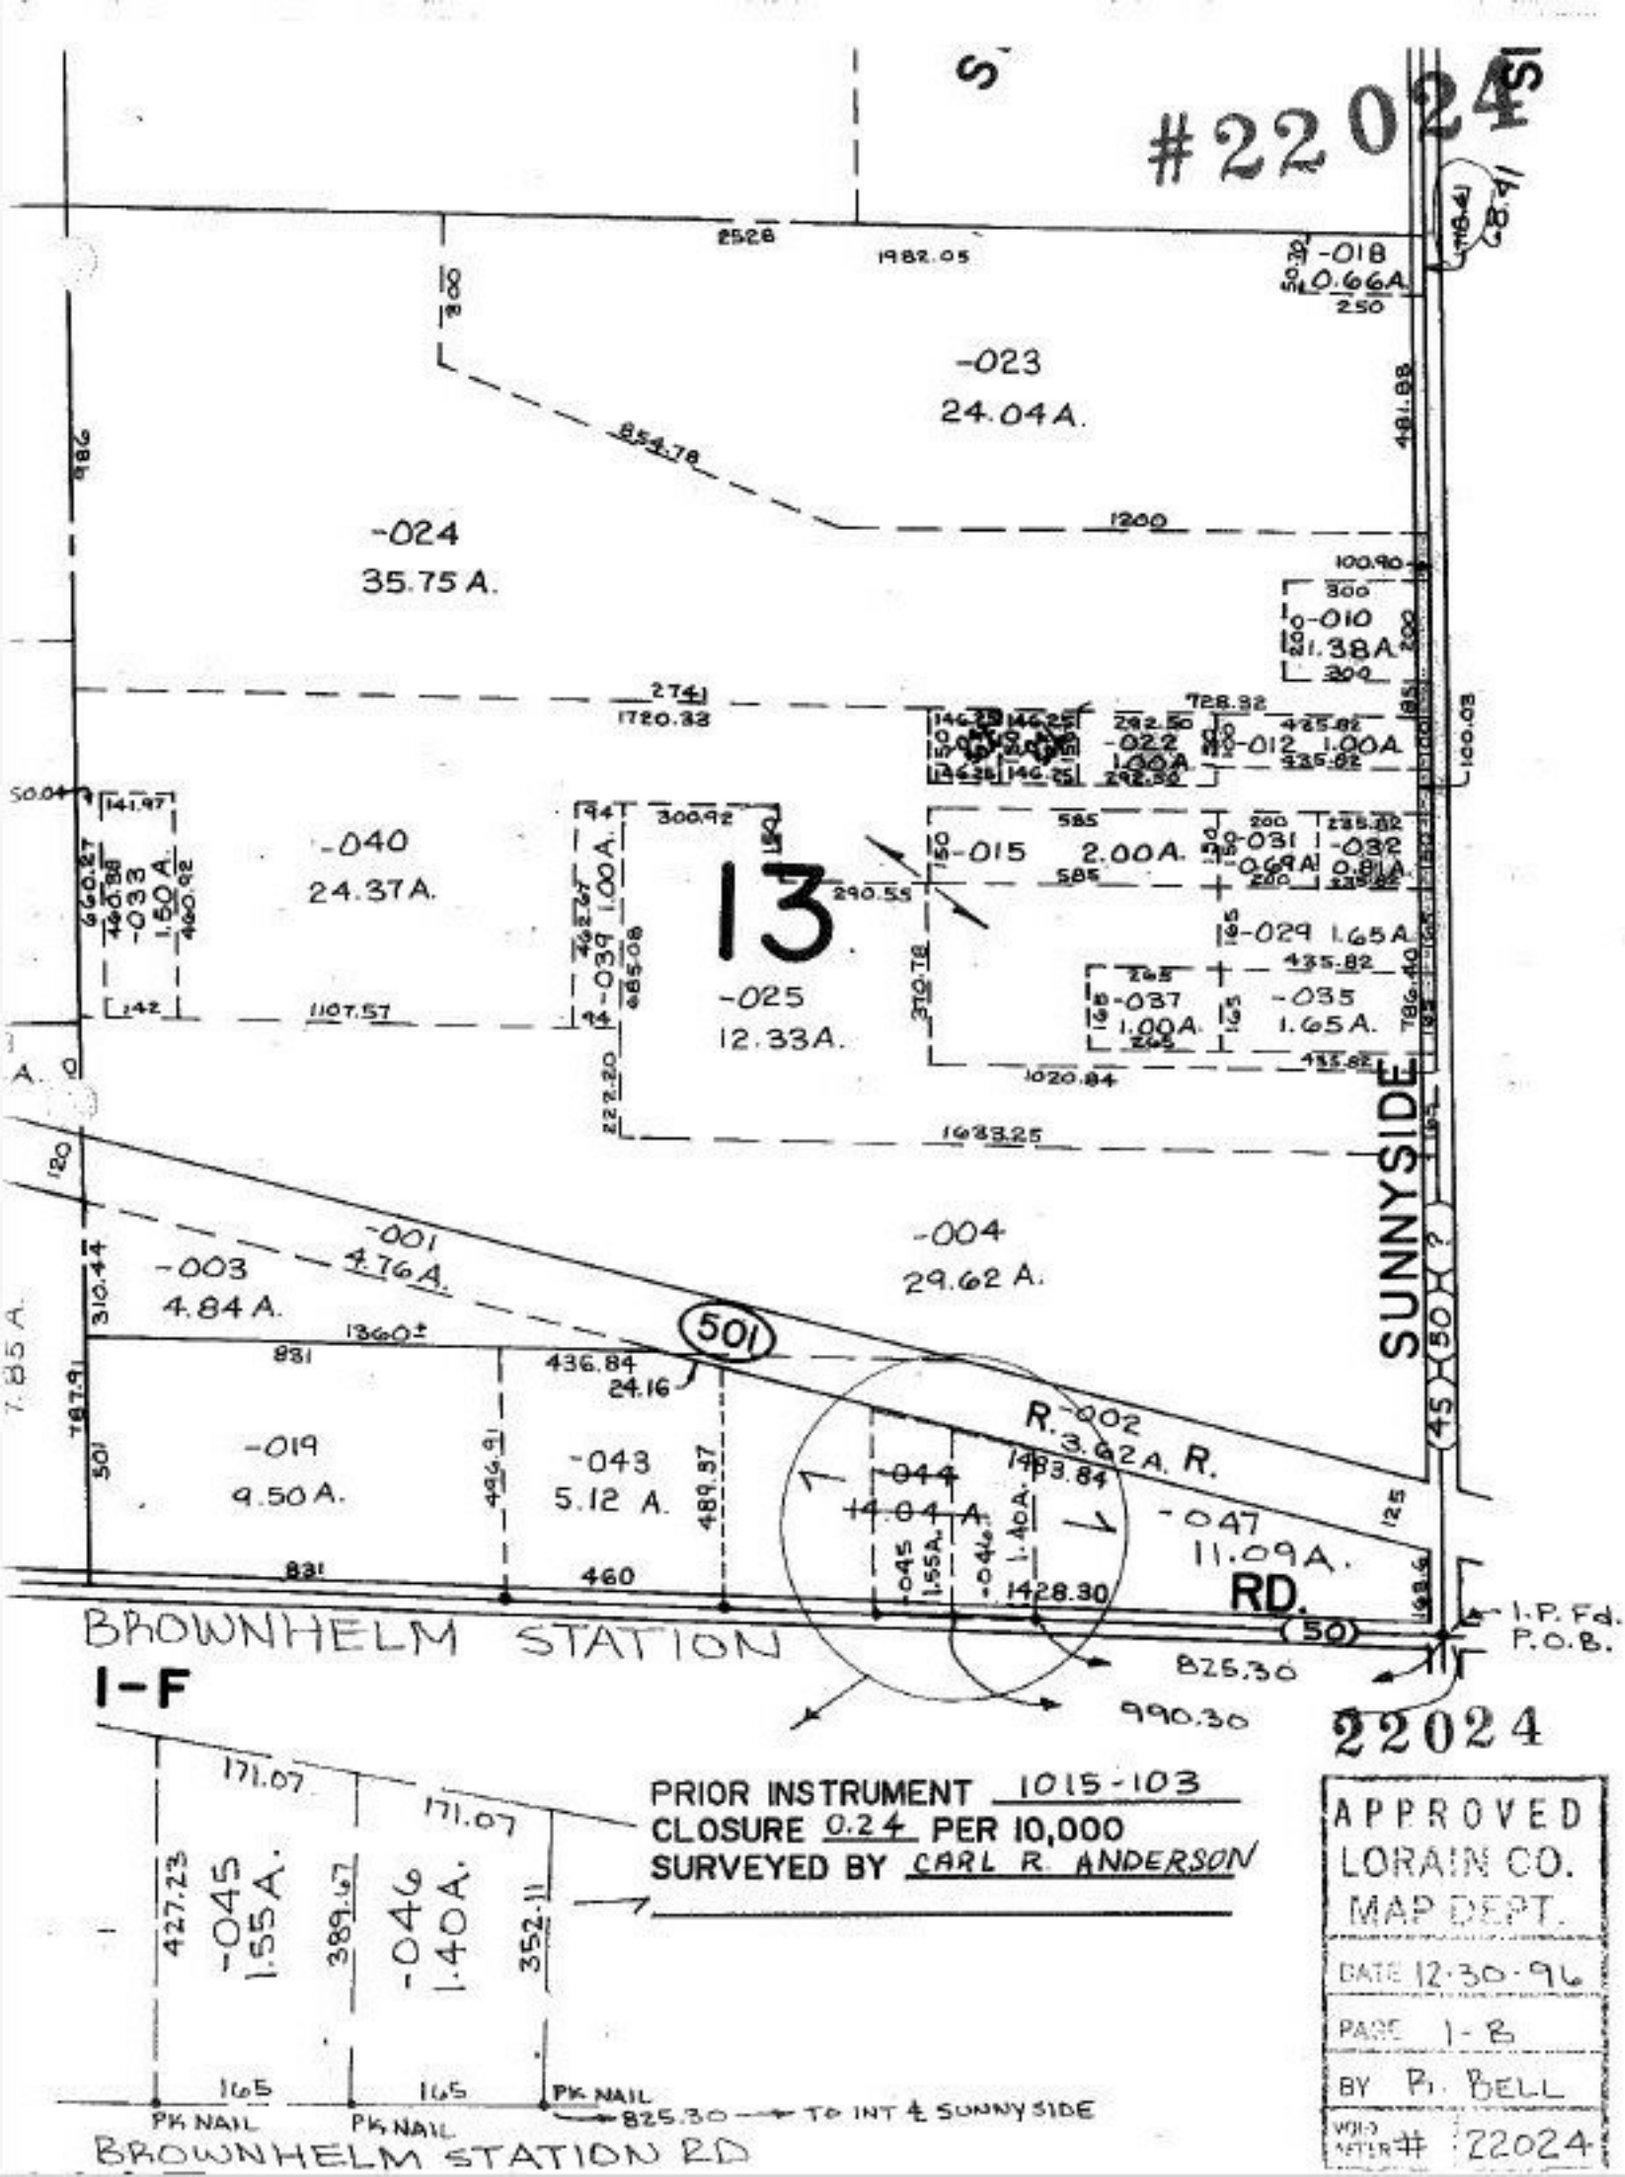

PRIOR INSTRUMENT 1015-103
CLOSURE 0.24 PER 10,000
SURVEYED BY CARL R. ANDERSON

APPROVED
LORAIN CO.
MAP DEPT.
DATE 12-30-96
PAGE 1-B
BY P. BELL
VOID AFTER # 22024