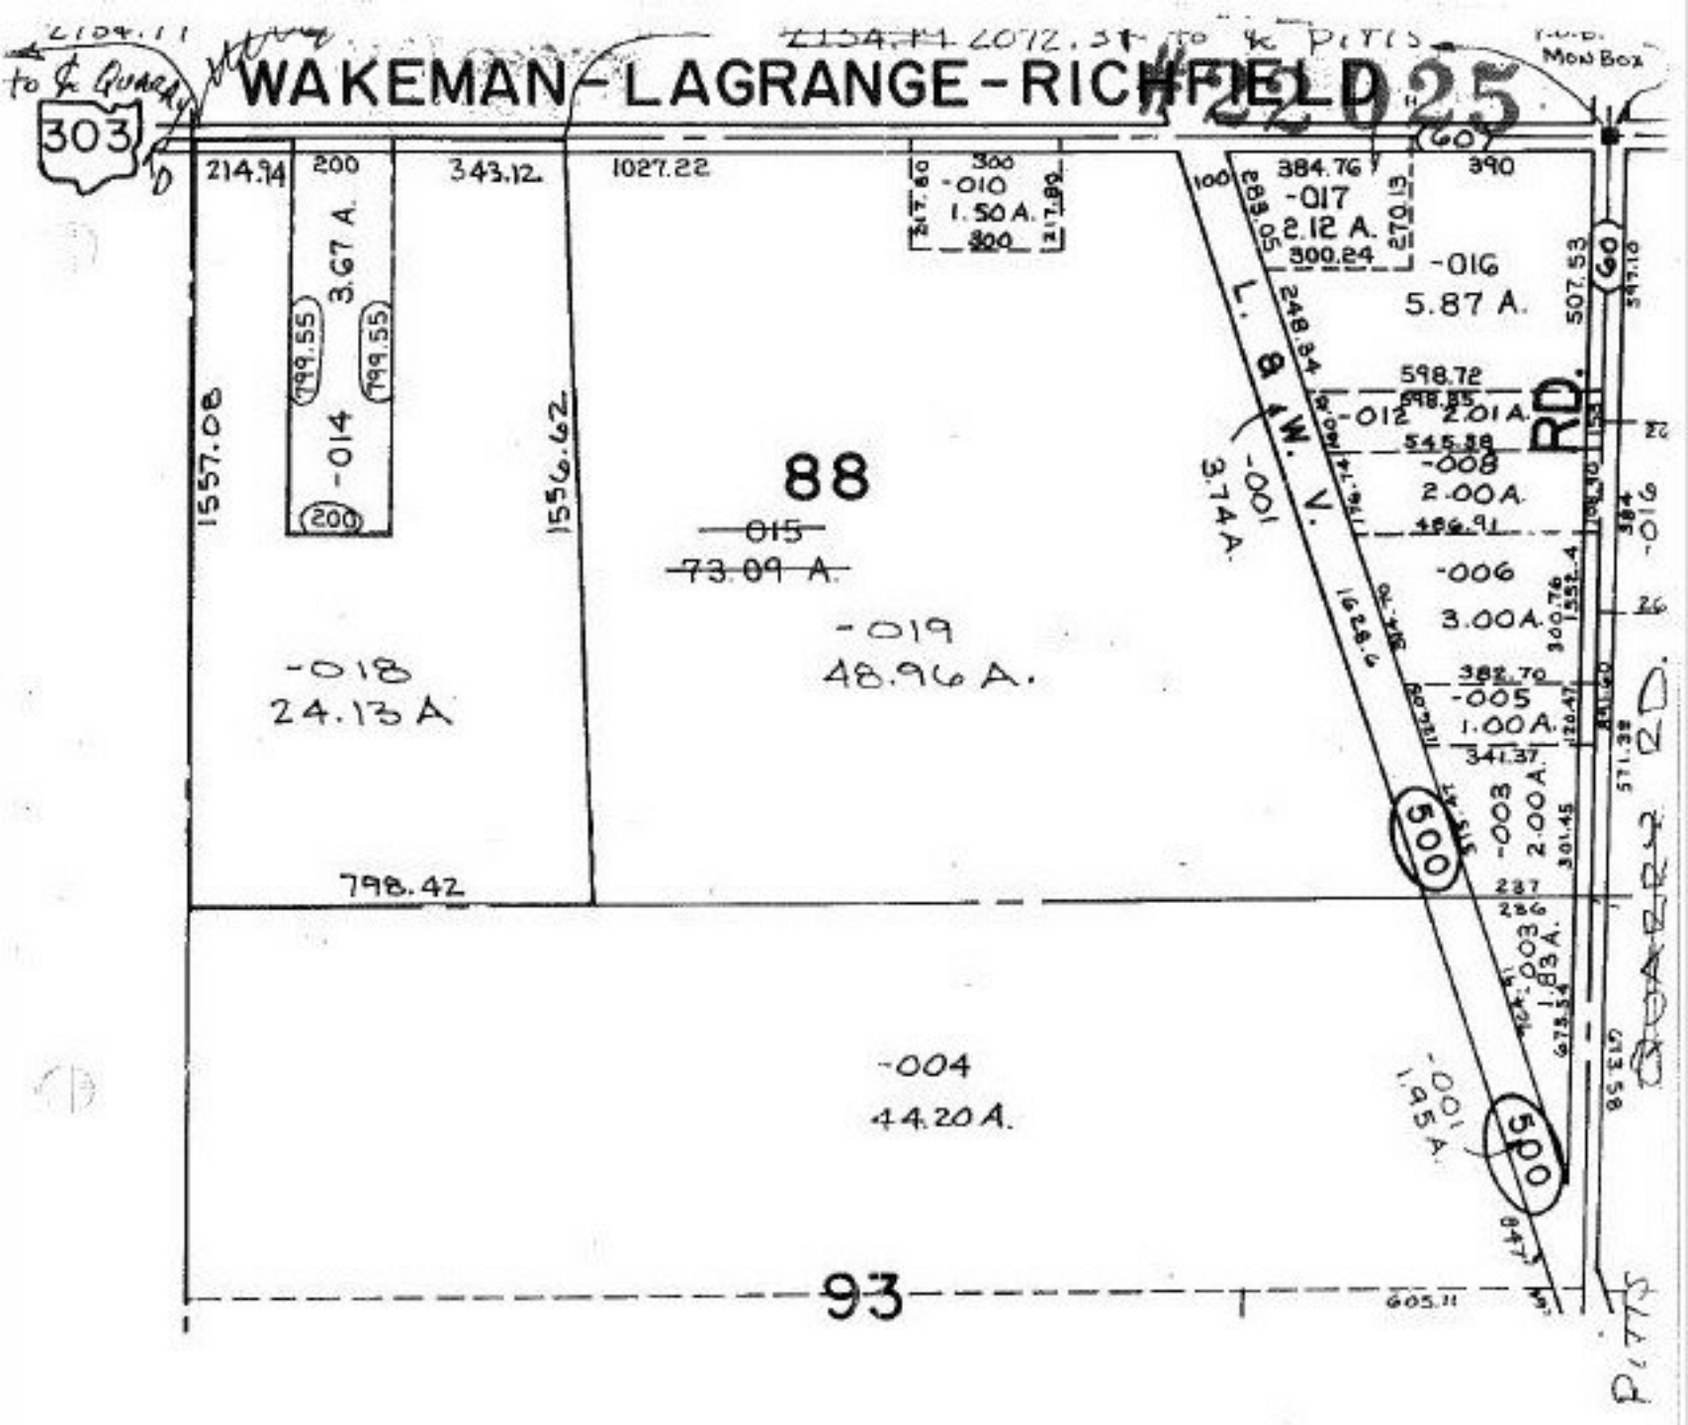

22025

APPROVED
LORAIN CO.
MAP DEPT.

DATE 12-30-96

PAGE 1-B

BY R. BELL

VOID AFTER # 22025